

Your Ref: Proclaim No: SDW3682/24

Our Ref: WYP13902/22

Enquiries: Rabin Khad Thakuri
Tel: (03) 8754 4999

02 September 2025

Spiire Australia Pty Ltd
L 6 414 La Trobe St
MELBOURNE VIC 3000

Dear Rafe Wilson

RE: HARLOW STAGE 7 - AMENDMENTS TO CONSTRUCTION PLAN APPROVAL

Please be advised that the amended construction plans submitted to Council for Harlow Stage 7 are approved.

- **Road name changed from “Bournside St” to “Turmeric St”.**
- **Minor Pits amended for 10,59,69 & 72.**
- **Ramp for Raised Pavement change to 1.2m.**

A copy of the following approved plans have been enclosed for your information.

- Drawing No. 309443CR100 Revision 3
- Drawing No. 309443CR200 Revision 1
- Drawing No. 309443CR201 Revision 1
- Drawing No. 309443CR300 Revision 1
- Drawing No. 309443CR301 Revision 1
- Drawing No. 309443CR400 Revision 1
- Drawing No. 309443CR500 Revision 1
- Drawing No. 309443CR600 Revision 1
- Drawing No. 309443CR601 Revision 1
- Drawing No. 309443CR602 Revision 1
- Drawing No. 309443CR603 Revision 2
- Drawing No. 309443CR700 Revision 2
- Drawing No. 309443CR701 Revision 2

- Drawing No. 309443CR702 Revision 1
- Drawing No. 309443CR800 Revision 1

Yours sincerely,

A handwritten signature in black ink, appearing to read 'Abul Hossen', with a horizontal line extending to the right from the end of the signature.

ABUL HOSEN
SUBDIVISIONS CO-ORDINATOR





Civic Centre
Postal

45 Princes Highway, Werribee, Victoria 3030, Australia
PO Box 197, Werribee, Victoria 3030, Australia

Telephone
Facsimile
Email

(03) 9742 0777
(03) 9741 6237
mail@wyndham.vic.gov.au
www.wyndham.vic.gov.au

DX 30258 Werribee Vic
ABN: 38 393 903 860

Your Ref:

Our Ref: SDW3682/24
WYP13902/22

Enquiries: Rabin Khad Thakuri
Tel: (03) 8754 4999

23 July 2025

Spiire Australia Pty Ltd
L 6 414 La Trobe St
MELBOURNE VIC 3000

Dear Rafe Wilson

RE: HARLOW STAGE 7 - CONSTRUCTION PLAN APPROVAL

Please be advised that the road and drainage construction plans submitted to Council for Harlow Stage 7 are approved subject to the following conditions:-

1. Prior to the placement of concrete kerb and channel, all constructed drainage lines, including easement drains and AG drains, must undergo inspection by an independent testing organisation using closed circuit television (CCTV). Report must be provided to Council as per Wyndham City Council's Technical Specification Section 701 – Underground Stormwater Drains.
2. **Prior to commencement of works, an on-site pre-commencement meeting must be held between Council, the Engineering Consultant and the Contractor. Please contact Robert Troiano from Council on 407802834 to book a precommencement meeting.**
3. **Prior to installation of any Tactile Ground Surface Indicators, the proposed product must be inspected and approved by Council. Please notify Councils construction supervisor to book an inspection prior to installation.**
4. **Prior to commencement of works, the Plan of Subdivision must be certified by Council.**
5. **Prior to commencement of approved works within ANY existing road reserves, the consultant/contractor MUST apply for consent to work within the road reserves from Council or any other relevant responsible authorities. The Contractor will be responsible for maintain all existing assets within the limit of works as demonstrated on the approved plans.**
6. **A free-flowing drainage outlet must be established and maintained throughout the entirety of construction works. No road boxing works are to commence in the absence of a free-flowing drainage outlet.**
7. Prior to commencement of works, the consultant/contractor shall provide to Council the following information:-
 - source of quarry material; and
 - optimum moisture content and maximum modified dry density of the F.C.R to be used (from N.A.T.A. approved laboratory).

If the source of the quarry material is changed during the course of the works, new test results shall be provided.

8. Please provide a Site Environment Management Plan (SEMP) to Council for approval. To submit a SEMP, complete Wyndham Council's online form after following the instructions on the website.
9. Construction is to commence within twelve (12) months of approval, otherwise construction plans and specifications are to comply with design standards current at the time of re-submission.
10. Filled allotments shall be compacted in 150mm maximum layers, with compaction tests being taken at not more than 300mm lift on all allotments and filled areas. The test results and location of the tests on each allotment shall be forwarded to Council.
11. Wyndham City Council Specifications and standard details shall be read in conjunction with the approved plans.
12. Prior to Council issuing a Statement of Compliance, pursuant to the Subdivision Act 1988, your firm shall provide to Council the following:
 - Payment of construction supervision fees amounting to 2.5% of the total cost of road and drainage works;
 - Payment of a maintenance bond amounting to 5% of the total cost of road and drainage works;
 - An electronic copy of all as constructed drawings and relevant files in both AutoCad DWG and Adobe PDF file formats, to either subdiveng@wyndham.vic.gov.au or via Objective Connect. Please note that the minimum resolution of PDF files required is 300dpi;
 - An electronic copy of drainage catchment plans and detailed computations in Adobe PDF file format to either subdiveng@wyndham.vic.gov.au or via Objective Connect;
 - As constructed asset information for drainage and related assets in digital format in accordance with "D-Spec" to either subdiveng@wyndham.vic.gov.au or via Objective Connect; and
 - As-constructed asset information for assets within the road reserve in digital format in accordance with "R-Spec" to either subdiveng@wyndham.vic.gov.au or via Objective Connect; and
 - The A.H.D levels and M.G.A co-ordinates of the high stability P.S.Ms.
 - For further information please see: <https://www.wyndham.vic.gov.au/subdivisionguidelines>
13. Easements are to be created to cover all services which cross any part of private allotments.
14. During construction of works under this permit, access to and egress from the subject land must be via a route designed and approved by the Council. Where practical this access should be remote from established residential areas.
15. Provide Landscaping Plan for approval by Council. Please contact subdivlud@wyndham.vic.gov.au to arrange a pre-application meeting prior to the submission of landscape plans for municipal reserves and/or public open space.
16. WorkSafe Victoria is to be advised via E-mail (construction@workcover.vic.gov.au) of these Subdivisional works with the following details:
 - Name of the principal contractor
 - Name and phone contact of relevant Engineering Consultants supervisor dealing with the works
 - Brief description of the works
 - Locality/address of the works
 - Estimated commencement date of the works, and
 - Expected completion date of the works.

17. In undertaking the construction works, the developer shall ensure all works are undertaken in accordance with the OH & S Act, Regulation and Codes, and shall maintain a safe workplace for Council's staff undertaking inspections. The supervision of works by Council staff only extends to the quality of Council's future infrastructure and does not include ensuring that the works are undertaken safely.

Please find a set of stamped approved plans attached.

Yours sincerely,

Nayana Prabhakar

Nayana Prabhakar
Team Leader Development Engineer

Encl: (1) Stamped approved plans

HARLOW ESTATE STAGE 7 SIG GROUP

WYNDHAM CITY COUNCIL GENERAL NOTES:

SURVEY

- ALL LEVELS ARE TO AUSTRALIAN HEIGHT DATUM AND ALL COORDINATES ARE TO MAP GRID OF AUSTRALIA (MGA) 94, ZONE 55.
- ALL EXISTING SURFACE LEVELS SHOWN ON THE ENGINEERING DRAWINGS HAVE BEEN INTERPOLATED FROM A DIGITAL TERRAIN MODEL. THESE LEVELS HAVE BEEN USED AS THE BASIS FOR ALL ENGINEERING DESIGN AND DETERMINATION OF QUANTITIES AND ARE ACCURATE TO WITHIN ±0.05m.
- ALL WORKS TO BE CARRIED OUT IN ACCORDANCE WITH AS2124-1992 GENERAL CONDITIONS OF CONTRACT, THE ROAD & DRAINAGE SPECIFICATION, APPROVED MUNICIPALITY SPECIFICATIONS AND STANDARD DRAWINGS AND TO THE SATISFACTION OF THE SUPERINTENDENT AND THE MUNICIPAL ENGINEER OR THEIR REPRESENTATIVE.
- ROAD CHAINAGES REFER TO ROAD CENTRELINES. CHAINAGES FOR INTERSECTIONS AND CUL-DE-SACS REFER TO THE LIP OF KERB.

EARTHWORKS

- THE LOCATION OF EXISTING SERVICES SHOULD BE DETERMINED BY THE CONTRACTOR PRIOR TO COMMENCING ANY EXCAVATION BY CONTACTING ALL LOCAL SERVICE AUTHORITIES. ANY EXISTING SERVICES SHOWN ON THESE DRAWINGS ARE OFFERED AS A GUIDE ONLY AND ARE NOT GUARANTEED AS CORRECT.
- WHERE REQUIRED ANY BUILDINGS, TROUGHS, FENCES AND OTHER STRUCTURES ON SITE ARE TO BE REMOVED AS DIRECTED BY THE ENGINEER. THE COST OF REMOVAL IS TO BE INCLUDED IN THE OVERALL EARTHWORKS FIGURE UNLESS A SPECIFIC ITEM FOR REMOVAL IS DENOTED IN THE SCHEDULE.
- ALL EXCAVATED ROCK AND SURPLUS SPOIL TO BE REMOVED AND DISPOSED OFF SITE UNLESS NOTED OTHERWISE.
- ALL FILLING ON LOTS AND WITHIN ROAD RESERVES GREATER THAN 200mm IS TO BE UNDERTAKEN USING LEVEL 1 SUPERVISION AND BE COMPLETED IN ACCORDANCE WITH AS 3798-2007. FILL AREAS ARE TO BE STRIPPED OF TOPSOIL, FILLED AND REPLACED WITH TOPSOIL (WHERE REQUIRED) TO OBTAIN THE FINAL LEVELS SHOWN ON THE DRAWINGS.
- FILLING MATERIAL IS TO BE IN ACCORDANCE WITH THE SPECIFICATION, AS 3798-2007 & TO THE SATISFACTION OF COUNCIL AND THE SUPERINTENDENT.
- ALL BATTERS SHALL BE 1 IN 6, UNLESS OTHERWISE SHOWN.
- NO FILL OR STOCKPILING OF MATERIAL IS TO BE PLACED ON ANY RESERVE FOR PUBLIC OPEN SPACE UNLESS OTHERWISE DIRECTED OR APPROVED BY THE SUPERINTENDENT.
- TBM'S TO BE RE-ESTABLISHED BY THE LICENSED SURVEYOR IF FOUND TO BE MISSING AT THE COMMENCEMENT OF CONSTRUCTION. THE CONTRACTOR WILL BE RESPONSIBLE FOR CARE AND MAINTENANCE OF T.B.M.'S THEREAFTER.
- AT LEAST 3 DAYS PRIOR TO COMMENCING WORK ON EXCAVATIONS IN EXCESS OF 150mm DEEP, A NOTIFICATION FORM MUST BE SENT TO WORKSAFE. THE CONTRACTOR IS TO COMPLY WITH WORKSAFE, THE MINES (TRENCHES) REGULATION 1982, THE MINES ACT 1958 AND OCCUPATIONAL HEALTH AND SAFETY ACT 1985, 2004.
- ALL SERVICE TRENCHES UNDER DRIVEWAYS, FOOTPATHS AND PARKING BAYS TO BE BACKFILLED WITH CLASS 2 CRUSHED ROCK. SERVICE TRENCHES LESS THAN 750mm BEHIND KERB AND CHANNEL OR PAVED TRAFFIC AREAS ARE ALSO TO BE BACKFILLED WITH COMPACTED CLASS 2 CRUSHED ROCK.
- WHERE REQUIRED, ALL EXISTING DAMS, DEPRESSIONS AND DRAINS ARE TO BE BREACHED, DRAINED, DESLUDGED AND SHALL BE EXCAVATED TO A CLEAN FIRM BASE. THE SURFACE SHALL BE INSPECTED, APPROVED AND LEVELED BY THE ENGINEER PRIOR TO COMMENCEMENT OF FILLING. THE FILL SHALL BE APPROVED SELECTED ON SITE MATERIAL OR APPROVED IMPORTED MATERIAL. THE FILL SHALL BE PLACED UNDER CONTROLLED MOISTURE CONDITIONS IN ACCORDANCE WITH THE SPECIFICATION.

SERVICES

- GAS AND WATER CONDUITS ARE TO BE,
 - Ø50mm . CLASS 12 P.V.C. - SINGLE SERVICE
 - Ø100mm . CLASS 12 P.V.C. - DUAL SERVICE (DRINKING AND NON DRINKING WATER)
 WITH THE FOLLOWING MINIMUM COVER TO FINISHED SURFACE LEVELS:
 - ROAD PAVEMENT - 0.80m
 - VERGE, FOOTPATHS - 0.45m
- ALL SERVICE CONDUIT TRENCHES UNDER ROAD PAVEMENTS TO BE BACKFILLED IN ACCORDANCE WITH RELEVANT MUNICIPALITY OR ROAD AUTHORITY SPECIFICATION.
- GAS AND WATER CONDUITS TO BE LOCATED AS SHOW, REFER TO WATER DESIGN FOR CONDUIT OFFSETS
- TELSTRA ARE TO BE NOTIFIED 7 DAYS PRIOR TO PLACEMENT OF CONCRETE WORKS.

STORM WATER DRAINAGE

- AG/SUBSOIL DRAIN TO BE LAID BEHIND KERB WHERE REQUIRED IN ACCORDANCE WITH THE COUNCIL STANDARD DRAWINGS AND CONNECTED TO UNDERGROUND DRAINAGE.
- ALL STORMWATER DRAINS ARE TO BE CLASS '2' R.C. PIPES UNLESS OTHERWISE SHOWN.

ALL PIPES UP TO AND INCLUDING 750mm DIAMETER TO BE RUBBER RING JOINTED (R.R.J.) UNLESS STATED OTHERWISE.

- CENTRELINES OF ALL EASEMENT DRAINS ARE OFFSET 1.0m OR 2.2m (WHERE OUTSIDE OF SEWER) FROM THE PROPERTY LINE UNLESS SHOWN OTHERWISE.
- WHERE CURVED PIPES ARE SHOWN ON THE FACE PLANS THEY ARE TO BE LAID PARALLEL TO THE BACK OF KERB, EXCEPT WHERE A RADIUS HAS BEEN SPECIFICALLY NOMINATED. CURVED PIPES ARE TO BE APPROVED BY COUNCIL AND IN ACCORDANCE WITH THE MANUFACTURERS SPECIFICATIONS.
- HOUSE DRAINS NOT OUT OF PIT TO BE OFFSET IN ACCORDANCE WITH COUNCIL STANDARDS UNLESS NOTED OTHERWISE.
- AFTER THE COMPLETION OF THE LOWER SUB BASE PAVEMENT LAYERS AND/OR CAPPING LAYER AND PRIOR TO THE PLACEMENT OF CONCRETE KERB AND CHANNEL, ALL DRAINAGE LINES INCLUDING EASEMENT DRAINS CONSTRUCTED MUST BE INSPECTED BY AN INDEPENDENT TESTING ORGANISATION USING CCTV AND RELEVANT WORKS MUST BE PROVIDED TO THE SATISFACTION OF COUNCIL.

PAVEMENT

- PAVEMENT DEPTHS MAY BE MODIFIED AS DIRECTED BY THE SUPERINTENDENT. PAVEMENT TO BE BOXED OUT TO MINIMUM DEPTH DENOTED, INSPECTED AND IF SUBGRADE IS IN QUESTION, FURTHER TESTING CARRIED OUT TO DETERMINE FINAL PAVEMENT DEPTH.
- WHERE PAVEMENT IS CONSTRUCTED ON FILLING, FILL MATERIAL IS TO BE APPROVED BY THE SUPERINTENDENT AND COUNCIL. FILLING TO BE CONSTRUCTED IN LAYERS 150mm THICK WITH COMPACTION ACHIEVING 95% AUSTRALIAN STANDARD DENSITY.
- WHEN PAVEMENT EXCAVATION IS IN ROCK ALL LOOSE MATERIAL (INCLUDING ROCKS AND CLAY) MUST BE REMOVED. THE SUB-GRADE MUST THEN BE REGULATED WITH COUNCIL APPROVED MATERIAL.

SIGNAGE AND LINEMARKING

- LINEMARKING AND SIGNAGE TO BE INSTALLED IN ACCORDANCE WITH AS 1742 SERIES UNLESS NOTED OTHERWISE. STREET SIGNS ARE TO BE INSTALLED IN ACCORDANCE WITH COUNCIL STANDARDS.
- ALL TEMPORARY WARNING SIGNS USED DURING CONSTRUCTION SHALL BE SUPPLIED AND MAINTAINED IN ACCORDANCE WITH AS 1742-3.
- TACTILE GROUND SURFACE INDICATORS ARE TO BE INSTALLED IN ACCORDANCE WITH THE DISABILITY DISCRIMINATION ACT AND RELEVANT COUNCIL STANDARD DRAWINGS.

ENVIRONMENTAL

- CONTRACTOR TO PROVIDE AN ENVIRONMENTAL MANAGEMENT PLAN INCLUDING SILT AND SEDIMENT RUNOFF PROTECTION ETC. PRIOR TO THE COMMENCEMENT OF WORKS.
- ALL TREES AND SHRUBS ARE TO BE RETAINED UNLESS OTHERWISE SHOWN. IF ROAD AND DRAINAGE CONSTRUCTION NECESSITATES THEIR REMOVAL, WRITTEN PERMISSION MUST BE OBTAINED FROM THE SUPERINTENDENT.
- TREES NOT SPECIFIED FOR REMOVAL ARE TO BE PROTECTED WITH APPROPRIATE EXCLUSION FENCING PRIOR TO COMMENCEMENT OF ANY WORKS.
- THE CONTRACTOR IS REQUIRED TO OBTAIN A 'PERMIT TO WORK' FROM MELBOURNE WATER'S SURVEILLANCE OFFICER AT THE PRE-COMMENCEMENT MEETING. THE CONTRACTOR IS REQUIRED TO ENSURE THAT THE 'PERMIT TO WORK' IS KEPT UP TO DATE FOR THE DURATION OF THE CONTRACT.



LOCALITY PLAN

H 14 000
SCALE @ A1

DRAWING SCHEDULE

DRAWING	DESCRIPTION	SHEET No.	REVISION
CR100	FACE SHEET	1	3
CR200	FACE PLAN	2	1
CR201	SERVICES PLAN	3	1
CR300	ROAD LONG SECTIONS - SHEET 1	4	1
CR301	ROAD LONG SECTIONS - SHEET 2	5	1
CR302	ROAD LONG SECTIONS - SHEET 3	6	0
CR400	ROAD CROSS SECTIONS - SHEET 1	7	1
CR401	ROAD CROSS SECTIONS - SHEET 2	8	0
CR402	ROAD CROSS SECTIONS - SHEET 3	9	0
CR403	ROAD CROSS SECTIONS - SHEET 4	10	0
CR404	ROAD CROSS SECTIONS - SHEET 5	11	0
CR405	ROAD CROSS SECTIONS - SHEET 6	12	0
CR500	INTERSECTION DETAILS - SHEET 1	13	1
CR501	INTERSECTION DETAILS - SHEET 2	14	0
CR600	DRAINAGE LONG SECTIONS - SHEET 1	15	1
CR601	DRAINAGE LONG SECTIONS - SHEET 2	16	1
CR602	DRAINAGE LONG SECTIONS - SHEET 3	17	1
CR603	DRAINAGE PIT SCHEDULE	18	2
CR700	PAVEMENT AND TYPICAL DETAILS	19	2
CR701	RAISED PAVEMENT DETAILS - SHEET 1	20	2
CR702	RAISED PAVEMENT DETAILS - SHEET 2	21	1
CR800	SIGNAGE AND LINEMARKING	22	1



LEGEND

DESCRIPTION	EXISTING	PROPOSED
WATER MAIN, VALVE AND HYDRANT	--- DW ---	--- DW ---
WATER RECYCLED	--- NDW ---	--- NDW ---
UNDERGROUND ELECTRICITY	--- E ---	--- E ---
OPTIC FIBRE	--- OF ---	--- OF ---
GAS MAIN	--- G ---	--- G ---
SEWER & MAINTENANCE STRUCTURE	--- S ---	--- S ---
CENTRAL INVERT	--- > ---	--- > ---
COUNCIL STORMWATER DRAIN AND PIT	--- S ---	--- S ---
STORM WATER DRAINAGE PROPERTY INLETS	--- S ---	--- S ---
HOUSE DRAIN	--- H ---	--- H ---
AG DRAIN AND FLUSHER	--- AG ---	--- AG ---
STORM WATER DRAINAGE PIT NUMBER	①	①
GAS & WATER CONDUITS	--- GW ---	--- GW ---
CONCRETE VEHICLE CROSSING	--- X ---	--- X ---
RIDGE / CHANGE OF GRADE LINE	--- 169.00 ---	--- 169.00 ---
SURFACE CONTOUR MINOR	--- 168.90 ---	--- 168.90 ---
SURFACE CONTOUR MAJOR	--- 168.90 ---	--- 168.90 ---
SURFACE LEVEL	E123.45	F124.68
BATTER LEVEL (TOP / TOE)	T124.80	T124.80
EARTHWORKS GRADE	--- 1 in 150 ---	--- 1 in 150 ---
SIGN AND POST	--- S ---	--- S ---
LIGHT & POLE (BY OTHERS)	--- L ---	--- L ---
STREET SIGN	--- S ---	--- S ---
PERMANENT SURVEY MARK	--- S ---	--- S ---
TEMPORARY BENCH MARK	--- S ---	--- S ---
BOLLARD	--- B ---	--- B ---
ROAD CHAINAGES	CH116.57 (L/R)TP CH116.57	CH116.57 (L/R)TP CH116.57
LOT CHAINAGES	CH20.06	CH20.06
SETOUT POINT	--- S ---	--- S ---
LIMIT OF WORKS	--- L ---	--- L ---
BATTER	--- B ---	--- B ---
EXCAVATION GREATER THAN 0.20m	--- E ---	--- E ---
FILLING GREATER THAN 0.20m	--- F ---	--- F ---
FENCES	--- F ---	--- F ---
PROPOSED TREE	--- T ---	--- T ---
FOOTPATH	--- F ---	--- F ---
TACTILE GROUND SURFACE INDICATOR	--- T ---	--- T ---
KERB TRANSITION	B2 SM2	B2 SM2

Planning and Environment Act 1987
Wyndham Planning Scheme

Approved Plan As Required
under Condition 63
Permit No WYP13902/22
Date 02/09/2025



WARNING
BEWARE OF UNDERGROUND/OVERHEAD SERVICES
THE LOCATION OF SERVICES ARE APPROXIMATE ONLY AND THEIR EXACT POSITION SHOULD BE PROVEN ON SITE. NO GUARANTEE IS GIVEN THAT ALL EXISTING SERVICES ARE SHOWN. SPECIAL CONSIDERATION SHOULD BE GIVEN TO CONSTRUCTION PROCEDURES UNDER OVERHEAD ELECTRICITY TRANSMISSION LINES.

file name: 309443CR100.dwg, layout name: CR100, created by: Thanh Nguyen, file location: \\spiremedia\spire\media\309443\309443.dwg, date: 28/08/2025 5:41 PM, sheet: 1 of 22, sheets

Rev	Amendments	Approved	Date
3	PAVEMENT PROFILE & RAISED PAVEMENT DETAILS AMENDED	G.K	28/08/25
2	DRAINAGE PIT SCHEDULE AND ROAD NAME AMENDED	G.K	21/08/25
1	DRAINAGE AMENDMENTS	G.K	05/08/25
0	ISSUED FOR CONSTRUCTION	G.K	29/07/25
B	AMENDED AS PER COUNCIL COMMENTS	G.K	30/05/25
A	ISSUED TO COUNCIL	G.K	04/04/25

System Certified

 © Spiire Australia Pty Ltd All Rights Reserved

This document is produced by Spiire Australia Pty Ltd solely for the benefit of and use by the client in accordance with the terms of the retainer. Spiire Australia Pty Ltd does not and shall not assume any responsibility or liability whatsoever to any third party arising out of any use or reliance by third party on the content of this document.



L6 414 LA TROBE STREET PO BOX 16084 MELBOURNE
VICTORIA 3007 AUSTRALIA T 61 3 9993 7888
spiire.com.au ABN 55 050 029 635




Designed
T. NGUYEN
Authorised
G. KOHLMAN

Checked
G. KOHLMAN
Date
04/04/25

**HARLOW ESTATE
STAGE 7
ROAD AND DRAINAGE
FACE SHEET**
WYNDHAM CITY COUNCIL
SIG GROUP

CONSTRUCTION Drg No **309443CR100** Rev **3**

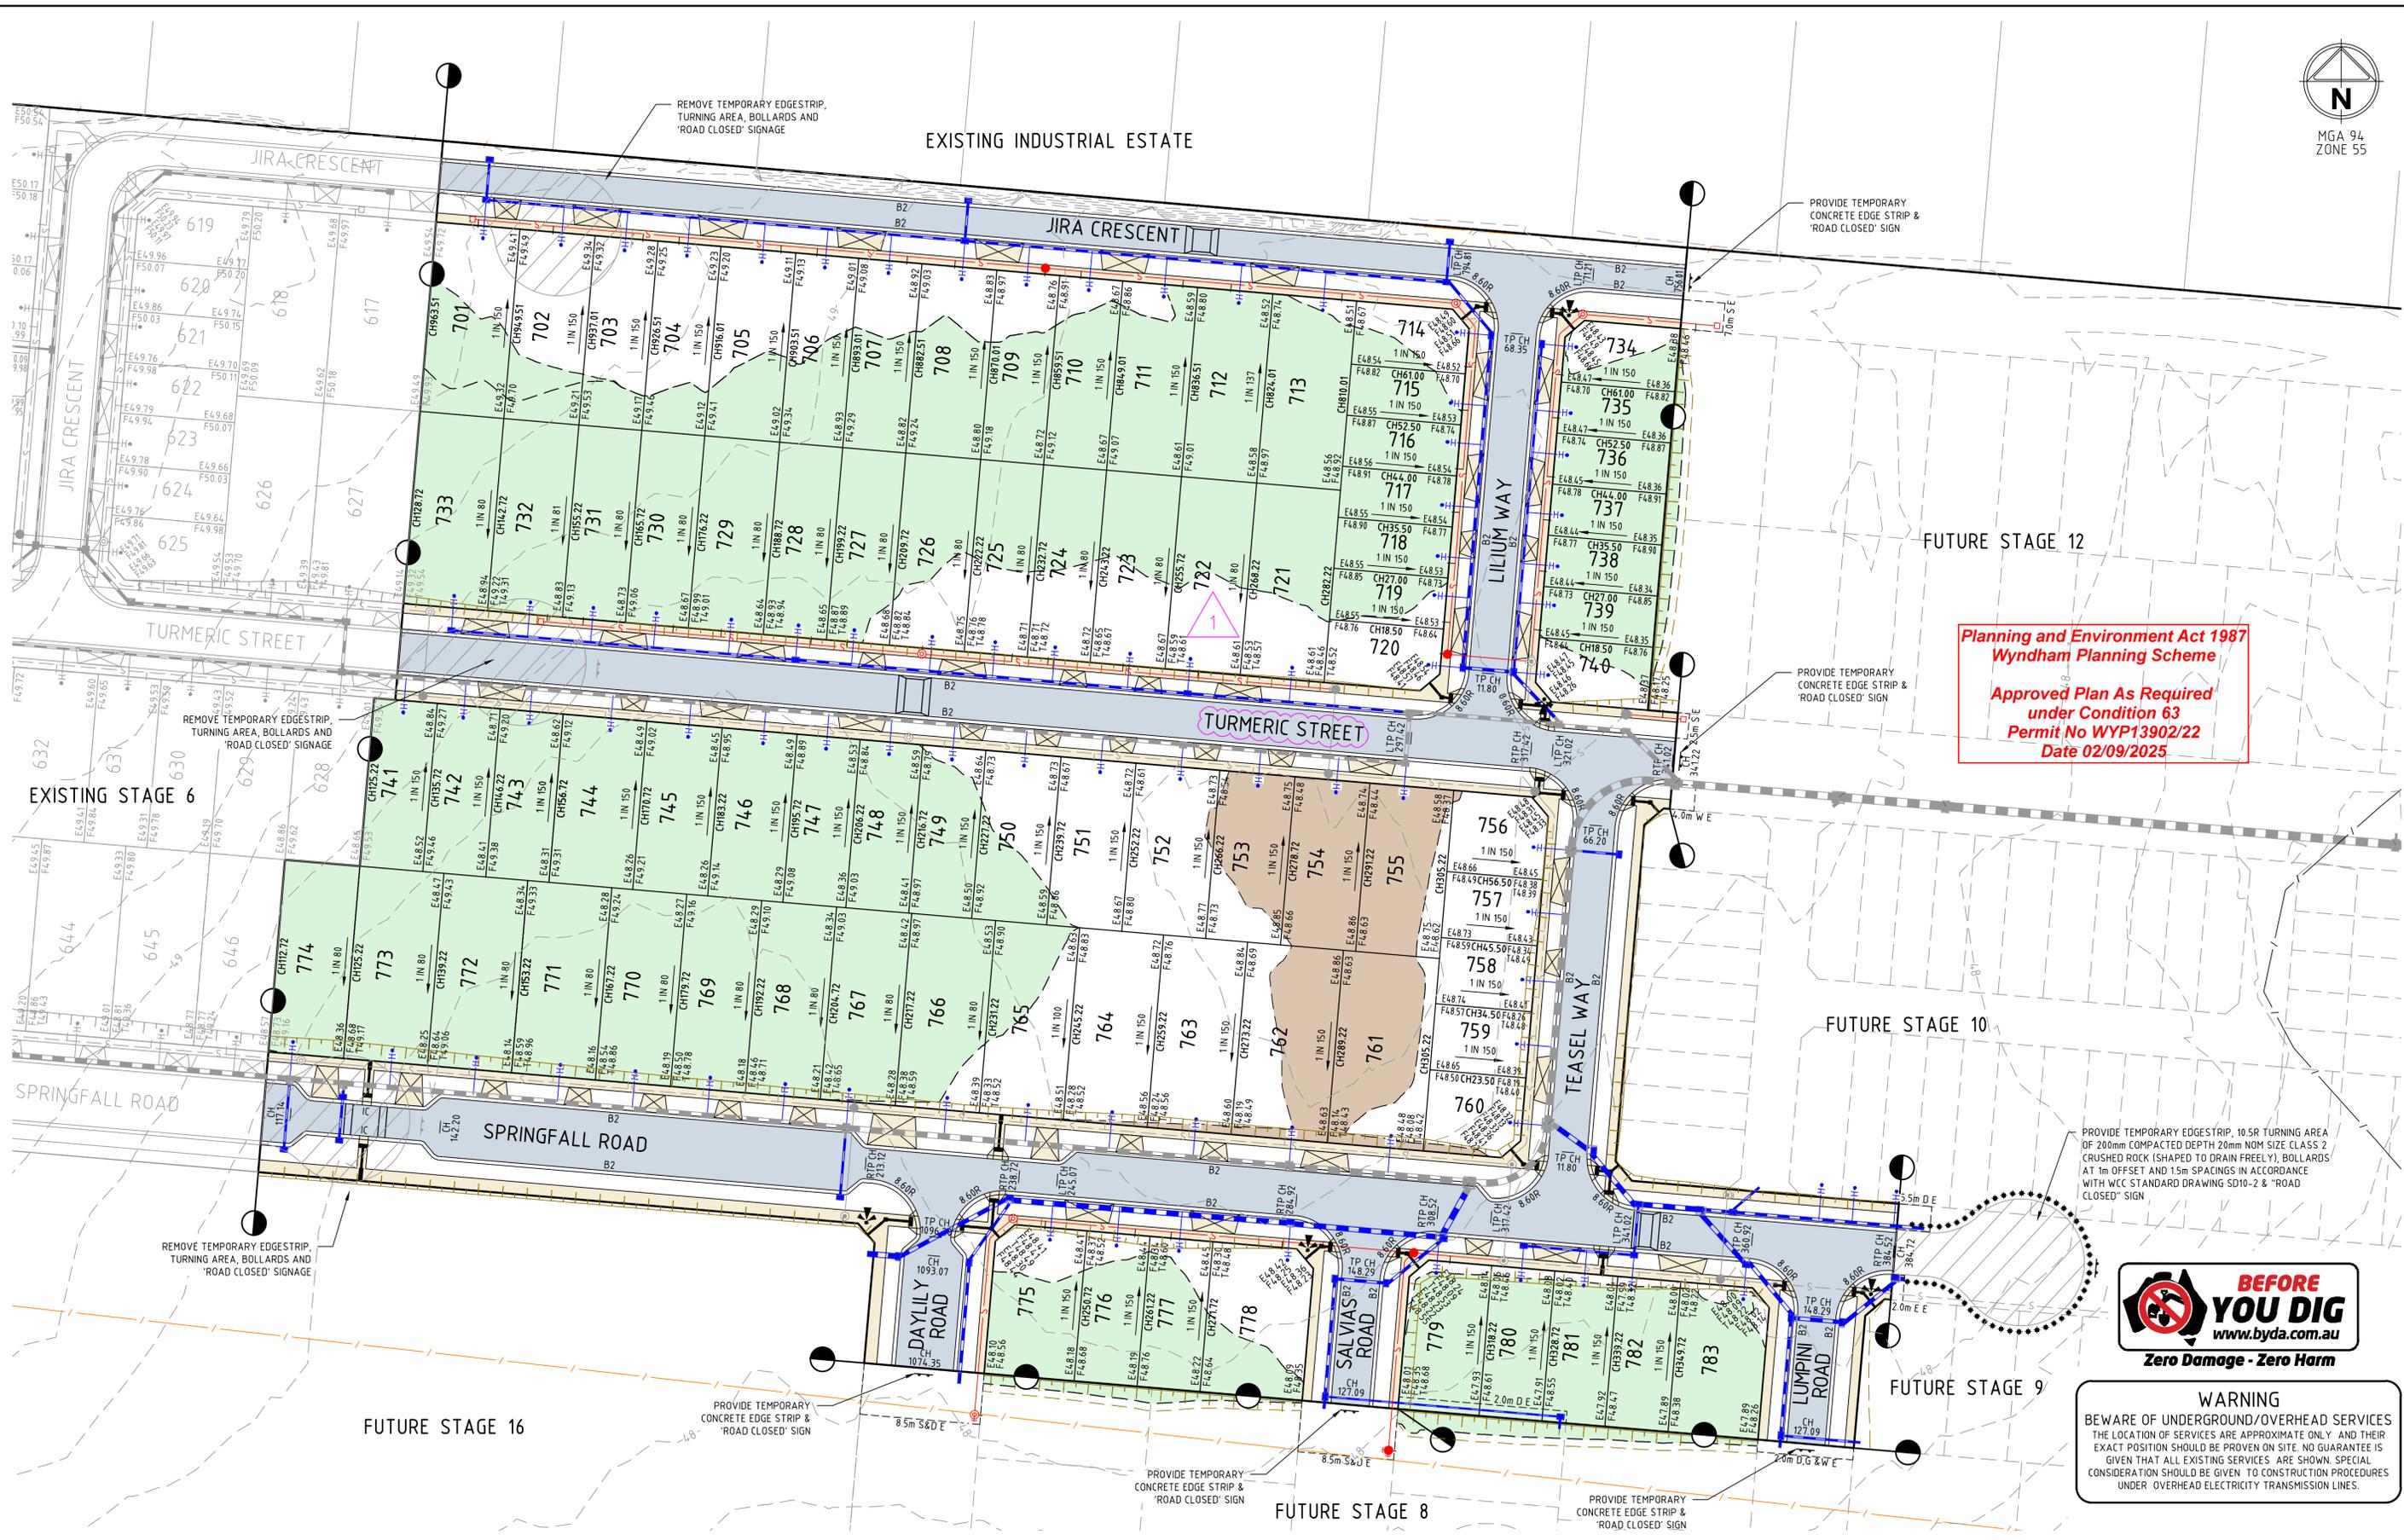

Planning and Environment Act 1987
Wyndham Planning Scheme
Approved Plan As Required
under Condition 63
Permit No WYP1390/22
Date 02/09/2025

PROVIDE TEMPORARY EDGESTRIP, 10.5R TURNING AREA OF 200mm COMPACTED DEPTH 20mm NOM SIZE CLASS 2 CRUSHED ROCK (SHAPED TO DRAIN FREELY), BOLLARDS AT 1m OFFSET AND 1.5m SPACINGS IN ACCORDANCE WITH WCC STANDARD DRAWING SD10-2 & "ROAD CLOSED" SIGN



WARNING
BEWARE OF UNDERGROUND/OVERHEAD SERVICES
THE LOCATION OF SERVICES ARE APPROXIMATE ONLY, AND THEIR EXACT POSITION SHOULD BE PROVEN ON SITE. NO GUARANTEE IS GIVEN THAT ALL EXISTING SERVICES ARE SHOWN. SPECIAL CONSIDERATION SHOULD BE GIVEN TO CONSTRUCTION PROCEDURES UNDER OVERHEAD ELECTRICITY TRANSMISSION LINES.

file name: 309443CR200.dwg, layout name: CR200, plot title: 309443, plot date: 28/08/2025 5:41 PM Sheet: 2 of 22 Sheets
file location: \\spire\media\data\309443\309443.dwg

Rev	Amendments	Approved	Date
1	ROAD NAME AMENDED	G.K	21/08/25
0	ISSUED FOR CONSTRUCTION	G.K	29/07/25
B	PRAM CROSSINGS AMENDED & JIRA CRESCENT BERM REMOVED	G.K	30/05/25
A	ISSUED TO COUNCIL	G.K	04/04/25



System Certified

© Spiire Australia Pty Ltd All Rights Reserved
This document is produced by Spiire Australia Pty Ltd solely for the benefit of and use by the client in accordance with the terms of the retainer. Spiire Australia Pty Ltd does not and shall not assume any responsibility or liability whatsoever to any third party arising out of any use or reliance by third party on the content of this document.




L6 414 LA TROBE STREET PO BOX 16084 MELBOURNE
VICTORIA 8007 AUSTRALIA T 61 3 9993 7888
spiire.com.au ABN 55 050 029 635



Designed
T. NGUYEN
Checked
G. KOHLMAN
Authorised
G. KOHLMAN
Date
04/04/25

**HARLOW ESTATE
STAGE 7
ROAD AND DRAINAGE
FACE PLAN
WYNDHAM CITY COUNCIL
SIG GROUP**

CONSTRUCTION Dwg No 309443CR200 Rev 1

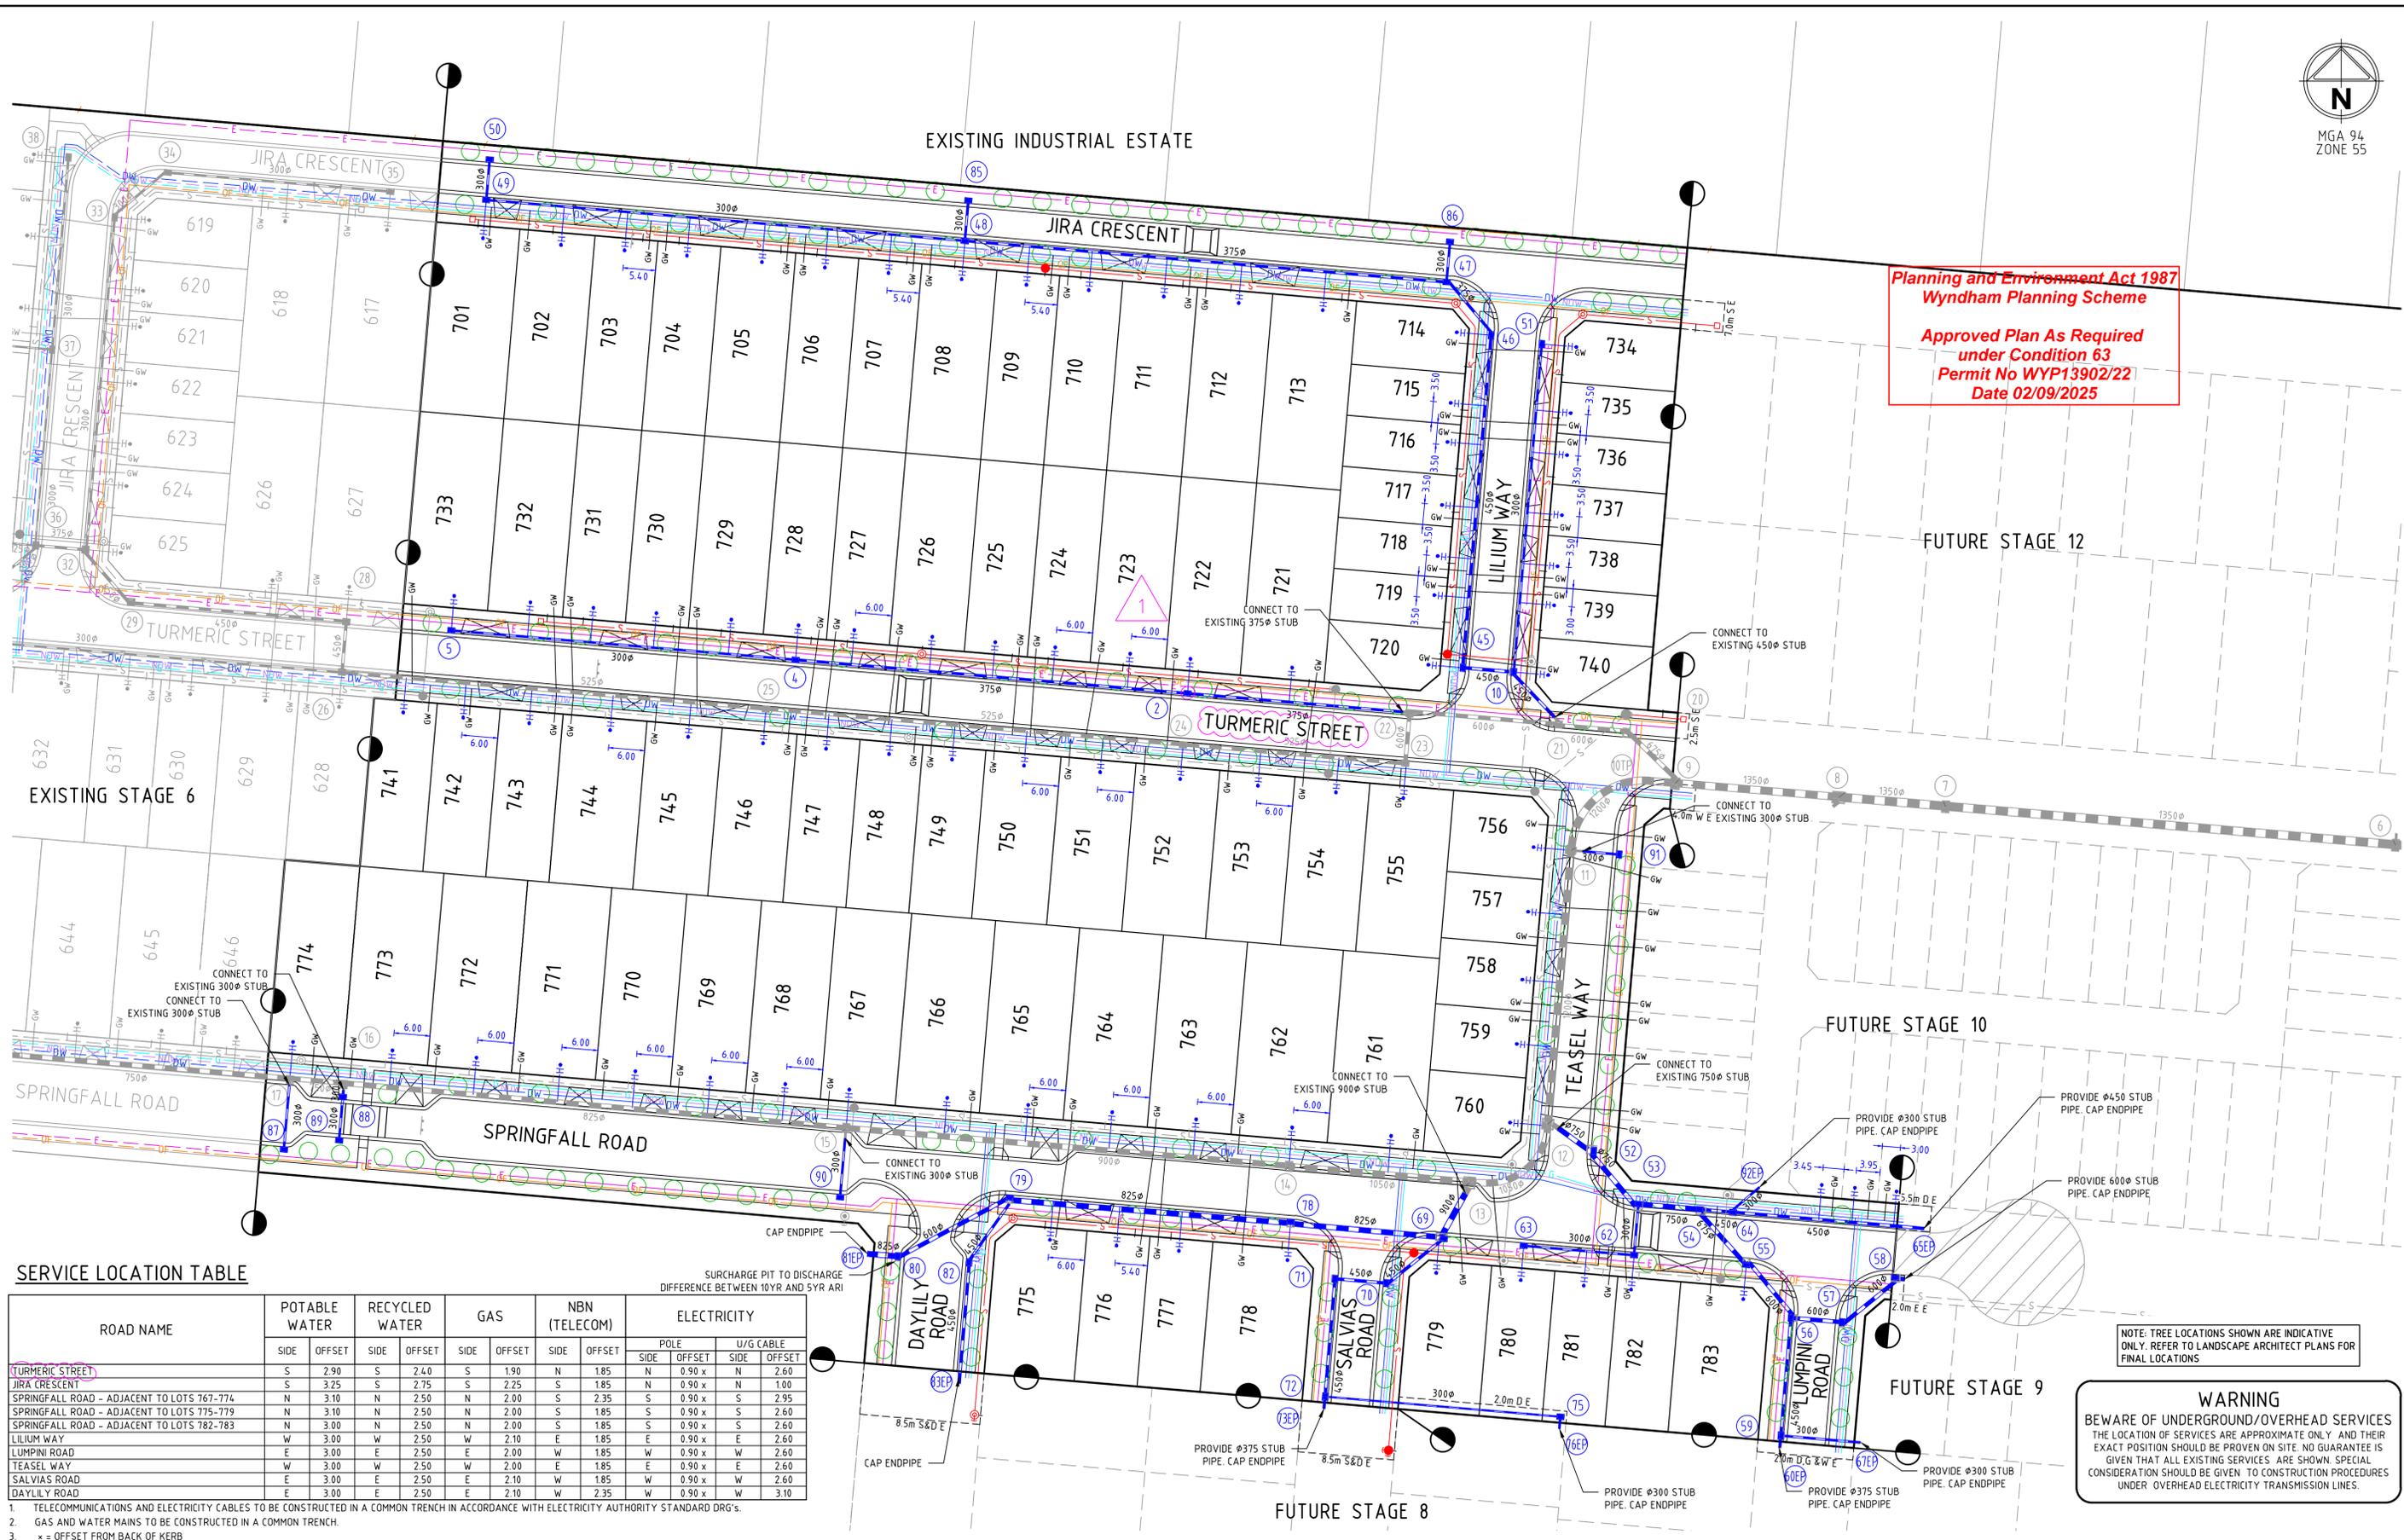

Planning and Environment Act 1987
Wyndham Planning Scheme

Approved Plan As Required
under Condition 63
Permit No WYP13902/22
Date 02/09/2025


SERVICE LOCATION TABLE

ROAD NAME	POTABLE WATER		RECYCLED WATER		GAS		NBN (TELECOM)		ELECTRICITY			
	SIDE	OFFSET	SIDE	OFFSET	SIDE	OFFSET	SIDE	OFFSET	ELECTRICITY			
									POLE	U/G CABLE		
TURMERIC STREET	S	2.90	S	2.40	S	1.90	N	1.85	N	0.90 x	N	2.60
JIRA CRESCENT	S	3.25	S	2.75	S	2.25	S	1.85	N	0.90 x	N	1.00
SPRINGFALL ROAD - ADJACENT TO LOTS 767-774	N	3.10	N	2.50	N	2.00	S	2.35	S	0.90 x	S	2.95
SPRINGFALL ROAD - ADJACENT TO LOTS 775-779	N	3.10	N	2.50	N	2.00	S	1.85	S	0.90 x	S	2.60
SPRINGFALL ROAD - ADJACENT TO LOTS 782-783	N	3.00	N	2.50	N	2.00	S	1.85	S	0.90 x	S	2.60
LILIUM WAY	W	3.00	W	2.50	W	2.10	E	1.85	E	0.90 x	E	2.60
LUMPINI ROAD	E	3.00	E	2.50	E	2.00	W	1.85	W	0.90 x	W	2.60
TEASEL WAY	W	3.00	W	2.50	W	2.00	E	1.85	E	0.90 x	E	2.60
SALVIAS ROAD	E	3.00	E	2.50	E	2.10	W	1.85	W	0.90 x	W	2.60
DAYLILY ROAD	E	3.00	E	2.50	E	2.10	W	2.35	W	0.90 x	W	3.10

1. TELECOMMUNICATIONS AND ELECTRICITY CABLES TO BE CONSTRUCTED IN A COMMON TRENCH IN ACCORDANCE WITH ELECTRICITY AUTHORITY STANDARD DRG'S.
 2. GAS AND WATER MAINS TO BE CONSTRUCTED IN A COMMON TRENCH.
 3. * = OFFSET FROM BACK OF KERB

WARNING
 BEWARE OF UNDERGROUND/OVERHEAD SERVICES
 THE LOCATION OF SERVICES ARE APPROXIMATE ONLY AND THEIR EXACT POSITION SHOULD BE PROVEN ON SITE. NO GUARANTEE IS GIVEN THAT ALL EXISTING SERVICES ARE SHOWN. SPECIAL CONSIDERATION SHOULD BE GIVEN TO CONSTRUCTION PROCEDURES UNDER OVERHEAD ELECTRICITY TRANSMISSION LINES.

Rev	Amendments	Approved	Date
1	ROAD NAME AND PIT 2 SIZE AMENDED	G.K	21/08/25
0	ISSUED FOR CONSTRUCTION	G.K	29/07/25
B	HOUSE DRAINS AMENDED & ADDED	G.K	30/05/25
A	ISSUED TO COUNCIL	G.K	04/04/25

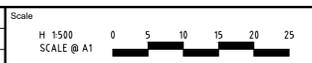

© Spiire Australia Pty Ltd All Rights Reserved
 This document is produced by Spiire Australia Pty Ltd solely for the benefit of and use by the client in accordance with the terms of the retainer. Spiire Australia Pty Ltd does not and shall not assume any responsibility or liability whatsoever to any third party arising out of any use or reliance by third party on the content of this document.



L6 414 LA TROBE STREET PO BOX 16084 MELBOURNE
 VICTORIA 3007 AUSTRALIA T 61 3 9993 7888
 spiire.com.au ABN 55 050 029 635




Designed
T. NGUYEN
 Authorised
G. KOHLMAN
 Checked
G. KOHLMAN
 Date
04/04/25

HARLOW ESTATE
STAGE 7
ROAD AND DRAINAGE
SERVICES PLAN
 WYNDHAM CITY COUNCIL
 SIG GROUP

CONSTRUCTION Drg No **309443CR201** Rev **1**

file name: 309443CR201.dwg, layout: plans_C0201, dtd: 2025-04-04 10:54:11 PM, sheet: 3 of 22, sheets: 22
 file location: \\spiire\media\data\309443\309443.dwg, plot: 02/08/2025 5:41 PM, sheet: 3 of 22, sheets: 22

file name: 309443CR300.dwg; layout name: CR300; plot style: T:\sheet\plots\309443.dwg; plot date: 28/08/2025 5:42 PM; sheet: 4 of 22-Sheets

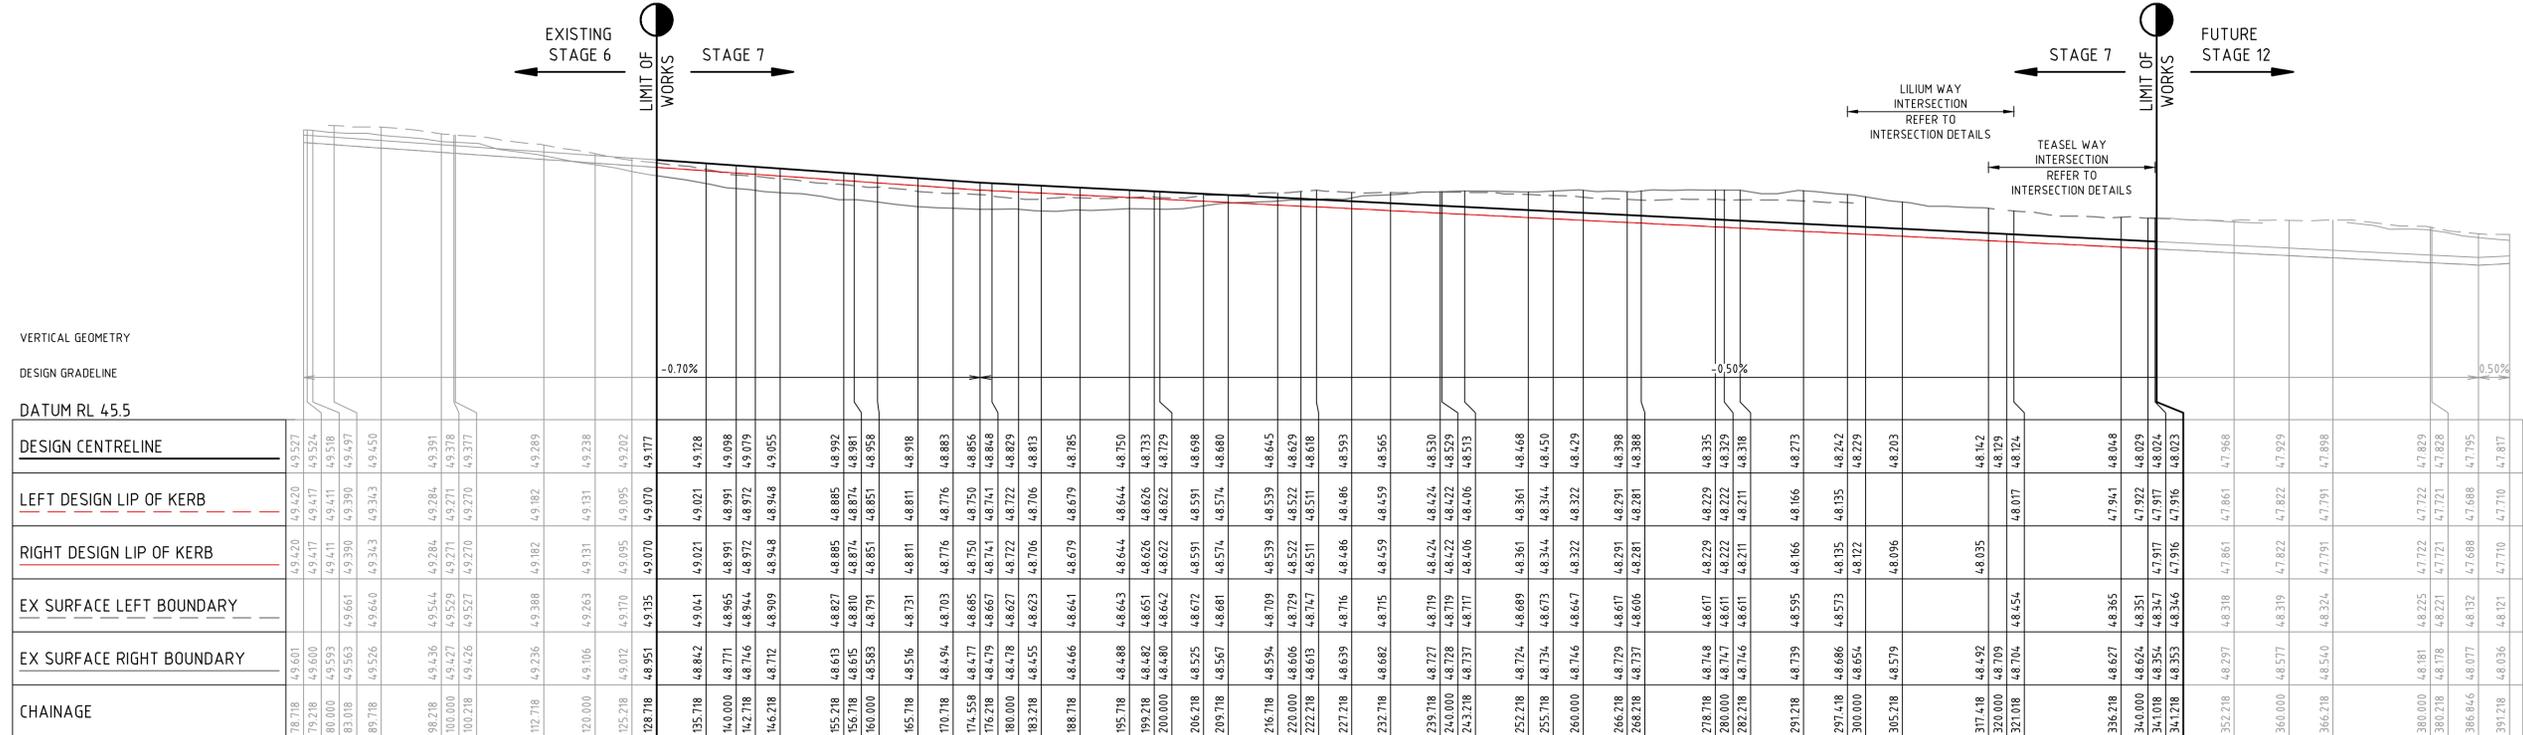


VERTICAL GEOMETRY
DESIGN GRADELINE
DATUM RL 45.5

CHAINAGE	EX SURFACE RIGHT BOUNDARY	EX SURFACE LEFT BOUNDARY	RIGHT DESIGN LIP OF KERB	LEFT DESIGN LIP OF KERB	DESIGN CENTRELINE
78.718	49.601	49.420	49.420	49.420	49.527
79.218	49.600	49.417	49.417	49.417	49.524
80.000	49.593	49.411	49.411	49.411	49.518
81.018	49.563	49.390	49.390	49.390	49.497
89.718	49.526	49.343	49.343	49.343	49.450
98.218	49.436	49.284	49.284	49.284	49.391
100.000	49.427	49.271	49.271	49.271	49.318
100.218	49.426	49.270	49.270	49.270	49.317
112.718	49.236	49.388	49.182	49.182	49.289
120.000	49.106	49.263	49.131	49.131	49.238
125.218	49.012	49.170	49.095	49.095	49.202
128.718	48.951	49.135	49.070	49.070	49.177
135.718	48.842	49.041	49.021	49.021	49.128
140.000	48.771	48.965	48.991	48.991	49.098
142.718	48.746	48.944	48.972	48.972	49.079
146.218	48.712	48.909	48.948	48.948	49.055
155.218	48.613	48.827	48.885	48.885	48.992
156.718	48.615	48.810	48.874	48.874	48.981
160.000	48.583	48.791	48.851	48.851	48.958
165.718	48.516	48.731	48.811	48.811	48.918
170.718	48.494	48.703	48.776	48.776	48.883
174.558	48.477	48.685	48.750	48.750	48.856
176.218	48.479	48.667	48.741	48.741	48.848
180.000	48.478	48.627	48.722	48.722	48.829
183.218	48.455	48.623	48.706	48.706	48.813
188.718	48.466	48.641	48.679	48.679	48.785
195.718	48.488	48.643	48.644	48.644	48.750
199.218	48.482	48.651	48.626	48.626	48.733
200.000	48.480	48.642	48.622	48.622	48.729
206.218	48.525	48.672	48.591	48.591	48.698
209.718	48.567	48.681	48.574	48.574	48.680
216.718	48.594	48.709	48.539	48.539	48.645
220.000	48.606	48.729	48.522	48.522	48.629
222.218	48.613	48.747	48.511	48.511	48.618
227.218	48.639	48.716	48.486	48.486	48.593
232.718	48.682	48.715	48.459	48.459	48.565
239.718	48.727	48.719	48.424	48.424	48.530
240.000	48.728	48.719	48.422	48.422	48.529
243.218	48.737	48.717	48.406	48.406	48.513
252.218	48.724	48.669	48.361	48.361	48.468
255.718	48.734	48.673	48.344	48.344	48.450
260.000	48.746	48.647	48.322	48.322	48.429
266.218	48.729	48.617	48.291	48.291	48.398
268.218	48.737	48.606	48.281	48.281	48.388
278.718	48.748	48.617	48.229	48.229	48.335
280.000	48.747	48.611	48.222	48.222	48.329
282.218	48.746	48.611	48.211	48.211	48.318
291.218	48.739	48.595	48.166	48.166	48.273
297.418	48.686	48.573	48.135	48.135	48.242
300.000	48.654	48.544	48.122	48.122	48.229
305.218	48.579	48.509	48.096	48.096	48.203
317.418	48.492	48.435	48.035	48.035	48.142
320.000	48.409	48.344	48.024	48.024	48.129
321.018	48.404	48.454	48.017	48.017	48.124
336.218	48.627	48.365	47.941	47.941	48.048
340.000	48.624	48.351	47.922	47.922	48.029
341.018	48.354	48.347	47.917	47.917	48.024
342.718	48.353	48.346	47.916	47.916	48.023
352.218	48.297	48.318	47.861	47.861	47.968
360.000	48.577	48.319	47.822	47.822	47.929
366.218	48.540	48.324	47.791	47.791	47.898
380.000	48.181	48.225	47.722	47.722	47.829
380.218	48.178	48.221	47.721	47.721	47.828
386.846	48.077	48.132	47.688	47.688	47.795
391.218	48.036	48.121	47.710	47.710	47.817

TURMERIC STREET

Planning and Environment Act 1987
Wyndham Planning Scheme
Approved Plan As Required
under Condition 63
Permit No WYP13902/22
Date 02/09/2025

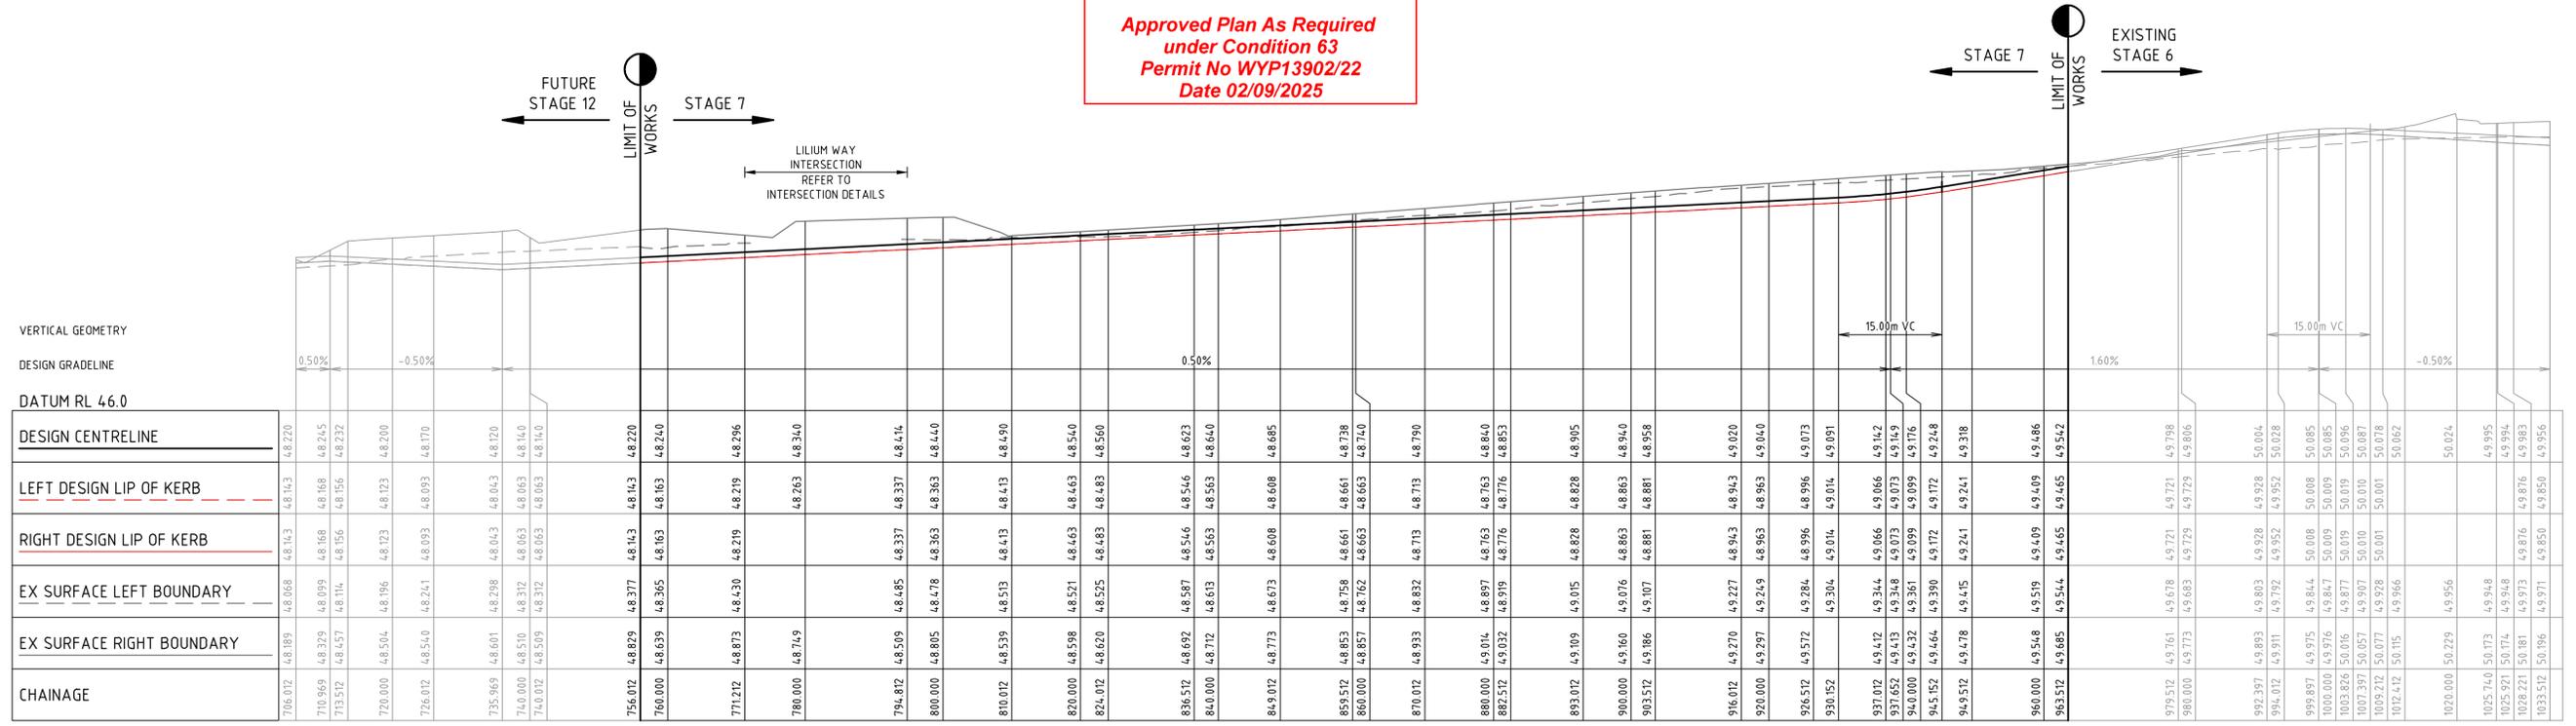


VERTICAL GEOMETRY
DESIGN GRADELINE
DATUM RL 46.0

CHAINAGE	EX SURFACE RIGHT BOUNDARY	EX SURFACE LEFT BOUNDARY	RIGHT DESIGN LIP OF KERB	LEFT DESIGN LIP OF KERB	DESIGN CENTRELINE
706.012	48.189	48.068	48.143	48.143	48.220
710.969	48.129	48.099	48.168	48.168	48.245
719.512	48.157	48.114	48.156	48.156	48.232
720.000	48.504	48.196	48.123	48.123	48.200
726.012	48.540	48.241	48.093	48.093	48.170
735.969	48.601	48.298	48.043	48.043	48.120
740.000	48.510	48.312	48.063	48.063	48.140
740.012	48.509	48.312	48.063	48.063	48.140
756.012	48.829	48.377	48.143	48.143	48.220
760.000	48.639	48.365	48.163	48.163	48.240
771.212	48.873	48.430	48.219	48.219	48.296
780.000	48.749	48.485	48.337	48.337	48.414
800.000	48.805	48.478	48.363	48.363	48.440
810.012	48.539	48.413	48.413	48.413	48.490
820.000	48.598	48.521	48.463	48.463	48.540
824.012	48.620	48.525	48.483	48.483	48.560
836.512	48.692	48.587	48.546	48.546	48.623
840.000	48.712	48.613	48.563	48.563	48.640
849.012	48.773	48.673	48.608	48.608	48.685
859.512	48.853	48.758	48.661	48.661	48.738
860.000	48.857	48.762	48.663	48.663	48.740
870.012	48.933	48.832	48.713	48.713	48.790
880.000	49.014	48.897	48.763	48.763	48.840
882.512	49.032	48.919	48.776	48.776	48.853
893.012	49.109	49.015	48.828	48.828	48.905
900.000	49.160	49.076	48.863	48.863	48.940
903.512	49.186	49.107	48.881	48.881	48.958
916.012	49.270	49.227	48.943	48.943	49.020
920.000	49.297	49.249	48.963	48.963	49.040
926.512	49.372	49.284	48.996	48.996	49.073
930.512	49.418	49.415	49.241	49.241	49.318
937.012	49.412	49.344	49.066	49.066	49.142
937.652	49.413	49.348	49.073	49.073	49.149
940.000	49.432	49.361	49.099	49.099	49.176
945.512	49.464	49.390	49.172	49.172	49.248
949.512	49.478	49.415	49.241	49.241	49.318
960.000	49.548	49.519	49.409	49.409	49.486
963.512	49.685	49.544	49.465	49.465	49.542
979.512	49.761	49.618	49.721	49.721	49.798
980.000	49.773	49.683	49.729	49.729	49.806
992.397	49.893	49.803	49.928	49.928	50.004
994.012	49.911	49.792	49.952	49.952	50.028
999.897	49.975	49.844	50.008	50.008	50.085
1000.000	49.976	49.847	50.009	50.009	50.085
1003.826	50.016	49.877	50.019	50.019	50.096
1007.397	50.057	49.907	50.010	50.010	50.087
1009.212	50.077	49.928	50.011	50.011	50.078
1012.412	50.115	49.966	50.062	50.062	50.162
1020.000	50.229	49.956	50.024	50.024	50.024
1025.740	50.173	49.948	49.995	49.995	49.995
1025.971	50.174	49.948	49.994	49.994	49.994
1028.221	50.181	49.973	49.876	49.876	49.983
1033.512	50.196	49.971	49.850	49.850	49.956

JIRA CRESCENT

Rev	Amendments	Approved	Date
1	ROAD NAME AMENDED	G.K	21/08/25
0	ISSUED FOR CONSTRUCTION	G.K	29/07/25
A	ISSUED TO COUNCIL	G.K	04/04/25

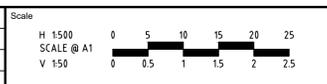


© Spiire Australia Pty Ltd All Rights Reserved
This document is produced by Spiire Australia Pty Ltd solely for the benefit of and use by the client in accordance with the terms of the retainer. Spiire Australia Pty Ltd does not and shall not assume any responsibility or liability whatsoever to any third party arising out of any use or reliance by third party on the content of this document.


spiire
L6 414 LA TROBE STREET PO BOX 16084 MELBOURNE
VICTORIA 8007 AUSTRALIA T 61 3 9993 7888
spiire.com.au ABN 55 050 029 635

Harlow
T A R N E I T
Designed
T. NGUYEN
Authorised
G. KOHLMAN
Checked
G. KOHLMAN
Date
04/04/25


HARLOW ESTATE
STAGE 7
ROAD AND DRAINAGE
ROAD LONG SECTIONS - SHEET 1
WYNDHAM CITY COUNCIL
SIG GROUP
CONSTRUCTION Drg No 309443CR300 Rev 1

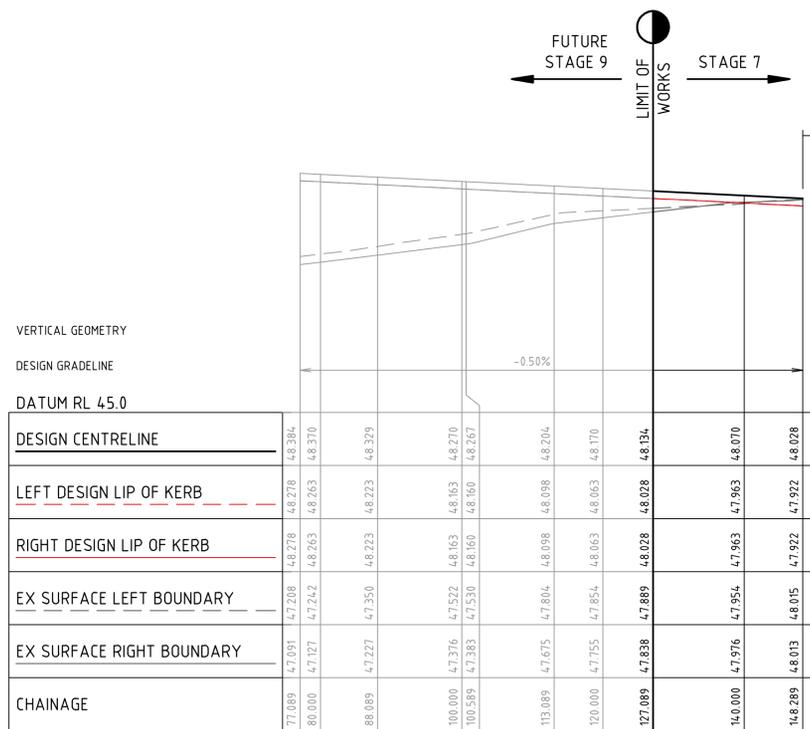

LUMPINI ROAD

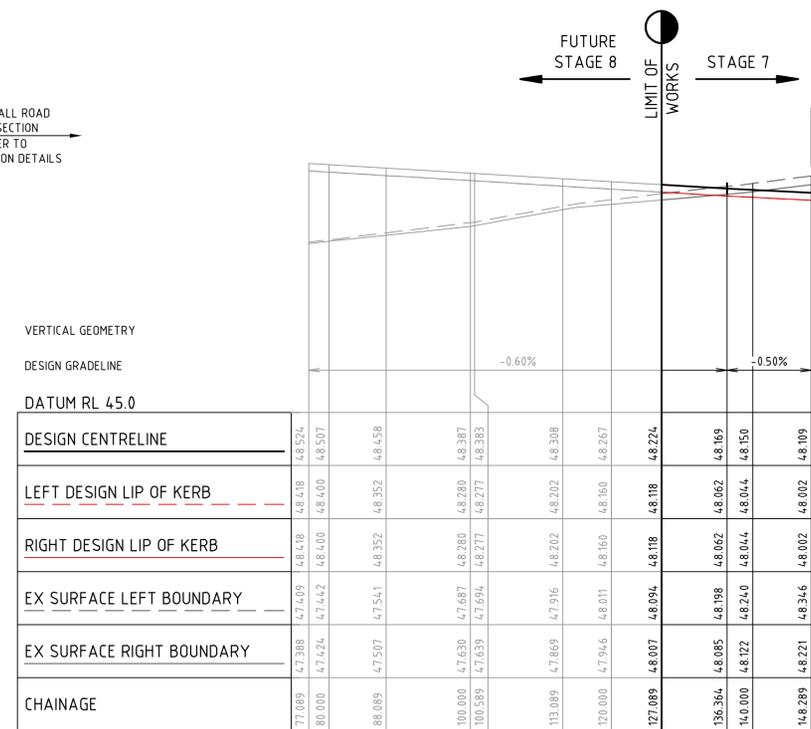

SALVIAS ROAD

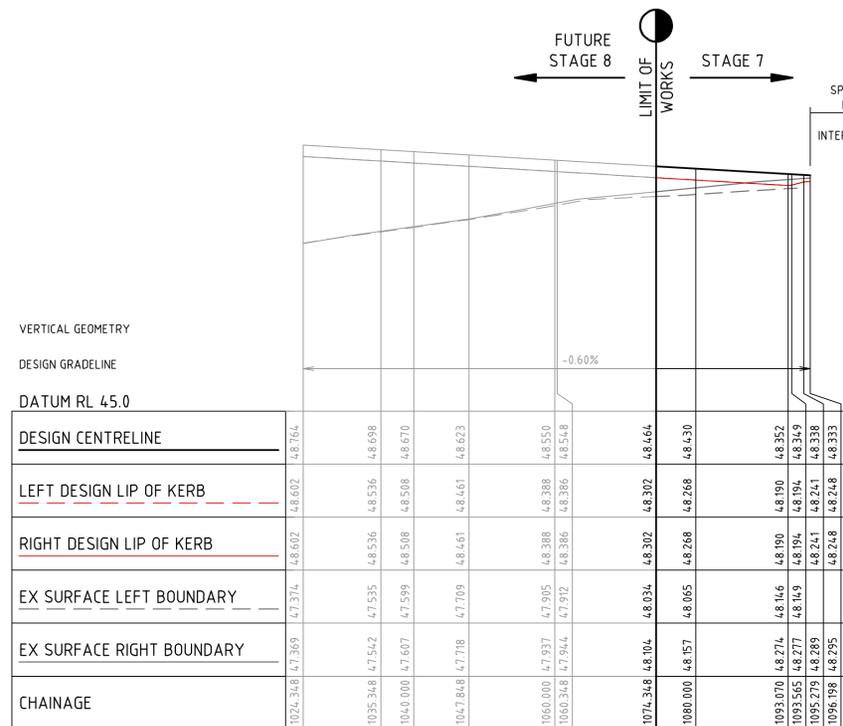


DAYLILY ROAD

Planning and Environment Act 1987
Wyndham Planning Scheme

Approved Plan As Required
under Condition 63
Permit No WYP13902/22
Date 23/07/2025

file name: 309443CR302.dwg, layout name: CR302, plotted by: Thanh Nguyen, file location: G:\309443\309443\CAD\CAD.plt, date: 30/05/2025, 4:39 PM, Sheet: 6 of 22 Sheets

Rev	Amendments	Approved	Date
A	ISSUED TO COUNCIL	G.K	04/04/25

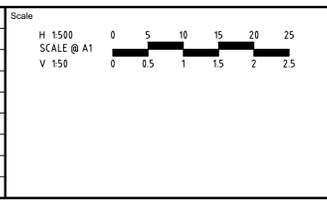

© Spiire Australia Pty Ltd All Rights Reserved
This document is produced by Spiire Australia Pty Ltd solely for the benefit of and use by the client in accordance with the terms of the retainer. Spiire Australia Pty Ltd does not and shall not assume any responsibility or liability whatsoever to any third party arising out of any use or reliance by third party on the content of this document.

L6 414 LA TROBE STREET PO BOX 16084 MELBOURNE
VICTORIA 8007 AUSTRALIA T 61 3 9993 7888
spiire.com.au ABN 55 050 029 635


Designed
T. NGUYEN
Authorised
G. KOHLMAN
Checked
G. KOHLMAN
Date
04/04/25

**HARLOW ESTATE
STAGE 7
ROAD AND DRAINAGE
ROAD LONG SECTIONS - SHEET 3
WYNDHAM CITY COUNCIL
SIG GROUP**

Dwg No
309443CR302
Rev
A

FILLING NOTE
 ALL FILLING WITHIN ROAD RESERVES IS TO BE UNDERTAKEN USING LEVEL 1 SUPERVISION AND BE COMPLETED IN ACCORDANCE WITH AS 3798-2007 AND TO THE SATISFACTION OF COUNCIL AND THE SUPERINTENDENT. FILL AREAS ARE TO BE STRIPPED OF TOPSOIL, FILLED AND REPLACED WITH TOPSOIL (WHERE REQUIRED) TO OBTAIN THE FINAL LEVELS SHOWN ON THE DRAWINGS.

 STRUCTURAL FILL IN ACCORDANCE WITH AS3798-2007, LEVEL 1

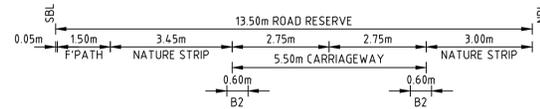


DATUM R.L.47.0

DESIGN SURFACE LEVEL	EXISTING SURFACE LEVEL	OFFSET
48.589	48.485	-7.750
48.587	48.484	-7.700
48.557	48.475	-6.200
48.447	48.471	-2.900
48.337	48.454	-2.300
48.414	48.452	0.000
48.337	48.508	2.300
48.447	48.519	2.900
48.509	48.509	5.750

JIRA CRESCENT

CH 794.81

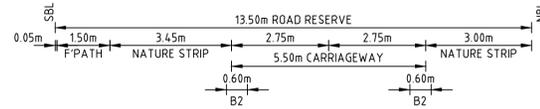


DATUM R.L.47.0

DESIGN SURFACE LEVEL	EXISTING SURFACE LEVEL	OFFSET
49.080	49.015	-7.750
49.078	49.015	-7.700
49.048	49.023	-6.200
48.938	49.041	-2.900
48.828	49.049	-2.300
48.905	49.073	0.000
48.828	49.021	2.300
48.938	49.020	2.900
49.109	49.109	5.750

JIRA CRESCENT

CH 893.01

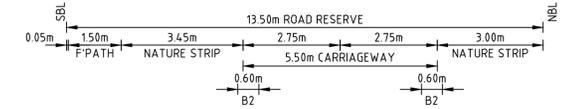


DATUM R.L.48.0

DESIGN SURFACE LEVEL	EXISTING SURFACE LEVEL	OFFSET
49.717	49.544	-7.750
49.715	49.544	-7.700
49.685	49.538	-6.200
49.575	49.539	-2.900
49.465	49.549	-2.300
49.542	49.668	0.000
49.465	49.692	2.300
49.575	49.694	2.900
49.685	49.685	5.750

JIRA CRESCENT

CH 963.51

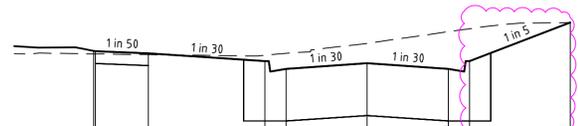


DATUM R.L.46.0

DESIGN SURFACE LEVEL	EXISTING SURFACE LEVEL	OFFSET
48.471	48.430	-7.750
48.469	48.430	-7.700
48.439	48.419	-6.200
48.329	48.410	-2.900
48.219	48.437	-2.300
48.296	48.579	0.000
48.219	48.713	2.300
48.329	48.786	2.900
48.873	48.873	5.750

JIRA CRESCENT

CH 771.21

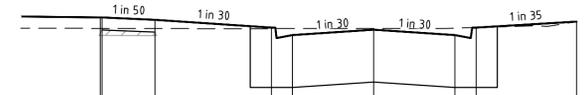


DATUM R.L.47.0

DESIGN SURFACE LEVEL	EXISTING SURFACE LEVEL	OFFSET
48.913	48.758	-7.750
48.911	48.758	-7.700
48.881	48.756	-6.200
48.771	48.753	-2.900
48.661	48.757	-2.300
48.738	48.758	0.000
48.661	48.808	2.300
48.771	48.825	2.900
48.853	48.853	5.750

JIRA CRESCENT

CH 859.51

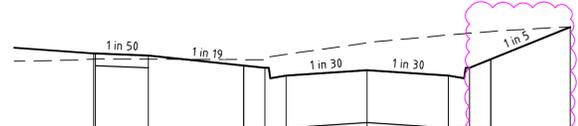


DATUM R.L.46.0

DESIGN SURFACE LEVEL	EXISTING SURFACE LEVEL	OFFSET
48.568	48.377	-7.750
48.557	48.379	-7.700
48.427	48.376	-6.200
48.253	48.401	-2.900
48.143	48.443	-2.300
48.220	48.607	0.000
48.143	48.718	2.300
48.253	48.743	2.900
48.829	48.829	5.750

JIRA CRESCENT

CH 756.01

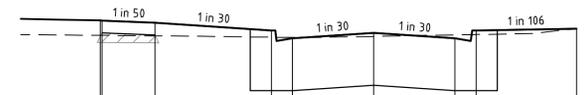


DATUM R.L.47.0

DESIGN SURFACE LEVEL	EXISTING SURFACE LEVEL	OFFSET
48.735	48.525	-7.750
48.733	48.525	-7.700
48.703	48.518	-6.200
48.593	48.498	-2.900
48.483	48.494	-2.300
48.560	48.510	0.000
48.483	48.528	2.300
48.593	48.541	2.900
48.620	48.620	5.750

JIRA CRESCENT

CH 824.01

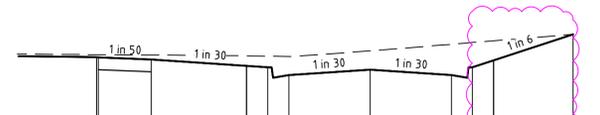

DATUM R.L.47.0

DESIGN SURFACE LEVEL	EXISTING SURFACE LEVEL	OFFSET
49.248	49.284	-7.750
49.246	49.284	-7.700
49.216	49.279	-6.200
49.106	49.262	-2.900
48.996	49.256	-2.300
49.073	49.337	0.000
48.996	49.431	2.300
49.106	49.457	2.900
49.572	49.572	5.750


JIRA CRESCENT

CH 926.51



file name: 309443CR400.dwg, layout name: CR401, plotted by: Thanh Nguyen, file location: G:\309443\309443\A\CAD\plot date: 30/05/2025 4:39 PM, Sheet: 8 of 22 Sheets

Rev	Description	Approved	Date
B	ROAD CROSS SECTIONS AMENDED	G.K	30/05/25
A	ISSUED TO COUNCIL	G.K	04/04/25

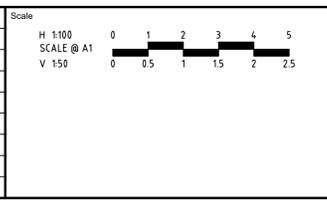


 System Certified
 © Spiire Australia Pty Ltd All Rights Reserved
 This document is produced by Spiire Australia Pty Ltd solely for the benefit of and use by the client in accordance with the terms of the retainer. Spiire Australia Pty Ltd does not and shall not assume any responsibility or liability whatsoever to any third party arising out of any use or reliance by third party on the content of this document.






 L6 414 LA TROBE STREET PO BOX 16084 MELBOURNE
 VICTORIA 8007 AUSTRALIA T 61 3 9993 7888
 spiire.com.au ABN 55 050 029 635


 Designed: T. NGUYEN
 Authorised: G. KOHLMAN
 Checked: G. KOHLMAN
 Date: 04/04/25

HARLOW ESTATE
STAGE 7
ROAD AND DRAINAGE
ROAD CROSS SECTIONS - SHEET 2
WYNDHAM CITY COUNCIL
SIG GROUP
 Drg No: 309443CR401
 Rev: B


FILLING NOTE
 ALL FILLING WITHIN ROAD RESERVES IS TO BE UNDERTAKEN USING LEVEL 1 SUPERVISION AND BE COMPLETED IN ACCORDANCE WITH AS 3798-2007 AND TO THE SATISFACTION OF COUNCIL AND THE SUPERINTENDENT. FILL AREAS ARE TO BE STRIPPED OF TOPSOIL, FILLED AND REPLACED WITH TOPSOIL (WHERE REQUIRED) TO OBTAIN THE FINAL LEVELS SHOWN ON THE DRAWINGS.

 STRUCTURAL FILL IN ACCORDANCE WITH AS3798-2007, LEVEL 1

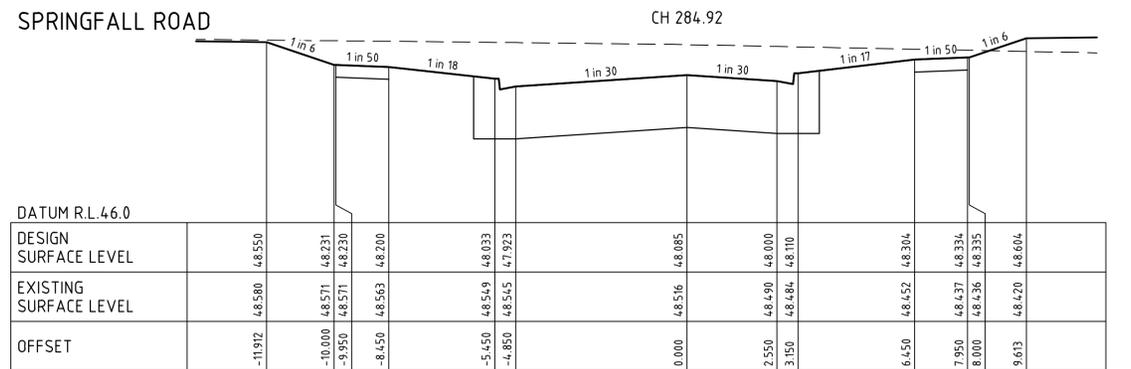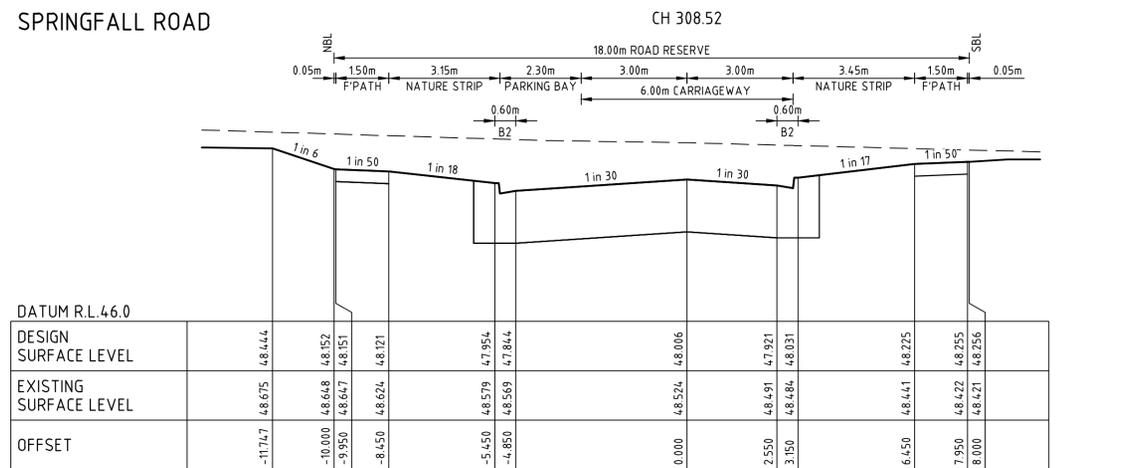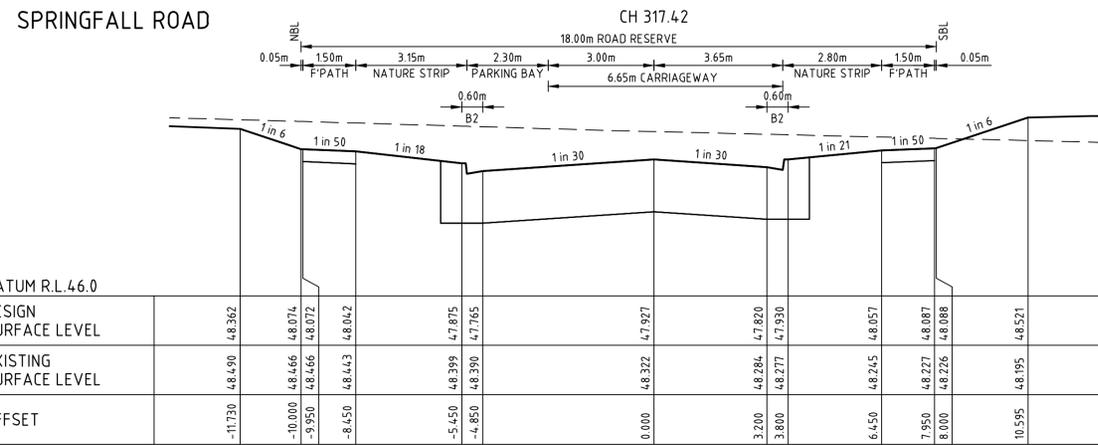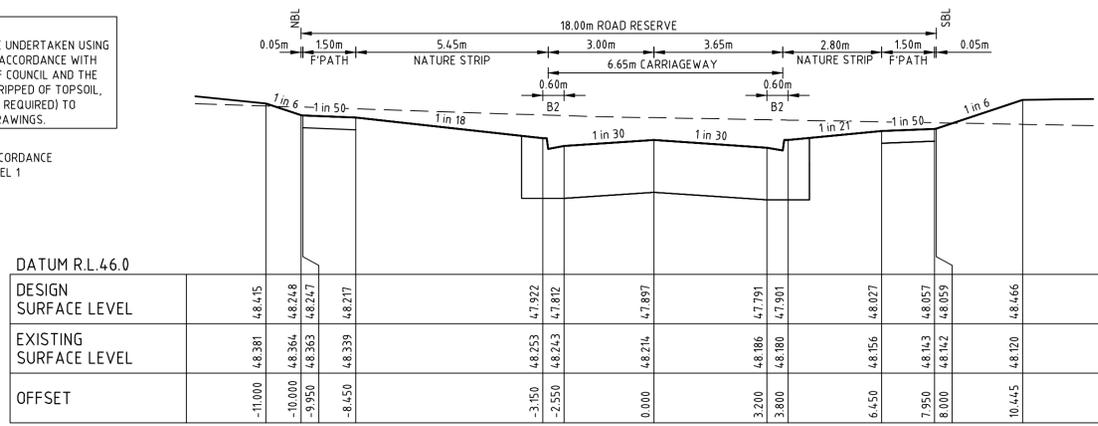


SPRINGFALL ROAD CH 261.22


Planning and Environment Act 1987
Wyndham Planning Scheme
Approved Plan As Required
under Condition 63
Permit No WYP13902/22
Date 23/07/2025

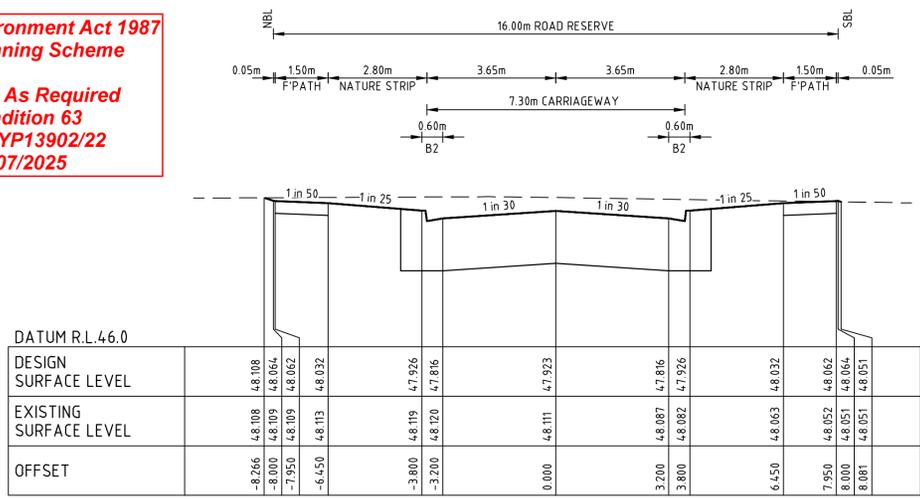


SPRINGFALL ROAD CH 384.72

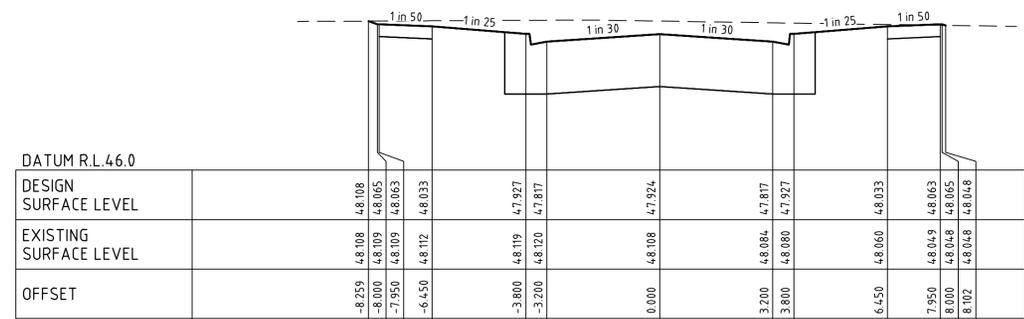

SPRINGFALL ROAD CH 384.52

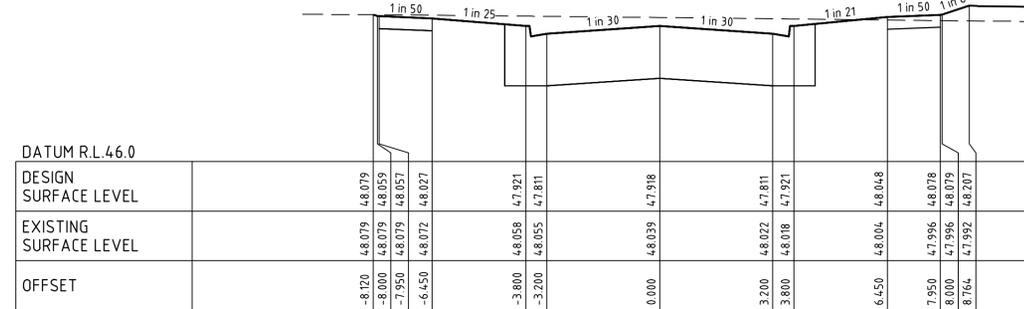


SPRINGFALL ROAD CH 360.92

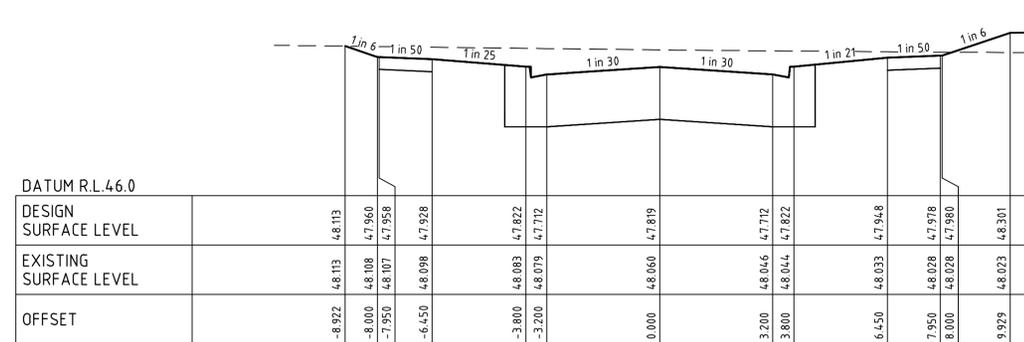

SPRINGFALL ROAD CH 341.02

file name: 309443CR403.dwg, layout name: CR403, plotted by: Thanh Nguyen, file location: G:\309443\309443\309443.dwg, plot date: 30/05/2025 4:39 PM, sheet: 10 of 22, sheets

Rev	Issued To Council	G.K	04/04/25
A	ISSUED TO COUNCIL	G.K	04/04/25
Rev	Amendments	Approved	Date

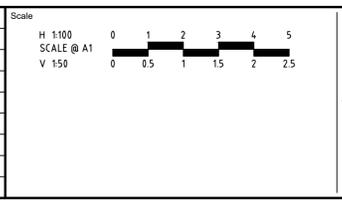



 System Certified
 © Spiire Australia Pty Ltd All Rights Reserved
 This document is produced by Spiire Australia Pty Ltd solely for the benefit of and use by the client in accordance with the terms of the retainer. Spiire Australia Pty Ltd does not and shall not assume any responsibility or liability whatsoever to any third party arising out of any use or reliance by third party on the content of this document.



 L6 414 LA TROBE STREET PO BOX 16084 MELBOURNE
 VICTORIA 8007 AUSTRALIA T 61 3 9993 7888
 spiire.com.au ABN 55 050 029 635



 Designed: T. NGUYEN
 Authorised: G. KOHLMAN
 Checked: G. KOHLMAN
 Date: 04/04/25


HARLOW ESTATE
STAGE 7
ROAD AND DRAINAGE
ROAD CROSS SECTIONS - SHEET 4
WYNDHAM CITY COUNCIL
SIG GROUP
 Drg No: 309443CR403
 Rev: A

FILLING NOTE
 ALL FILLING WITHIN ROAD RESERVES IS TO BE UNDERTAKEN USING LEVEL 1 SUPERVISION AND BE COMPLETED IN ACCORDANCE WITH AS 3798-2007 AND TO THE SATISFACTION OF COUNCIL AND THE SUPERINTENDENT. FILL AREAS ARE TO BE STRIPPED OF TOPSOIL, FILLED AND REPLACED WITH TOPSOIL (WHERE REQUIRED) TO OBTAIN THE FINAL LEVELS SHOWN ON THE DRAWINGS.

 STRUCTURAL FILL IN ACCORDANCE WITH AS3798-2007, LEVEL 1

Planning and Environment Act 1987
Wyndham Planning Scheme


Approved Plan As Required
under Condition 63
Permit No WYP13902/22
Date 23/07/2025

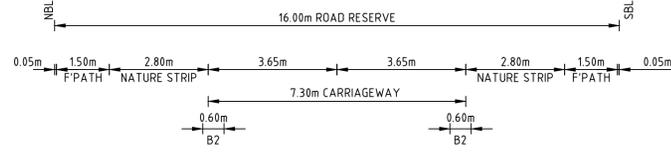

DATUM R.L.47.0

DESIGN SURFACE LEVEL	EXISTING SURFACE LEVEL	OFFSET
-8.000	48.505	48.660
-7.950	48.501	48.658
-6.450	48.490	48.628
-3.800	48.473	48.540
-3.200	48.472	48.430
0.000	48.472	48.536
3.200	48.462	48.430
3.800	48.459	48.540
6.450	48.453	48.628
7.950	48.453	48.658
8.000	48.453	48.660

LILIAM WAY CH 68.35

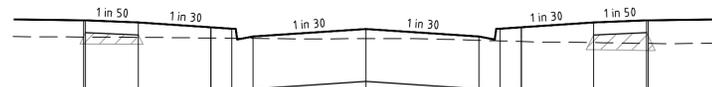

DATUM R.L.47.0

DESIGN SURFACE LEVEL	EXISTING SURFACE LEVEL	OFFSET
-8.000	48.533	48.769
-7.950	48.533	48.761
-6.450	48.528	48.737
-3.800	48.515	48.649
-3.200	48.513	48.539
0.000	48.509	48.646
3.200	48.486	48.539
3.800	48.477	48.649
6.450	48.454	48.737
7.950	48.442	48.767
8.000	48.441	48.769


LILIAM WAY CH 35.50



DATUM R.L.47.0

DESIGN SURFACE LEVEL	EXISTING SURFACE LEVEL	OFFSET
-8.000	48.513	48.501
-7.950	48.512	48.499
-6.450	48.515	48.469
-3.800	48.514	48.381
-3.200	48.511	48.271
0.000	48.501	48.377
3.200	48.490	48.271
3.800	48.487	48.381
6.450	48.480	48.469
7.950	48.469	48.499
8.000	48.469	48.501


LILIAM WAY CH 11.80

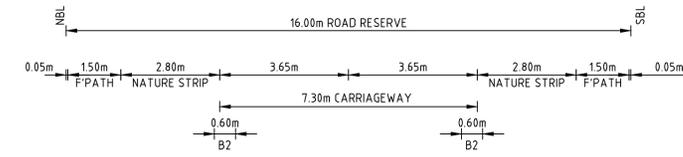

DATUM R.L.46.0

DESIGN SURFACE LEVEL	EXISTING SURFACE LEVEL	OFFSET
-8.000	48.454	48.340
-7.950	48.453	48.339
-6.450	48.436	48.309
-3.800	48.415	48.220
-3.200	48.412	48.110
0.000	48.396	48.217
3.200	48.367	48.110
3.800	48.366	48.220
6.450	48.366	48.309
7.950	48.360	48.339
8.000	48.360	48.340
8.116	48.360	48.360


TEASEL WAY CH 66.20

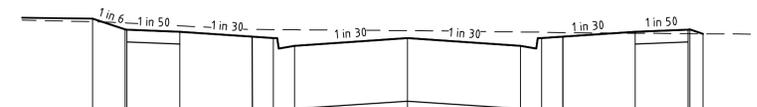

DATUM R.L.46.0

DESIGN SURFACE LEVEL	EXISTING SURFACE LEVEL	OFFSET
-8.923	48.447	48.493
-8.000	48.431	48.339
-7.950	48.430	48.337
-6.450	48.391	48.307
-3.800	48.336	48.219
-3.200	48.334	48.109
0.000	48.323	48.215
3.200	48.303	48.109
3.800	48.299	48.219
6.450	48.285	48.307
7.950	48.279	48.337
8.000	48.279	48.339
8.366	48.278	48.278

TEASEL WAY CH 45.50

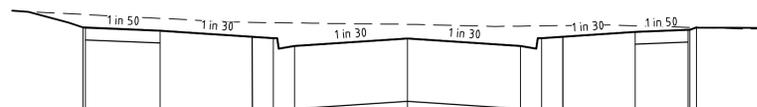


DATUM R.L.46.0

DESIGN SURFACE LEVEL	EXISTING SURFACE LEVEL	OFFSET
-9.200	48.343	48.159
-9.129	48.341	48.157
-7.108	48.287	48.114
-3.800	48.228	48.008
-3.200	48.224	47.898
0.000	48.203	48.004
3.200	48.179	47.898
3.800	48.182	48.008
6.450	48.182	48.096
7.950	48.161	48.176
8.000	48.161	48.178
8.183	48.158	48.158

TEASEL WAY CH 11.80

file name: 309443CR404.dwg, layout name: CSD-04, plotted by: Thanh Nguyen, file location: G:\309443\309443\DWG\CAD\plot date: 30/05/2025 4:39 PM Sheet 11 of 22 Sheets

Rev	Description	Approved	Date
A	ISSUED TO COUNCIL	G.K	04/04/25
	Amendments		

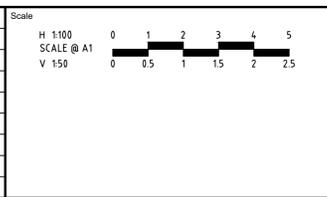


 System Certified
 © Spiire Australia Pty Ltd All Rights Reserved
 This document is produced by Spiire Australia Pty Ltd solely for the benefit of and use by the client in accordance with the terms of the retainer. Spiire Australia Pty Ltd does not and shall not assume any responsibility or liability whatsoever to any third party arising out of any use or reliance by third party on the content of this document.



 L6 414 LA TROBE STREET PO BOX 16084 MELBOURNE
 VICTORIA 8007 AUSTRALIA T 61 3 9993 7888
 spiire.com.au ABN 55 050 029 635


 Designed
 T. NGUYEN
 Authorised
 G. KOHLMAN
 Checked
 G. KOHLMAN
 Date
 04/04/25

HARLOW ESTATE
STAGE 7
ROAD AND DRAINAGE
ROAD CROSS SECTIONS - SHEET 5
WYNDHAM CITY COUNCIL
SIG GROUP
 Drg No
309443CR404
 Rev
A


FILLING NOTE
 ALL FILLING WITHIN ROAD RESERVES IS TO BE UNDERTAKEN USING LEVEL 1 SUPERVISION AND BE COMPLETED IN ACCORDANCE WITH AS 3798-2007 AND TO THE SATISFACTION OF COUNCIL AND THE SUPERINTENDENT. FILL AREAS ARE TO BE STRIPPED OF TOPSOIL, FILLED AND REPLACED WITH TOPSOIL (WHERE REQUIRED) TO OBTAIN THE FINAL LEVELS SHOWN ON THE DRAWINGS.

 STRUCTURAL FILL IN ACCORDANCE WITH AS3798-2007, LEVEL 1

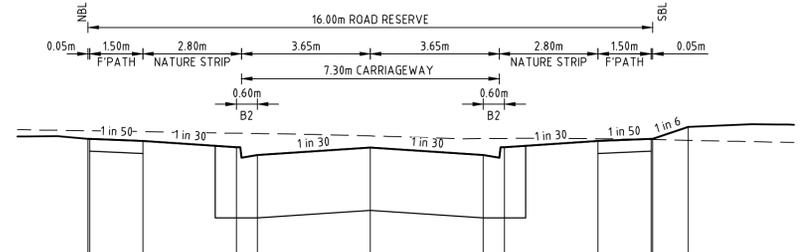


DATUM R.L.46.0	
DESIGN SURFACE LEVEL	48.232
EXISTING SURFACE LEVEL	48.346
OFFSET	-8.000

SALVIAS ROAD CH 148.29

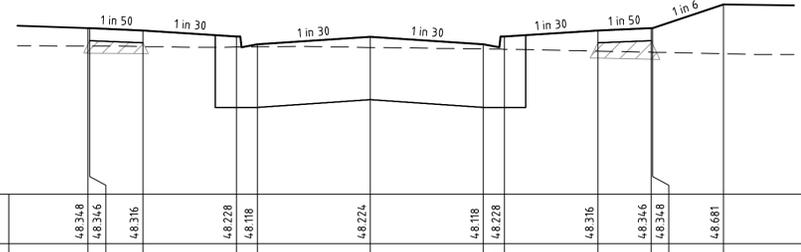


DATUM R.L.46.0	
DESIGN SURFACE LEVEL	48.348
EXISTING SURFACE LEVEL	48.094
OFFSET	-8.000

SALVIAS ROAD CH 127.09

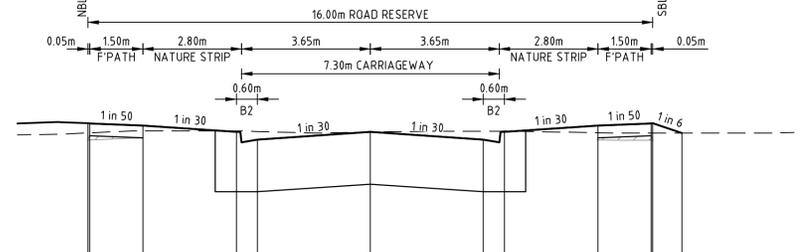

DATUM R.L.46.0	
DESIGN SURFACE LEVEL	48.152
EXISTING SURFACE LEVEL	48.016
OFFSET	-8.000

LUMPINI ROAD CH 148.29

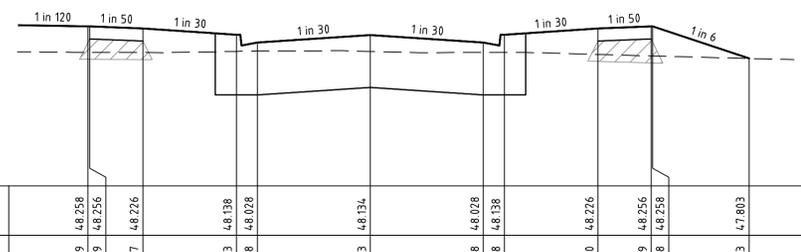


DATUM R.L.46.0	
DESIGN SURFACE LEVEL	48.258
EXISTING SURFACE LEVEL	47.889
OFFSET	-8.000

LUMPINI ROAD CH 127.09



DATUM R.L.46.0	
DESIGN SURFACE LEVEL	48.467
EXISTING SURFACE LEVEL	48.146
OFFSET	-10.000

DAYLILY ROAD CH 1093.07

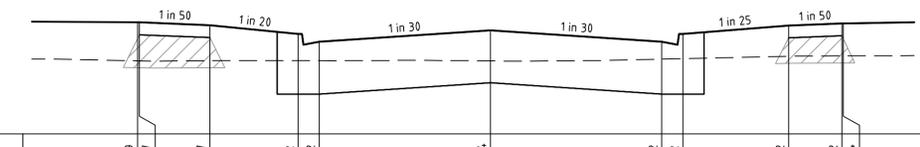


DATUM R.L.47.0	
DESIGN SURFACE LEVEL	48.579
EXISTING SURFACE LEVEL	48.034
OFFSET	-10.000

DAYLILY ROAD CH 1074.35

Planning and Environment Act 1987
Wyndham Planning Scheme

Approved Plan As Required
under Condition 63
Permit No WYP13902/22
Date 23/07/2025

file name: 309443CR405.dwg, layout name: CS405, plot date: 30/05/2025 4:39 PM, Sheet 12 of 22, Sheets




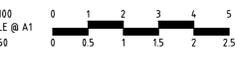
Scale	H 1:100	V 1:50
Scale @ A1		
Rev	A	ISSUED TO COUNCIL
Rev		Amendments
Rev	G.K	04/04/25
Rev		Approved Date


 System Certified
 © Spiire Australia Pty Ltd All Rights Reserved
 This document is produced by Spiire Australia Pty Ltd solely for the benefit of and use by the client in accordance with the terms of the retainer. Spiire Australia Pty Ltd does not and shall not assume any responsibility or liability whatsoever to any third party arising out of any use or reliance by third party on the content of this document.


 L6 414 LA TROBE STREET PO BOX 16084 MELBOURNE
 VICTORIA 8007 AUSTRALIA T 61 3 9993 7888
 spiire.com.au ABN 55 050 029 635



 Designed
T. NGUYEN
 Authorised
G. KOHLMAN
 Checked
G. KOHLMAN
 Date
04/04/25

HARLOW ESTATE
STAGE 7
ROAD AND DRAINAGE
ROAD CROSS SECTIONS - SHEET 6
WYNDHAM CITY COUNCIL
SIG GROUP
 Drg No
309443CR405
 Rev
A

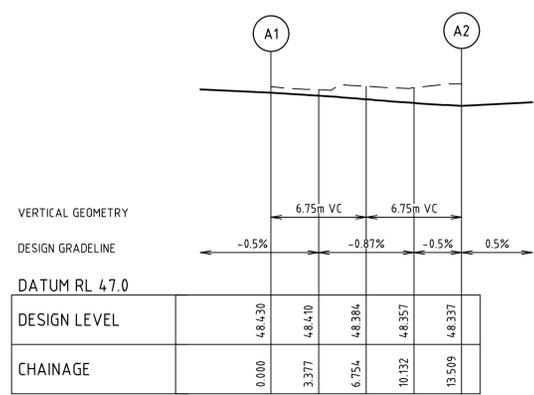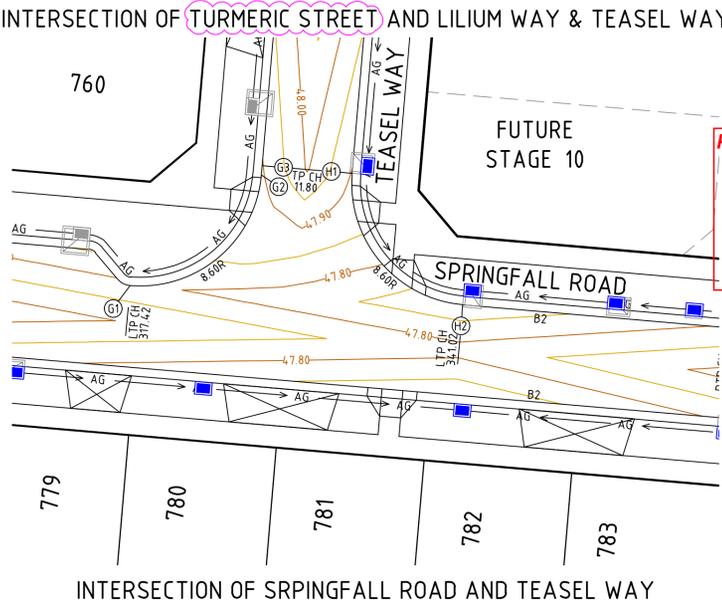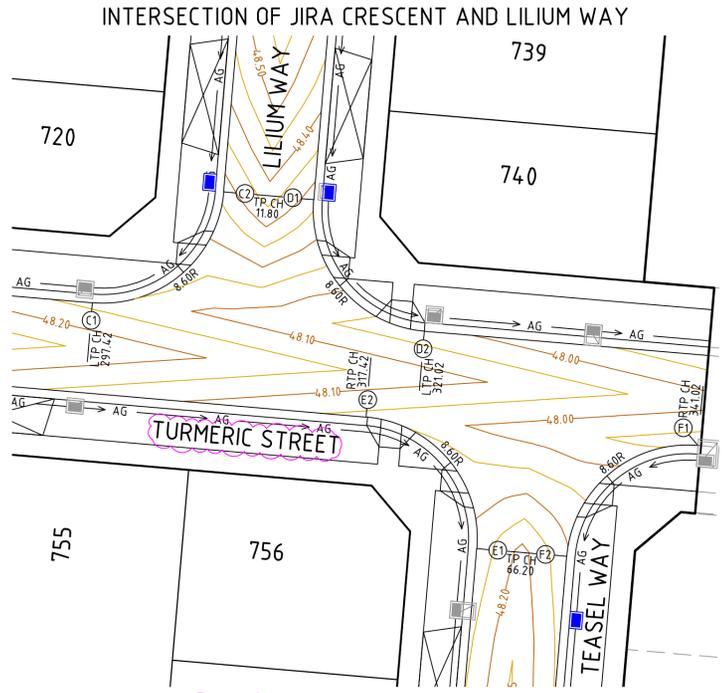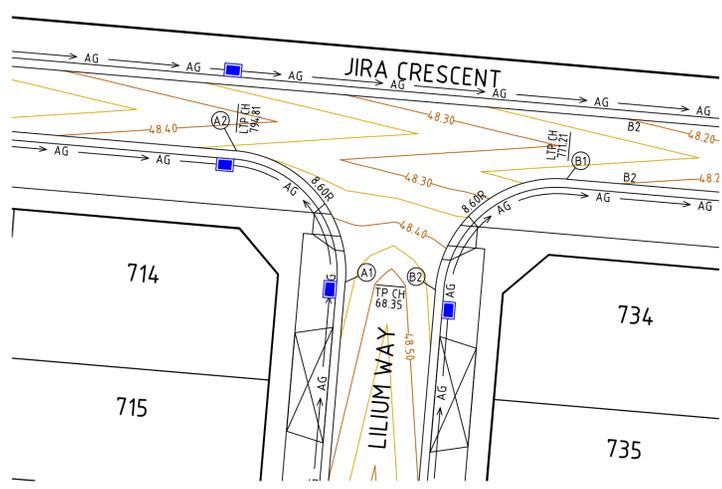


ALIGNMENT A
ALIGNMENT A

POINT NO	EASTING	NORTHING	RL
A1	298107.573	5812773.374	48.430
1/4	298107.201	5812776.709	48.410
1/2	298105.581	5812779.648	48.384
3/4	298102.961	5812781.743	48.357
A2	298099.737	5812782.676	48.337

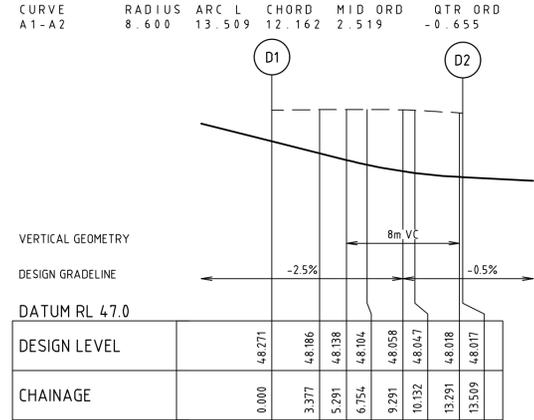


ALIGNMENT D
ALIGNMENT D

POINT NO	EASTING	NORTHING	RL
D1	298109.129	5812716.485	48.271
1/4	298109.501	5812713.150	48.186
1/2	298111.121	5812710.211	48.104
3/4	298113.742	5812708.116	48.047
D2	298116.965	5812707.183	48.017

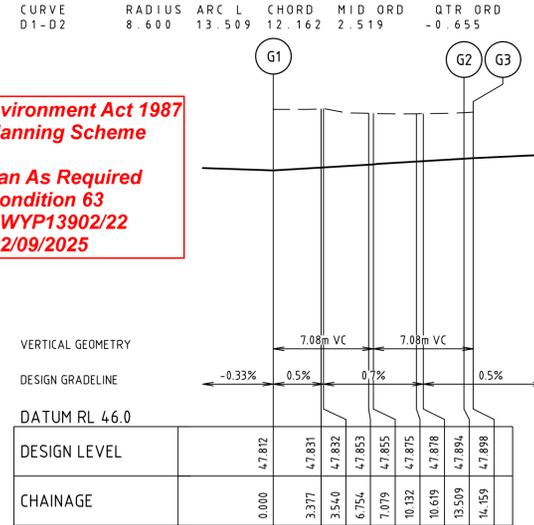


ALIGNMENT G
ALIGNMENT G

POINT NO	EASTING	NORTHING	RL
G1	298106.674	5812629.126	47.812
1/4	298110.009	5812629.498	47.831
1/2	298112.948	5812631.117	47.853
3/4	298115.043	5812633.738	47.875
G2	298115.976	5812636.962	47.894
G3	298116.031	5812637.609	47.898

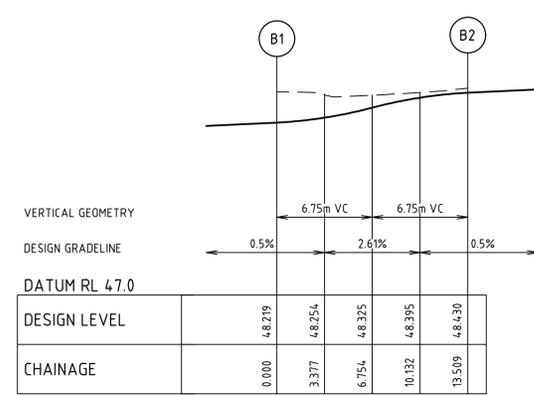


ALIGNMENT B
ALIGNMENT B

POINT NO	EASTING	NORTHING	RL
B1	298123.251	5812780.665	48.219
1/4	298119.916	5812780.293	48.254
1/2	298116.978	5812778.673	48.325
3/4	298114.882	5812776.052	48.395
B2	298113.950	5812772.829	48.430

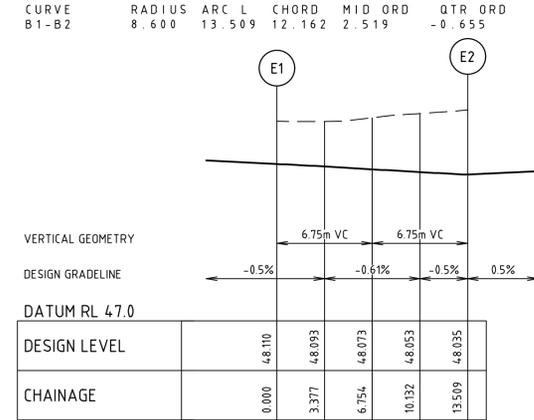


ALIGNMENT E
ALIGNMENT E

POINT NO	EASTING	NORTHING	RL
E1	298120.668	5812691.811	48.110
1/4	298120.297	5812695.146	48.093
1/2	298118.677	5812698.085	48.073
3/4	298116.056	5812700.180	48.053
E2	298112.833	5812701.113	48.035

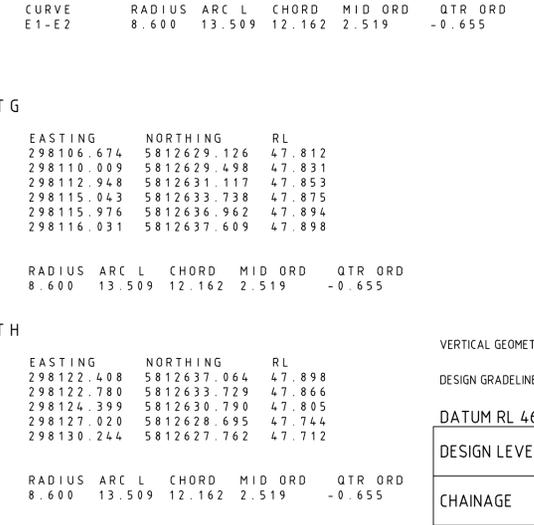


ALIGNMENT H
ALIGNMENT H

POINT NO	EASTING	NORTHING	RL
H1	298122.408	5812637.064	47.898
1/4	298122.780	5812633.729	47.866
1/2	298124.399	5812630.790	47.805
3/4	298127.020	5812628.695	47.744
H2	298130.244	5812627.762	47.712

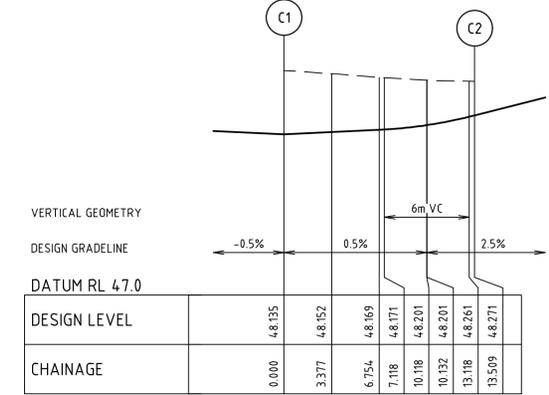


ALIGNMENT C
ALIGNMENT C

POINT NO	EASTING	NORTHING	RL
C1	298093.451	5812709.195	48.135
1/4	298096.786	5812709.566	48.152
1/2	298099.725	5812711.186	48.169
3/4	298101.820	5812713.807	48.201
C2	298102.753	5812717.030	48.271

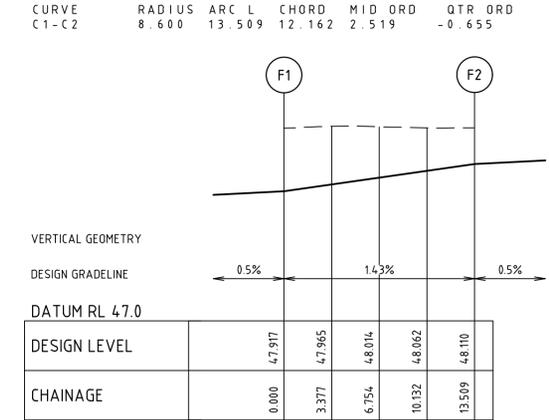


ALIGNMENT F
ALIGNMENT F

POINT NO	EASTING	NORTHING	RL
F1	298136.347	5812699.102	47.917
1/4	298133.012	5812698.730	47.965
1/2	298130.073	5812697.110	48.014
3/4	298127.978	5812694.489	48.062
F2	298127.045	5812691.266	48.110

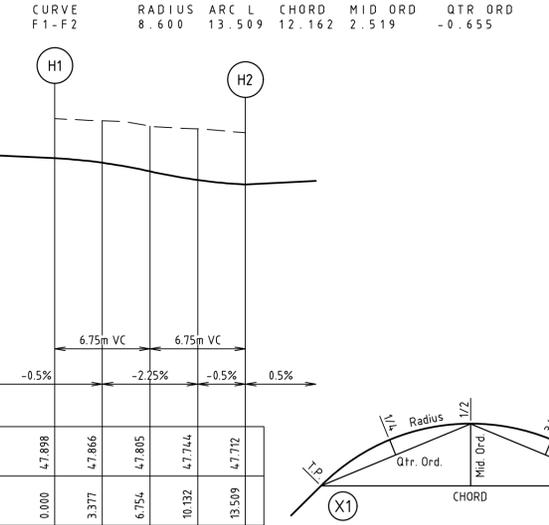

ALIGNMENT H
ALIGNMENT H

POINT NO	EASTING	NORTHING	RL
H1	298122.408	5812637.064	47.898
1/4	298122.780	5812633.729	47.866
1/2	298124.399	5812630.790	47.805
3/4	298127.020	5812628.695	47.744
H2	298130.244	5812627.762	47.712

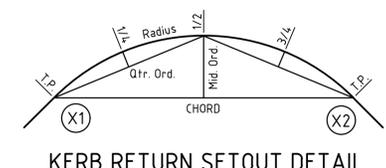


Planning and Environment Act 1987
Wyndham Planning Scheme

Approved Plan As Required
under Condition 63
Permit No WYP13902/22
Date 02/09/2025

file name: 309443CR500.dwg, layout name: CR500, plotted by: Theah Nguyen, file location: \\spiremedia\data\309443.dwg, plot date: 28/08/2025 5:43 PM, Sheet: 13 of 22, Sheets

Rev	Amendments	Approved	Date
1	ROAD NAME AMENDED	G.K	21/08/25
0	ISSUED FOR CONSTRUCTION	G.K	29/07/25
A	ISSUED TO COUNCIL	G.K	04/04/25

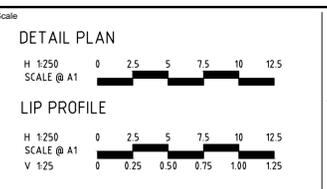

spiire

L6 414 LA TROBE STREET PO BOX 16084 MELBOURNE
VICTORIA 8007 AUSTRALIA T 61 3 9993 7888
spiire.com.au ABN 55 050 029 635

Harlow
T A R N E I T

Designed
T. NGUYEN


Checked
G. KOHLMAN

Authorised
G. KOHLMAN


Date
04/04/25

HARLOW ESTATE
STAGE 7
ROAD AND DRAINAGE
INTERSECTION DETAILS - SHEET 1
WYNDHAM CITY COUNCIL
SIG GROUP


CONSTRUCTION Drg No **309443CR500** Rev **1**

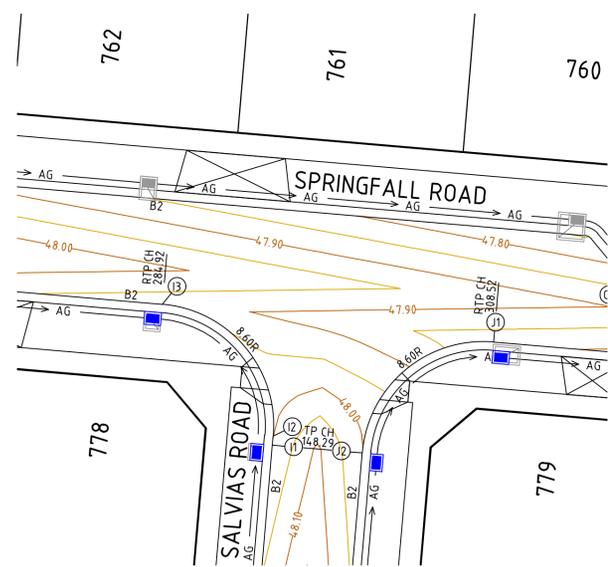


INTERSECTION OF SRPINGFALL ROAD AND SALVIAS ROAD

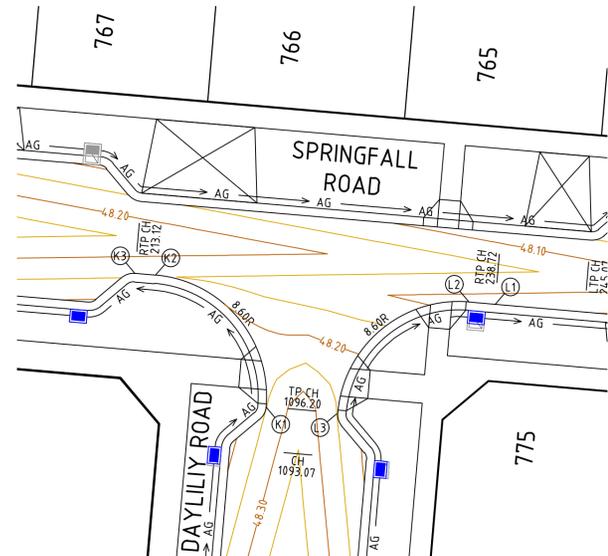

INTERSECTION OF SRPINGFALL ROAD AND DAYLILY ROAD

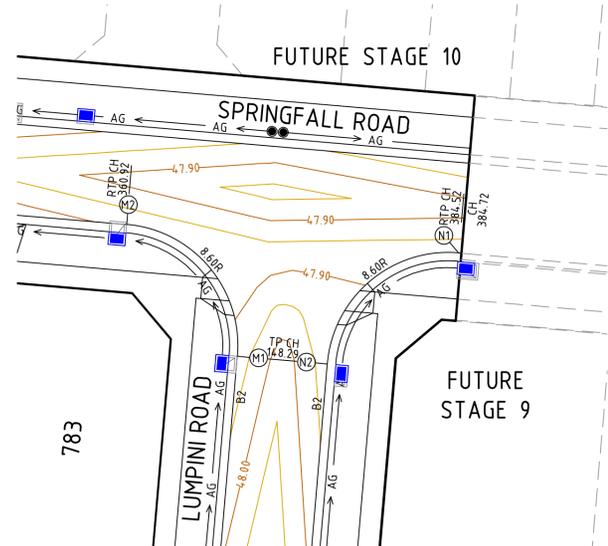


INTERSECTION OF SRPINGFALL ROAD AND LUMPINI ROAD

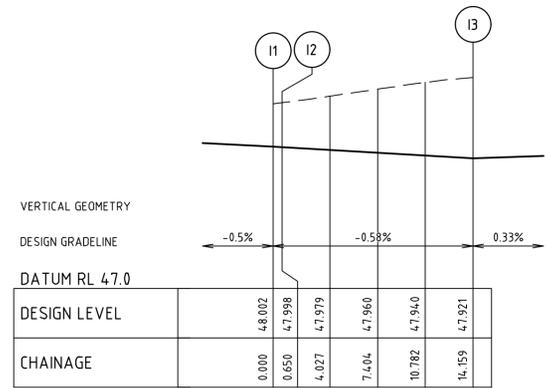

ALIGNMENT I
ALIGNMENT I

POINT NO	EASTING	NORTHING	RL
I1	298081.638	5812616.866	48.002
I2	298081.693	5812617.513	47.998
1/4	298081.322	5812620.848	47.979
1/2	298079.702	5812623.787	47.960
3/4	298077.081	5812625.882	47.940
I3	298073.858	5812626.815	47.921


CURVE	RADIUS	ARC L	CHORD	MID ORD	QTR ORD
I2-I3	8.600	13.509	12.162	2.519	-0.655

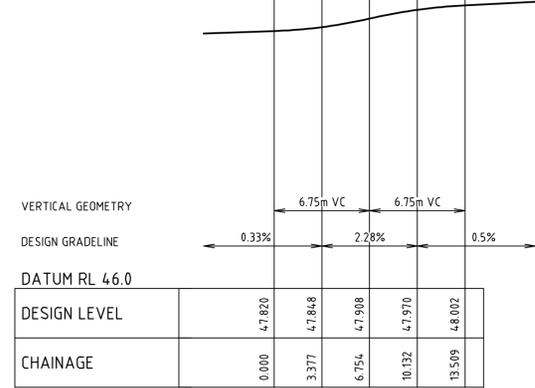

ALIGNMENT J
ALIGNMENT J

POINT NO	EASTING	NORTHING	RL
J1	298097.316	5812624.156	47.820
1/4	298093.981	5812623.784	47.848
1/2	298091.043	5812622.164	47.908
3/4	298088.947	5812619.543	47.970
J2	298088.015	5812616.320	48.002


CURVE	RADIUS	ARC L	CHORD	MID ORD	QTR ORD
J1-J2	8.600	13.509	12.162	2.519	-0.655

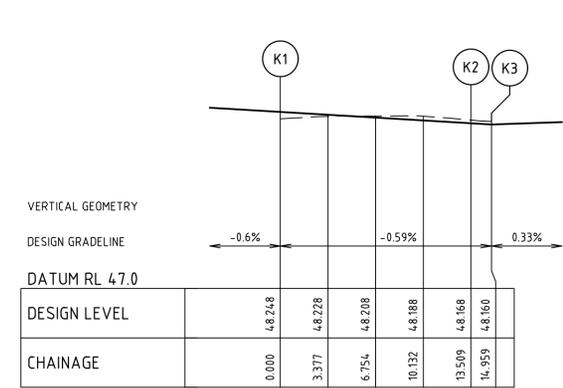

ALIGNMENT K
ALIGNMENT K

POINT NO	EASTING	NORTHING	RL
K1	298011.599	5812623.510	48.248
1/4	298011.228	5812626.845	48.228
1/2	298009.608	5812629.783	48.208
3/4	298006.987	5812631.879	48.188
K2	298003.764	5812632.811	48.168
K3	298002.319	5812632.935	48.160


CURVE	RADIUS	ARC L	CHORD	MID ORD	QTR ORD
K1-K2	8.600	13.509	12.162	2.519	-0.655

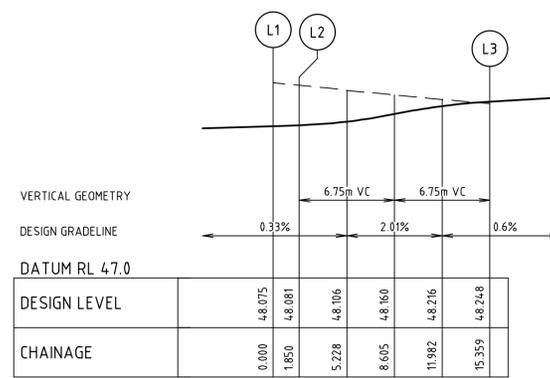

ALIGNMENT L
ALIGNMENT L

POINT NO	EASTING	NORTHING	RL
L1	298027.826	5812630.753	48.075
L2	298025.983	5812630.911	48.081
1/4	298022.648	5812630.539	48.106
1/2	298019.709	5812628.919	48.160
3/4	298017.614	5812626.298	48.216
L3	298016.681	5812623.075	48.248


CURVE	RADIUS	ARC L	CHORD	MID ORD	QTR ORD
L1-L2	8.600	13.509	12.162	2.519	-0.655

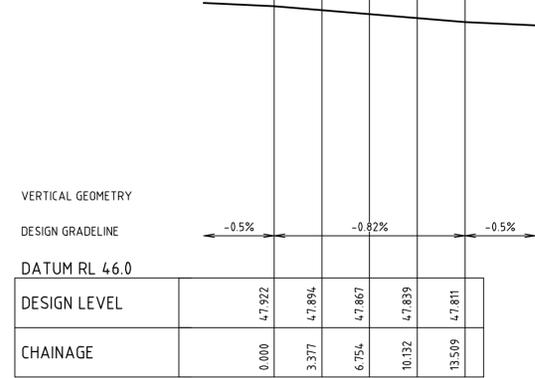

ALIGNMENT M
ALIGNMENT M

POINT NO	EASTING	NORTHING	RL
M1	298157.361	5812610.387	47.922
1/4	298156.990	5812613.722	47.894
1/2	298155.370	5812616.661	47.867
3/4	298152.749	5812618.756	47.839
M2	298149.526	5812619.689	47.811

CURVE	RADIUS	ARC L	CHORD	MID ORD	QTR ORD
M1-M2	8.600	13.509	12.162	2.519	-0.655

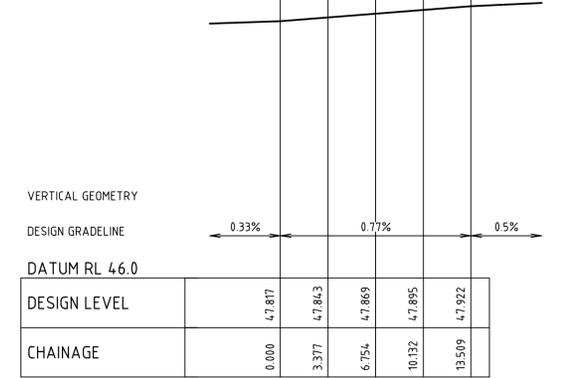


ALIGNMENT N
ALIGNMENT N

POINT NO	EASTING	NORTHING	RL
N1	298173.040	5812617.678	47.817
1/4	298169.705	5812617.306	47.843
1/2	298166.766	5812615.686	47.869
3/4	298164.671	5812613.065	47.895
N2	298163.738	5812609.842	47.922

CURVE	RADIUS	ARC L	CHORD	MID ORD	QTR ORD
N1-N2	8.600	13.509	12.162	2.519	-0.655



Planning and Environment Act 1987
Wyndham Planning Scheme

Approved Plan As Required
under Condition 63
Permit No WYP13902/22
Date 23/07/2025

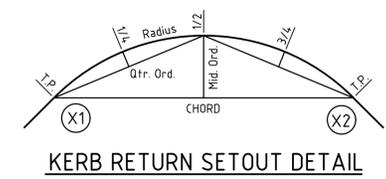



file name: 309443CR501.dwg, layout name: CR501, created by: Thanh Nguyen, file location: \\spiremedia\data\309443\309443.dwg, date: 30/05/2025 4:39 PM, sheet: 14 of 22, sheets:

Rev	ISSUED TO COUNCIL	G.K	04/04/25
Amendments		Approved	Date


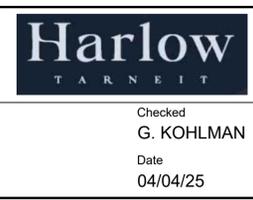
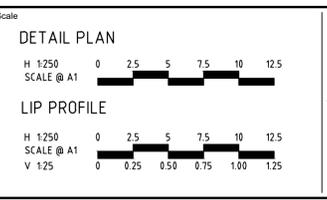


HARLOW ESTATE
STAGE 7
ROAD AND DRAINAGE
INTERSECTION DETAILS - SHEET 2
 WYNDHAM CITY COUNCIL
 SIG GROUP

Drg No
309443CR501
 Rev
A

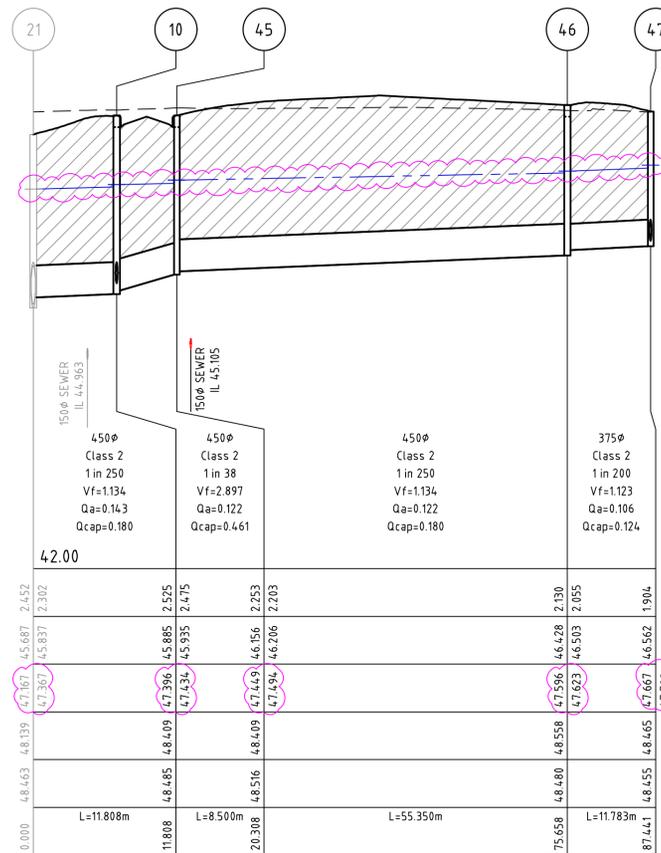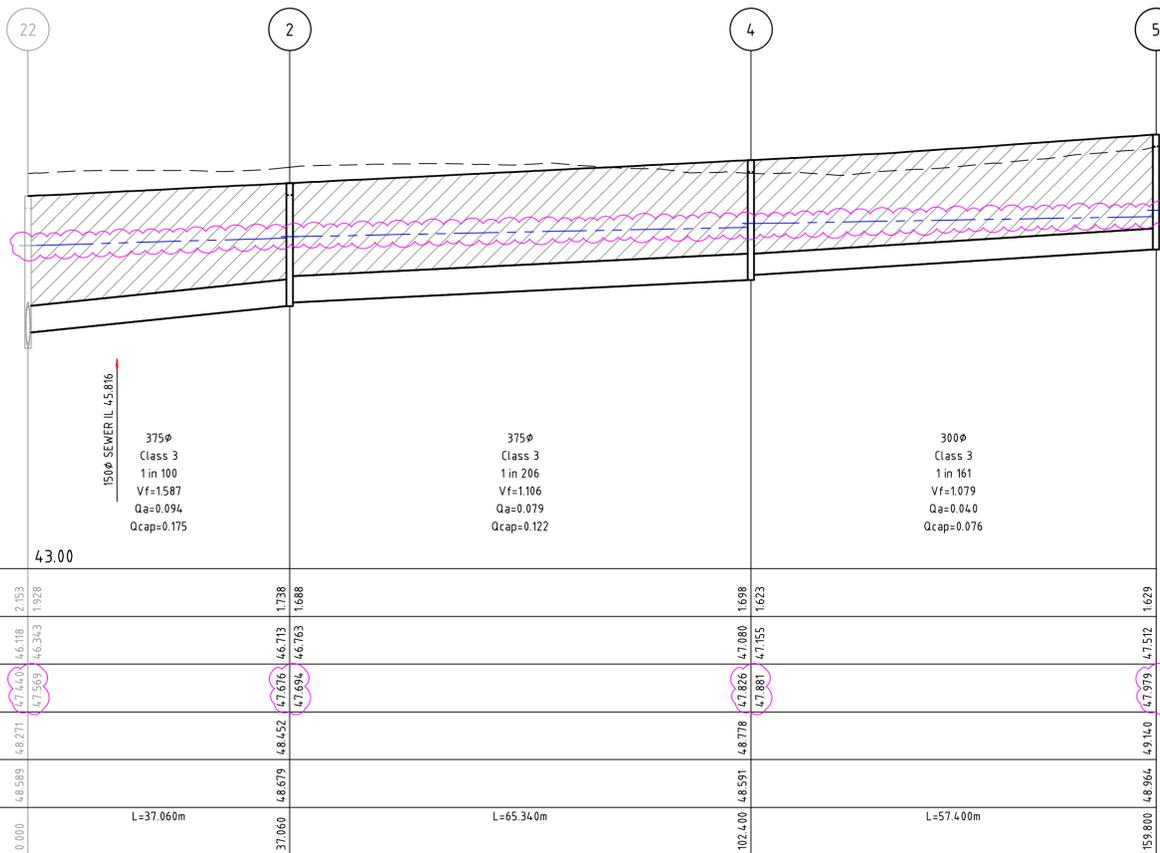


Planning and Environment Act 1987
Wyndham Planning Scheme
Approved Plan As Required
under Condition 63
Permit No WYP13902/22
Date 02/09/2025

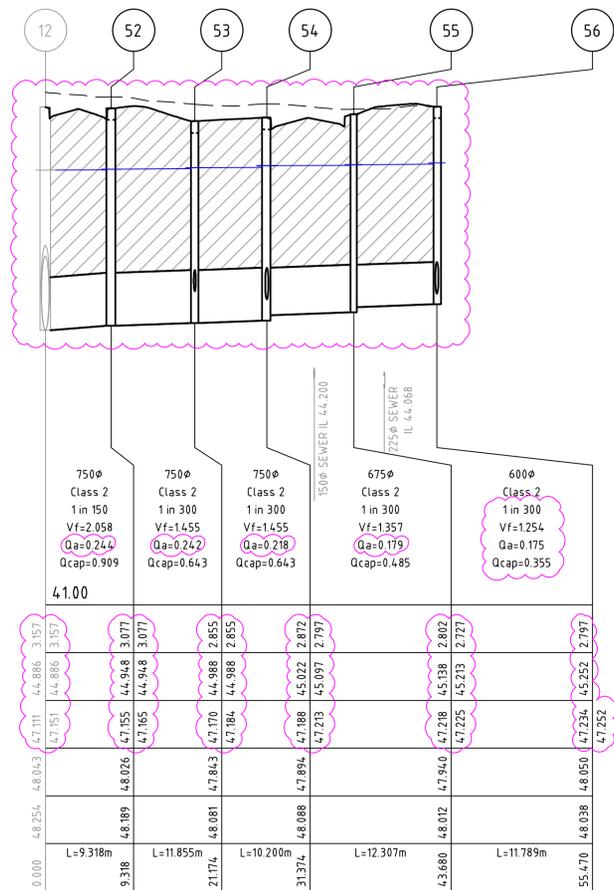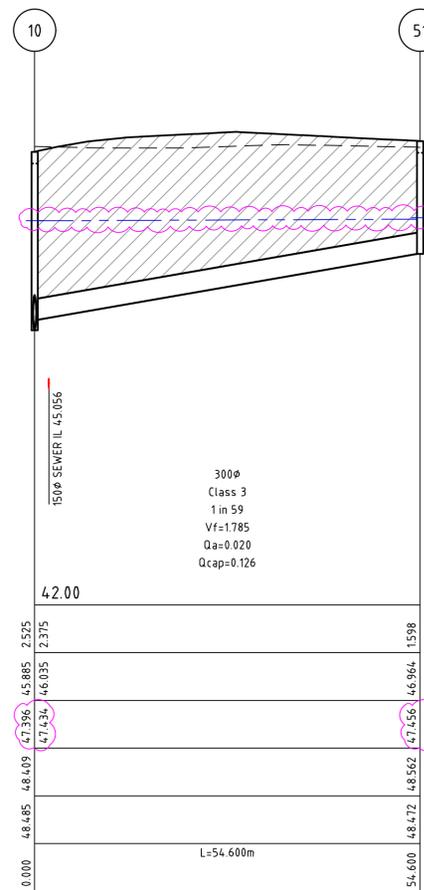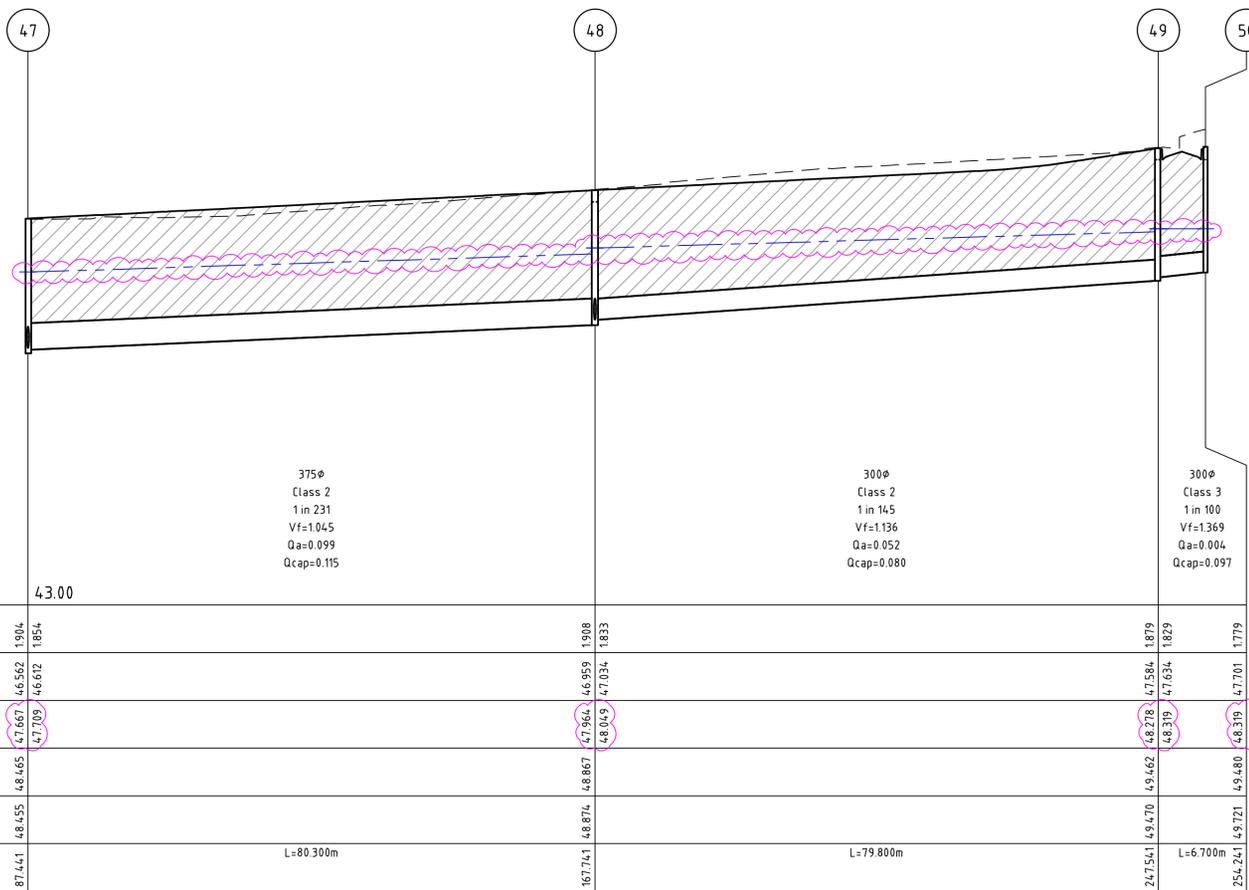

file name: 309443CR600.dwg, layout name: CR600, plot style: Harlow.dwt, plot date: 28/08/2025 5:43 PM, sheet: 15 of 22, sheets: 15


Rev	Amendments	Approved	Date
1	DRAINAGE LONG SECTIONS AMENDED	G.K	05/08/25
0	ISSUED FOR CONSTRUCTION	G.K	29/07/25
B	DRAINAGE LONG SECTIONS AMENDED	G.K	30/05/25
A	ISSUED TO COUNCIL	G.K	04/04/25

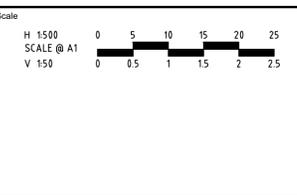

L6 414 LA TROBE STREET PO BOX 16084 MELBOURNE
 VICTORIA 8007 AUSTRALIA T 61 3 9993 7888
 spiire.com.au ABN 55 050 029 635


Designed: T. NGUYEN
 Authorised: G. KOHLMAN
 Checked: G. KOHLMAN
 Date: 04/04/25

HARLOW ESTATE
STAGE 7
ROAD AND DRAINAGE
DRAINAGE LONG SECTIONS - SHEET 1
WYNDHAM CITY COUNCIL
SIG GROUP
CONSTRUCTION Drg No: 309443CR600 Rev: 1

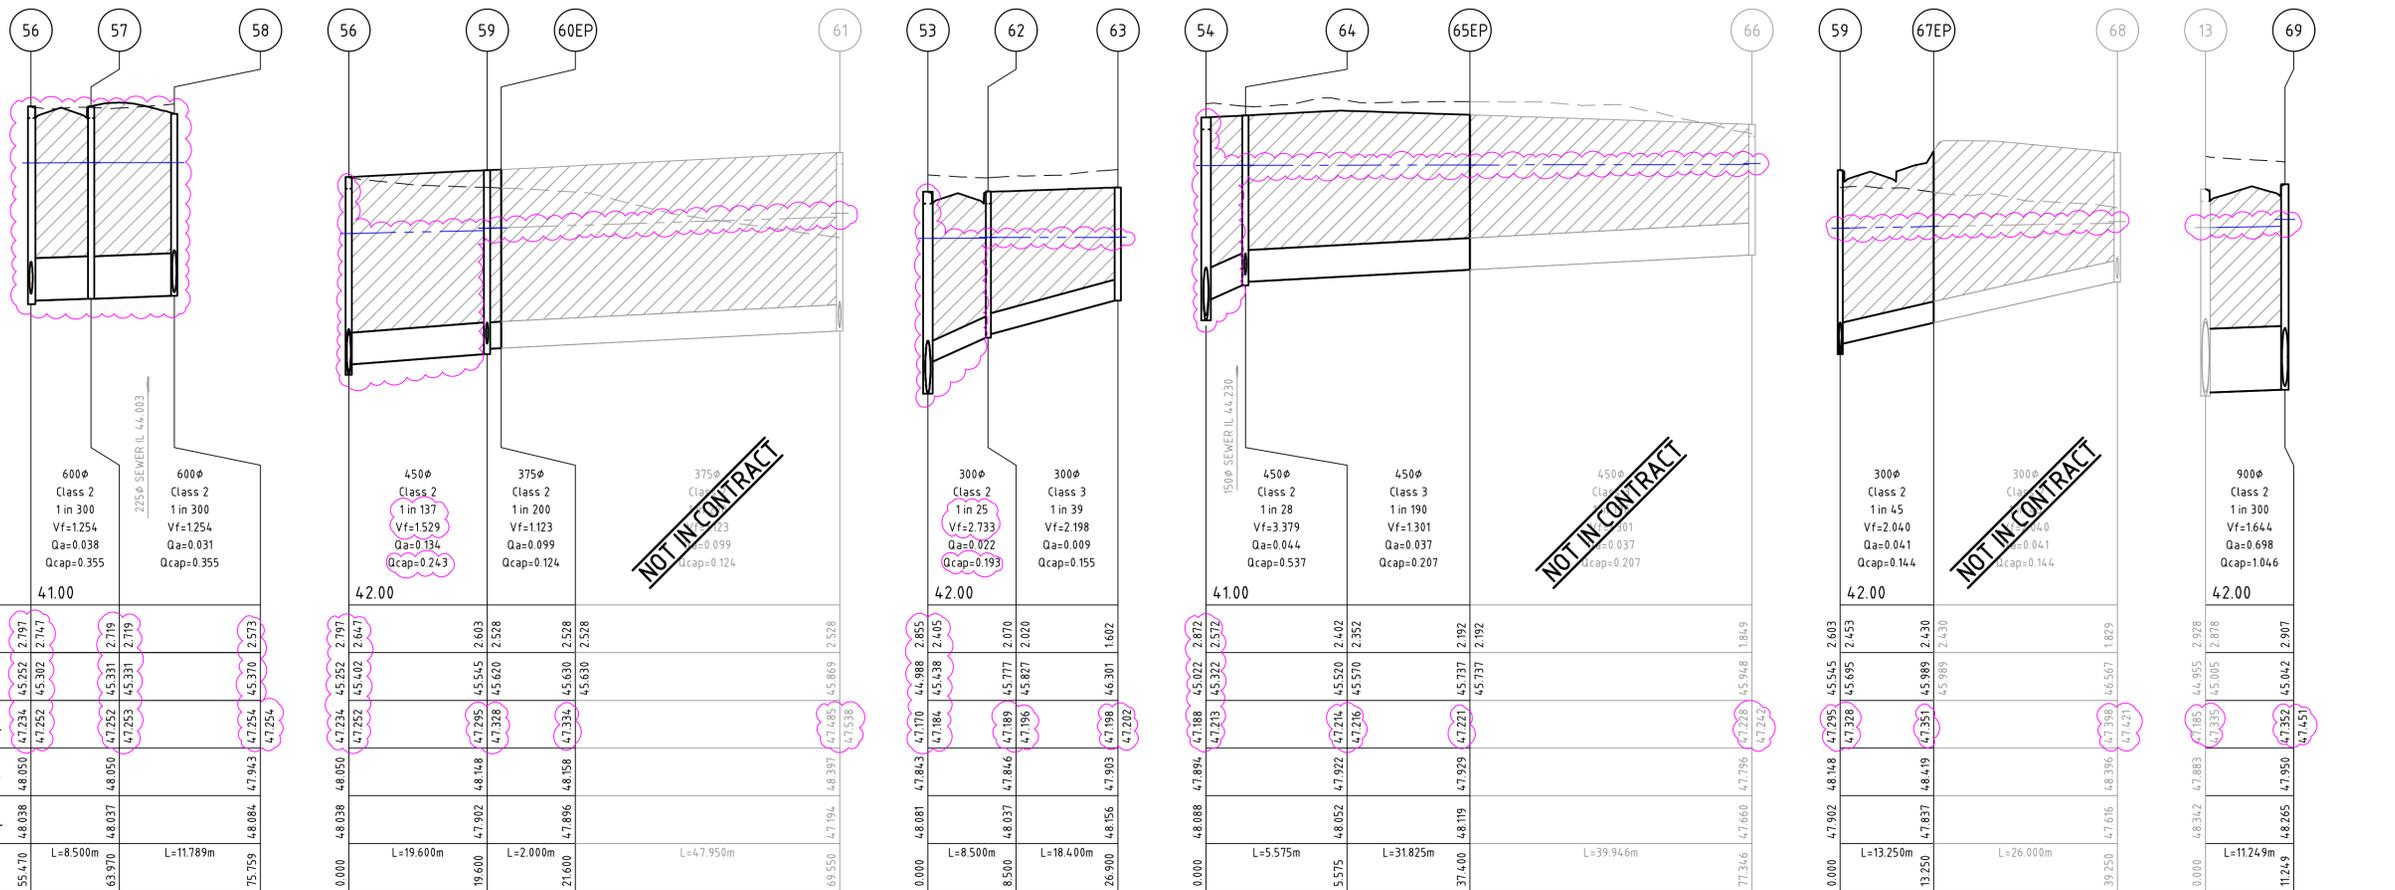


Planning and Environment Act 1987
Wyndham Planning Scheme

Approved Plan As Required
under Condition 63
Permit No WYP13902/22
Date 02/09/2025

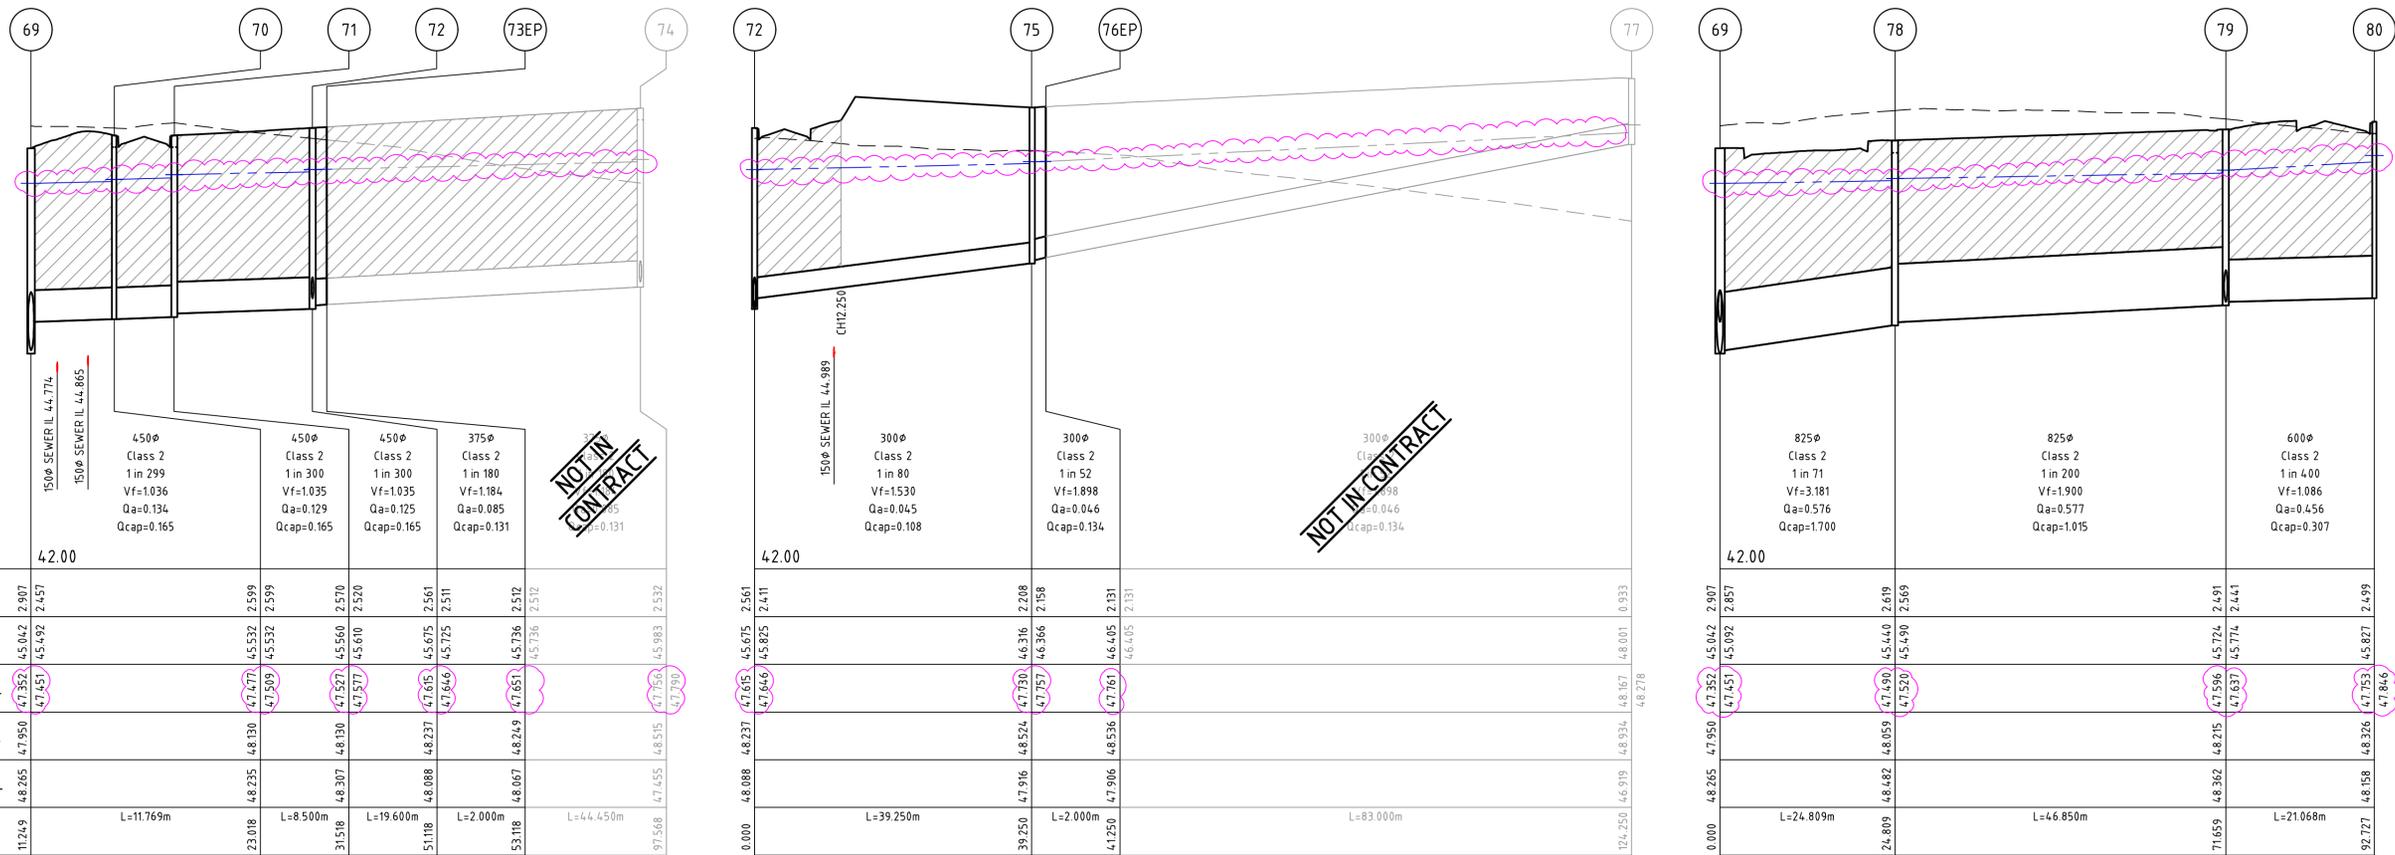

file name: 309443CR601.dwg, layout name: CR601, sheet name: CR601, sheet date: 28/08/2025, 5:44 PM, sheet 16 of 22, sheets

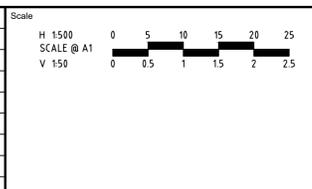

Designed T. NGUYEN	Checked G. KOHLMAN
Authorised G. KOHLMAN	Date 04/04/25


HARLOW ESTATE
STAGE 7
ROAD AND DRAINAGE
DRAINAGE LONG SECTIONS - SHEET 2
WYNDHAM CITY COUNCIL
SIG GROUP

CONSTRUCTION Dwg No **309443CR601** Rev **1**



Pipe Diameter
Pipe Class
Pipe Grade
Velocity (m/s)
Pipe Flow (m3/s)
Pipe Capacity (m3/s)

DATUM	42.00
DEPTH TO INVERT	2.499 2.449 2.586
DESIGN INVERT LEVEL	45.827 45.877 45.890
HYDRAULIC GRADE LEVEL	47.753 47.846 47.851
FINISHED SURFACE LEVEL	48.376 48.476
EXISTING SURFACE LEVEL	48.158 48.136
CHAINAGE	L=5.100m 97.827

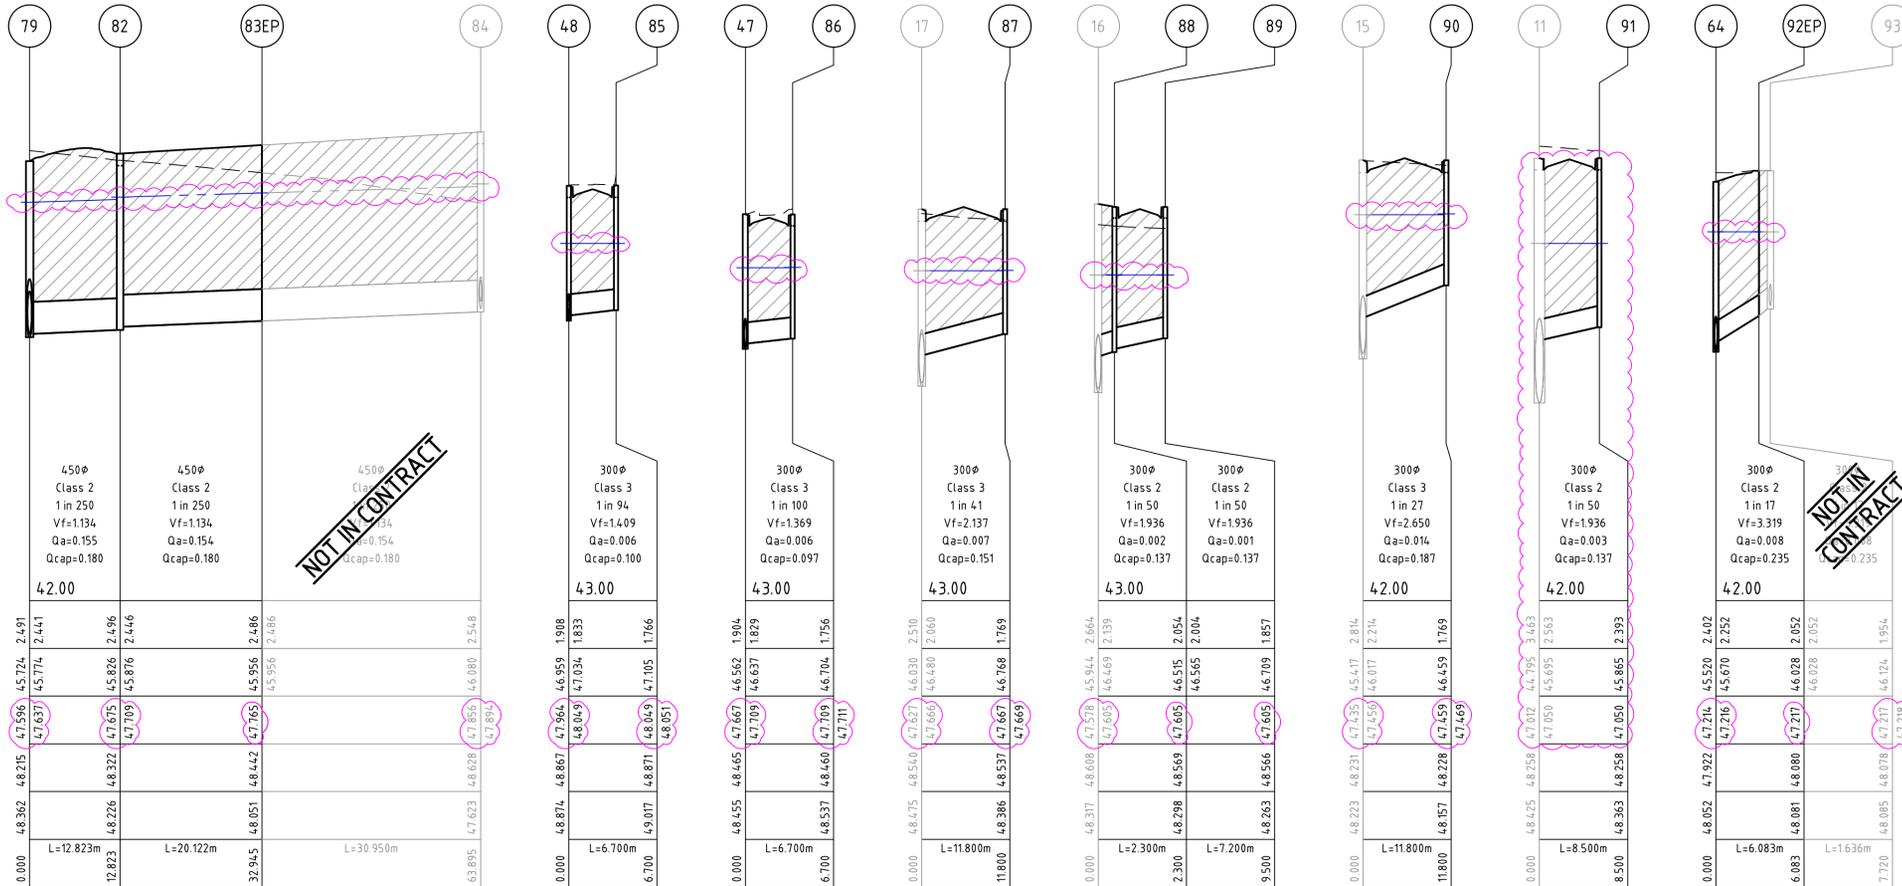

NOT IN CONTRACT

NOT IN CONTRACT




**Planning and Environment Act 1987
Wyndham Planning Scheme**

**Approved Plan As Required
under Condition 63
Permit No WYP13902/22
Date 02/09/2025**

file name: 309443CR602.dwg, layout name: CR602, plotted by: Thanh Nguyen, file location: G:\309443\309443\CAD\CAD plot date: 28/08/2025 5:44 PM, Sheet: 17 of 22, Sheets

Rev	Amendments	Approved	Date
1	DRAINAGE LONG SECTIONS AMENDED	G.K	05/08/25
0	ISSUED FOR CONSTRUCTION	G.K	29/07/25
B	DRAINAGE LONG SECTIONS AMENDED	G.K	30/05/25
A	ISSUED TO COUNCIL	G.K	04/04/25

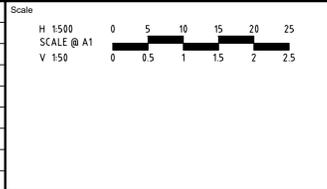

System Certified

© Spiire Australia Pty Ltd All Rights Reserved
 This document is produced by Spiire Australia Pty Ltd solely for the benefit of and use by the client in accordance with the terms of the retainer. Spiire Australia Pty Ltd does not and shall not assume any responsibility or liability whatsoever to any third party arising out of any use or reliance by third party on the content of this document.

L6 414 LA TROBE STREET PO BOX 16084 MELBOURNE
 VICTORIA 8007 AUSTRALIA T 61 3 9993 7888
 spiire.com.au ABN 55 050 029 635

Designed
T. NGUYEN

 Authorised
G. KOHLMAN

 Checked
G. KOHLMAN

 Date
04/04/25

**HARLOW ESTATE
 STAGE 7
 ROAD AND DRAINAGE
 DRAINAGE LONG SECTIONS - SHEET 3
 WYNDHAM CITY COUNCIL
 SIG GROUP**

CONSTRUCTION

Drg No **309443CR602**

Rev **1**

DRAINAGE PIT SCHEDULE

PIT NAME	PIT TYPE	INTERNAL		INLET		OUTLET		PIT		REMARKS
		WIDTH	LENGTH	DIA	INV LEVEL	DIA	INV LEVEL	FS LEVEL	DEPTH	
11	GRATED SIDE ENTRY PIT	1500	900	300	45.695	1200	44.795	48.258	3.463	CONVERT TO GSEP. REFER TO EDCM STANDARD DRAWING 601
12	JUNCTION PIT	1650	1500	750	44.886	1200	44.886	48.043	3.157	
13	GRATED SIDE ENTRY PIT	1650	1650	900	45.005	1050	44.955	47.883	2.928	CONVERT TO GSEP. REFER TO EDCM STANDARD DRAWING 601
14	GRATED SIDE ENTRY PIT	1350	900	900	45.170	1050	45.120	47.985	2.864	CONVERT TO GSEP. REFER TO EDCM STANDARD DRAWING 601
15	GRATED SIDE ENTRY PIT	1050	900	300	46.017	900	45.417	48.231	2.814	CONVERT TO GSEP. REFER TO EDCM STANDARD DRAWING 601
16	JUNCTION PIT	1050	900	300	46.469	825	45.944	48.608	2.664	
17	GRATED SIDE ENTRY PIT	1050	900	300	46.480	750	46.030	48.540	2.510	CONVERT TO GSEP. REFER TO EDCM STANDARD DRAWING 601
21	JUNCTION PIT	900	900	450	45.837	600	45.687	48.139	2.452	
22	GRATED SIDE ENTRY PIT	900	900	375	46.343	600	46.118	48.271	2.153	CONVERT TO GSEP. REFER TO EDCM STANDARD DRAWING 601
23	GRATED SIDE ENTRY PIT	750	900	525	46.274	600	46.199	48.271	2.072	CONVERT TO GSEP. REFER TO EDCM STANDARD DRAWING 601
24	GRATED SIDE ENTRY PIT	750	900	525	46.461	525	46.411	48.452	2.041	CONVERT TO GSEP. REFER TO EDCM STANDARD DRAWING 601
25	GRATED SIDE ENTRY PIT	750	900	525	46.743	525	46.693	48.799	2.106	CONVERT TO GSEP. REFER TO EDCM STANDARD DRAWING 601
2	GRATED SIDE ENTRY PIT	600	900	375	46.763	375	46.713	48.452	1.738	REFER TO EDCM STANDARD DRAWING 601 & 605
4	GRATED SIDE ENTRY PIT	600	900	300	47.155	375	47.080	48.778	1.698	REFER TO EDCM STANDARD DRAWING 601 & 605
5	GRATED SIDE ENTRY PIT	600	900			300	47.512	49.140	1.629	REFER TO EDCM STANDARD DRAWING 601 & 605
10	GRATED SIDE ENTRY PIT	900	900	450	45.935	450	45.885	48.409	2.525	REFER TO EDCM STANDARD DRAWING 601 & 607. TO BE HAUNCHED UNDER ROAD
				300	46.035					
45	GRATED SIDE ENTRY PIT	750	900	450	46.206	450	46.156	48.409	2.253	REFER TO EDCM STANDARD DRAWING 601 & 607
46	GRATED SIDE ENTRY PIT	750	900	375	46.503	450	46.428	48.558	2.130	REFER TO EDCM STANDARD DRAWING 601 & 607
47	JUNCTION PIT	750	900	375	46.612	375	46.562	48.465	1.904	REFER TO EDCM STANDARD DRAWING 607
				300	46.637					
48	GRATED SIDE ENTRY PIT	600	900	300	47.034	375	46.959	48.867	1.908	REFER TO EDCM STANDARD DRAWING 601 & 605
				300	47.034					
49	GRATED SIDE ENTRY PIT	600	900	300	47.634	300	47.584	49.462	1.879	REFER TO EDCM STANDARD DRAWING 601 & 605
50	GRATED SIDE ENTRY PIT	600	900			300	47.701	49.480	1.779	REFER TO EDCM STANDARD DRAWING 601 & 605
51	GRATED SIDE ENTRY PIT	600	900			300	46.964	48.562	1.598	REFER TO EDCM STANDARD DRAWING 601 & 605
52	GRATED SIDE ENTRY PIT	1350	1200	750	44.948	750	44.948	48.026	3.077	REFER TO EDCM STANDARD DRAWING 601 & 607. TO BE HAUNCHED UNDER ROAD
53	GRATED SIDE ENTRY PIT	1350	1050	750	44.988	750	44.988	47.843	2.855	REFER TO EDCM STANDARD DRAWING 601 & 607. TO BE HAUNCHED UNDER ROAD
				300	45.438					
54	GRATED SIDE ENTRY PIT	1050	1350	675	45.097	750	45.022	47.894	2.872	REFER TO EDCM STANDARD DRAWING 601 & 607. TO BE HAUNCHED UNDER ROAD
				450	45.322					
55	JUNCTION PIT	1350	900	600	45.213	675	45.138	47.940	2.802	REFER TO EDCM STANDARD DRAWING 607. TO BE HAUNCHED UNDER ROAD
56	GRATED SIDE ENTRY PIT	1200	900	600	45.302	600	45.252	48.050	2.797	REFER TO EDCM STANDARD DRAWING 601 & 607. TO BE HAUNCHED UNDER ROAD
				450	45.402					
57	GRATED SIDE ENTRY PIT	600	1200	600	45.331	600	45.331	48.050	2.719	REFER TO EDCM STANDARD DRAWING 601 & 607
58	JUNCTION PIT	900	1200	600	45.370	600	45.370	47.943	2.573	REFER TO EDCM STANDARD DRAWING 607
				600	45.420					
59	JUNCTION PIT	750	900	375	45.620	450	45.545	48.148	2.603	REFER TO EDCM STANDARD DRAWING 607. TO BE HAUNCHED UNDER ROAD
				300	45.695					
62	JUNCTION PIT	600	900	300	45.827	300	45.777	47.846	2.070	REFER TO EDCM STANDARD DRAWING 605
63	JUNCTION PIT	600	900			300	46.301	47.903	1.602	REFER TO EDCM STANDARD DRAWING 605
64	JUNCTION PIT	750	900	450	45.570	450	45.520	47.922	2.402	REFER TO EDCM STANDARD DRAWING 607. PROVIDE CLASS D HEAVY DUTY COVER. TO BE HAUNCHED UNDER ROAD
				300	45.670					
69	JUNCTION PIT	1050	1650	450	45.492	900	45.042	47.950	2.907	REFER TO EDCM STANDARD DRAWING 607. TO BE HAUNCHED UNDER ROAD
				825	45.092					
70	GRATED SIDE ENTRY PIT	600	900	450	45.532	450	45.532	48.130	2.599	REFER TO EDCM STANDARD DRAWING 601 & 605
71	GRATED SIDE ENTRY PIT	750	900	450	45.610	450	45.560	48.130	2.570	REFER TO EDCM STANDARD DRAWING 601 & 607
72	JUNCTION PIT	750	900	375	45.725	450	45.675	48.237	2.561	REFER TO EDCM STANDARD DRAWING 607. TO BE HAUNCHED UNDER ROAD
				300	45.825					
75	JUNCTION PIT	600	900	300	46.366	300	46.316	48.524	2.208	REFER TO EDCM STANDARD DRAWING 605
78	GRATED SIDE ENTRY PIT	1050	900	825	45.490	825	45.440	48.059	2.619	REFER TO EDCM STANDARD DRAWING 601 & 607
79	JUNCTION PIT	1050	900	600	45.774	825	45.724	48.215	2.491	REFER TO EDCM STANDARD DRAWING 607
				450	45.774					
80	GRATED SIDE ENTRY PIT	1050	600	825	45.877	600	45.827	48.326	2.499	REFER TO EDCM STANDARD DRAWING 601 & 607. PIT LID TO BE GRATED.
82	GRATED SIDE ENTRY PIT	750	900	450	45.876	450	45.826	48.322	2.496	REFER TO EDCM STANDARD DRAWING 601 & 605
85	GRATED SIDE ENTRY PIT	600	900			300	47.105	48.871	1.766	REFER TO EDCM STANDARD DRAWING 601 & 605
86	GRATED SIDE ENTRY PIT	600	900			300	46.704	48.460	1.756	REFER TO EDCM STANDARD DRAWING 601 & 605
87	GRATED SIDE ENTRY PIT	600	900			300	46.768	48.537	1.769	REFER TO EDCM STANDARD DRAWING 601 & 605
88	GRATED SIDE ENTRY PIT	600	900	300	46.565	300	46.515	48.569	2.054	REFER TO EDCM STANDARD DRAWING 601 & 605. PROVIDE CLASS D HEAVY DUTY COVER
89	GRATED SIDE ENTRY PIT	600	900			300	46.709	48.566	1.857	REFER TO EDCM STANDARD DRAWING 601 & 605
90	GRATED SIDE ENTRY PIT	600	900			300	46.459	48.228	1.769	REFER TO EDCM STANDARD DRAWING 601 & 605
91	GRATED SIDE ENTRY PIT	600	900			300	45.865	48.258	2.393	REFER TO EDCM STANDARD DRAWING 601 & 605





NOTE: ALL HAUNCHED PITS TO BE HAUNCHED UNDER NATURE STRIP UNLESS SPECIFIED IN PIT SCHEDULE

PIT SETOUT CO-ORDINATES

NAME	POINT	EASTING	NORTHING
60EP	B	298154.423	5812588.358
65EP	B	298174.870	5812624.998
67EP	B	298167.795	5812589.221
73EP	B	298078.699	5812594.836
75	A	298117.977	5812593.483
76EP	B	298117.807	5812591.490
81EP	B	298002.862	5812620.515
83EP	B	298018.071	5812600.023
92EP	B	298151.002	5812631.515


Planning and Environment Act 1987
Wyndham Planning Scheme

Approved Plan As Required
under Condition 63
Permit No WYP13902/22
Date 02/09/2025

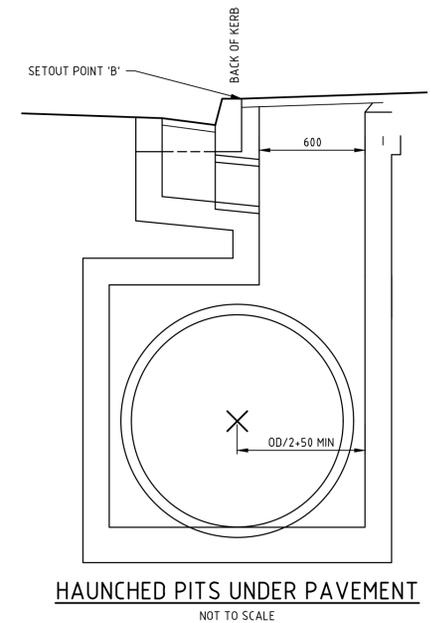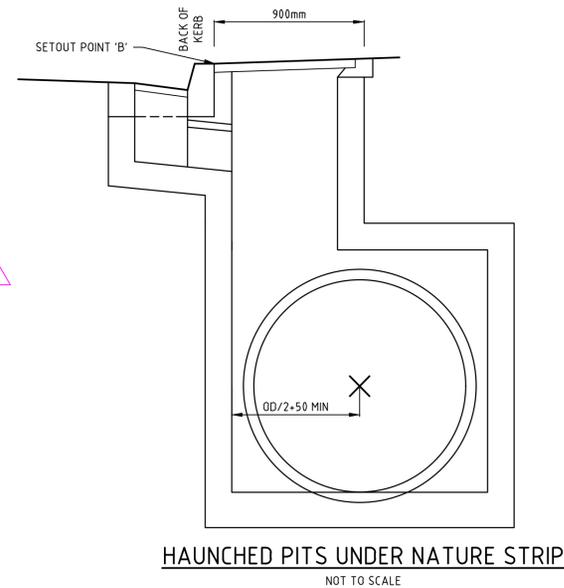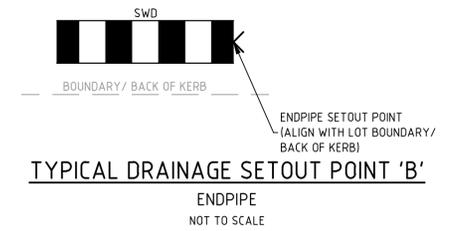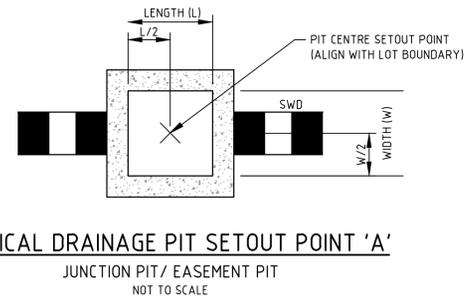

file name: 309443CR603.dwg, layout name: CR603, plot date: 28/08/2025, 5:44 PM, sheet 18 of 22 sheets

Rev	Amendments	Approved	Date
2	DRAINAGE PIT SCHEDULE AMENDED	G.K	21/08/25
1	DRAINAGE PIT SCHEDULE AMENDED	G.K	05/08/25
0	ISSUED FOR CONSTRUCTION	G.K	29/07/25
B	DRAINAGE PIT SCHEDULE AMENDED	G.K	30/05/25
A	ISSUED TO COUNCIL	G.K	04/04/25

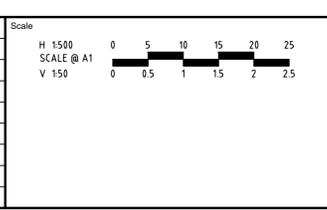

ISO 9001
ISO 45001
ISO 14001
System Certified

© Spiire Australia Pty Ltd All Rights Reserved
This document is produced by Spiire Australia Pty Ltd solely for the benefit of and use by the client in accordance with the terms of the retainer. Spiire Australia Pty Ltd does not and shall not assume any responsibility or liability whatsoever to any third party arising out of any use or reliance by third party on the content of this document.

spiire

L6 414 LA TROBE STREET PO BOX 16084 MELBOURNE
VICTORIA 3007 AUSTRALIA T 61 3 9993 7888
spiire.com.au ABN 55 050 029 635

Harlow
TARNETT

Designed
T. NGUYEN

Checked
G. KOHLMAN

Authorised
G. KOHLMAN

Date
04/04/25

**HARLOW ESTATE
STAGE 7
ROAD AND DRAINAGE
DRAINAGE PIT SCHEDULE
WYNDHAM CITY COUNCIL
SIG GROUP**

CONSTRUCTION Drg No 309443CR603 Rev 2

DESIGN PAVEMENT PROFILE

PAVEMENT LAYER	DESCRIPTION	DEPTH (mm)
		TYPE A
ASPHALT WEARING COURSE	SIZE 10 TYPE N C320	30
ASPHALT BASE COURSE	SIZE 10 TYPE N C320	30
PRIMECOAT	PRIME & 10mm SAMI (S 18RF)	10
BASE COURSE	VICROADS CLASS 2 FCR (20mm)	130
UPPER SUBBASE	VICROADS CLASS 3 FCR (20mm)	120
LOWER SUBBASE	VICROADS CLASS 3 FCR (20mm)	120
CAPPING LAYER	VICROADS TYPE A CAPPING LAYER OR APPROVED ALTERNATIVE AS PER TABLE 5 (CBR _R 10%, S _{WELL} <1.5%, K<5X10 ⁻⁹ m/sec)	150
CONSTRUCTION LAYER	VICROADS TYPE A CAPPING LAYER OR APPROVED ALTERNATIVE AS PER TABLE 5 (CBR _R 10%, S _{WELL} <1.5%, K<5X10 ⁻⁹ m/sec)	150
TOTAL PAVEMENT DEPTH		740



ROAD NAME	TYPE
TURMERIC STREET	ACCESS STREET LEVEL 1
DAYLILY ROAD	ACCESS STREET LEVEL 1
JIRA CRESCENT	ACCESS STREET LEVEL 1
LILUUM WAY	ACCESS STREET LEVEL 1
LUMPINI ROAD	ACCESS STREET LEVEL 1
SALVIAS ROAD	ACCESS STREET LEVEL 1
SPRINGFALL ROAD	ACCESS STREET LEVEL 1
TEASEL WAY	ACCESS STREET LEVEL 1

PAVEMENT DETAILS CBR 2.0%

NOTES:
1. SUBGRADE TO CONSIST OF UNIT 3 NATURAL RESIDUAL CLAYS OR CONTROLLED (ENGINEERED) FILL (CBR_R≥2.0%)

**Planning and Environment Act 1987
Wyndham Planning Scheme**

**Approved Plan As Required
under Condition 63
Permit No WYP13902/22
Date 02/09/2025**

PAVEMENT DETAILS

THE PAVEMENT DESIGNS SHOWN HERE HAVE BEEN DESIGNED/PROVIDED BY GROUND SCIENCE PTY LTD WHO ARE RESPONSIBLE FOR THE GEOTECHNICAL WORK ON THIS PROJECT. SPIIRE IS NOT RESPONSIBLE FOR THE WORK OF GROUND SCIENCE PTY LTD.

THE DESIGN HAS BEEN EXTRACTED FROM THE "GEOTECHNICAL INVESTIGATION" REPORT ON "GEOTECHNICAL INVESTIGATION FOR 860 DERRIMUT ROAD, TARNEIT (DATED 18 OCTOBER 2021, REPORT REFERENCE G45721 AA)" THIS DOCUMENT SHOULD BE REVIEWED TO ENSURE THAT THE DESIGN HAS BEEN ACCURATELY REPRODUCED.


A COPY OF THE DOCUMENT WILL BE PROVIDED ON REQUEST.

SPIIRE DOES NOT ACCEPT ANY RESPONSIBILITY FOR THE ACCURACY, ADEQUACY OR APPROPRIATENESS OF THE GEOTECHNICAL WORK AND PAVEMENT DESIGNS. ANY QUERIES IN RESPECT TO THE GEOTECHNICAL WORK AND PAVEMENT DESIGNS SHOULD BE ADDRESSED TO GROUND SCIENCE PTY LTD AND COPIED TO SPIIRE.




PAVEMENT PLAN


H 1:1000
SCALE @ A1

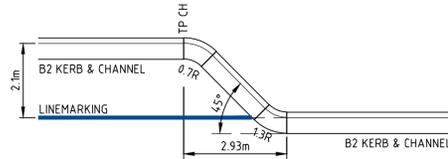


TYPICAL PARKING BAY DETAIL
NOT TO SCALE

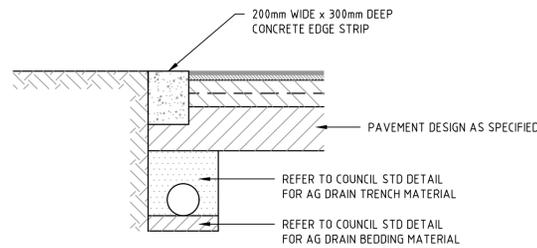


LIMIT OF WORKS CONCRETE EDGE STRIP & PAVEMENT INTERFACE DETAIL

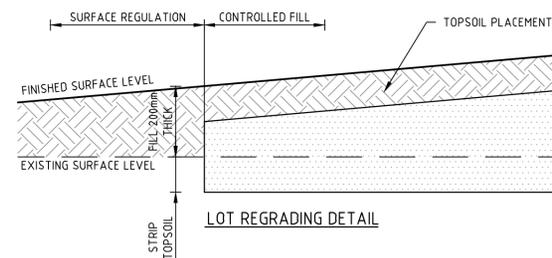

LOT REGRADING DETAIL

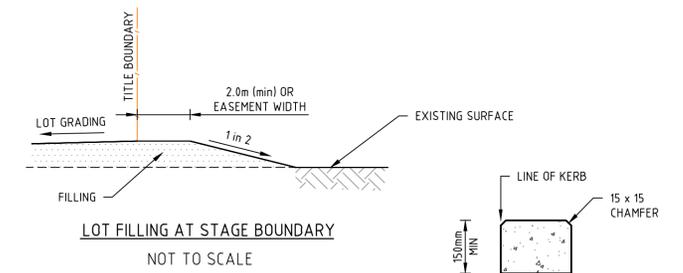


LOT FILLING AT STAGE BOUNDARY
NOT TO SCALE

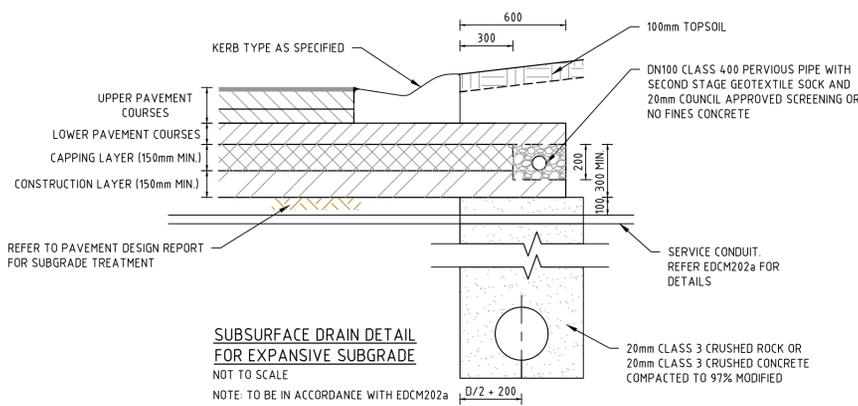


SUBSURFACE DRAIN DETAIL FOR EXPANSIVE SUBGRADE
NOT TO SCALE


NOTE: TO BE IN ACCORDANCE WITH EDM202a

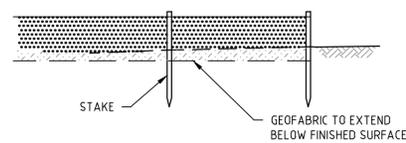


SILT CONTROL FOR LOTS
GEOFABRIC SILT FENCE

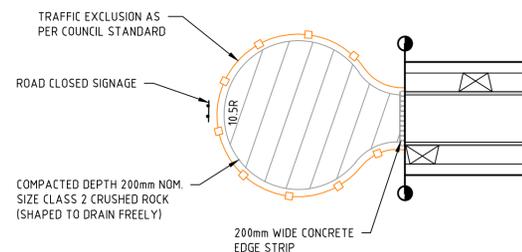

TEMPORARY TURNING AREA DETAIL

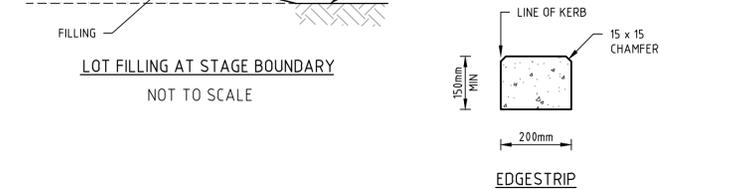

EDGESTRIP

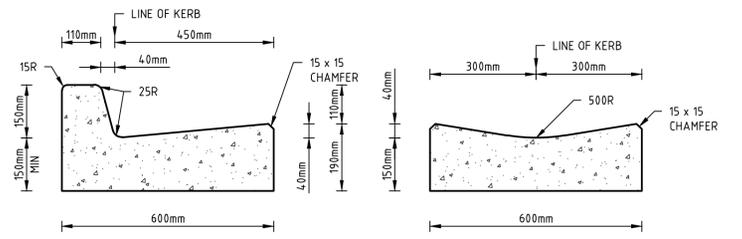

INVERT CHANNEL
(FOR SM2 OR B2)

STANDARD KERB PROFILES

NOTE: ALL KERB & CHANNEL AS PER EDM STD DRAWING EDM 301

H 1:100
SCALE @ A1

file name: 309443CR700.dwg, location: harlow, project name: CR700, plot title: 28/08/2025 5:44 PM Sheet: 19 of 22 Sheets, file location: \\spiiremedia\share\309443\309443.dwg

Rev	Amendments	Approved	Date
2	LOWER SUBBASE PAVEMENT LAYER AMENDED	G.K	28/08/25
1	ROAD NAME AMENDED	G.K	21/08/25
0	ISSUED FOR CONSTRUCTION	G.K	29/07/25
A	ISSUED TO COUNCIL	G.K	04/04/25

System Certified

© Spiire Australia Pty Ltd All Rights Reserved
This document is produced by Spiire Australia Pty Ltd solely for the benefit of and use by the client in accordance with the terms of the retainer. Spiire Australia Pty Ltd does not and shall not assume any responsibility or liability whatsoever to any third party arising out of any use or reliance by third party on the content of this document.

L6 414 LA TROBE STREET PO BOX 16084 MELBOURNE
VICTORIA 8007 AUSTRALIA T 61 3 9993 7888
spiire.com.au ABN 55 050 029 635

Designed
T. NGUYEN


Authorised
G. KOHLMAN

Checked
G. KOHLMAN

Date
04/04/25


**HARLOW ESTATE
STAGE 7
ROAD AND DRAINAGE
PAVEMENT AND TYPICAL DETAILS**
WYNDHAM CITY COUNCIL
SIG GROUP

CONSTRUCTION Drg No **309443CR700** Rev **2**

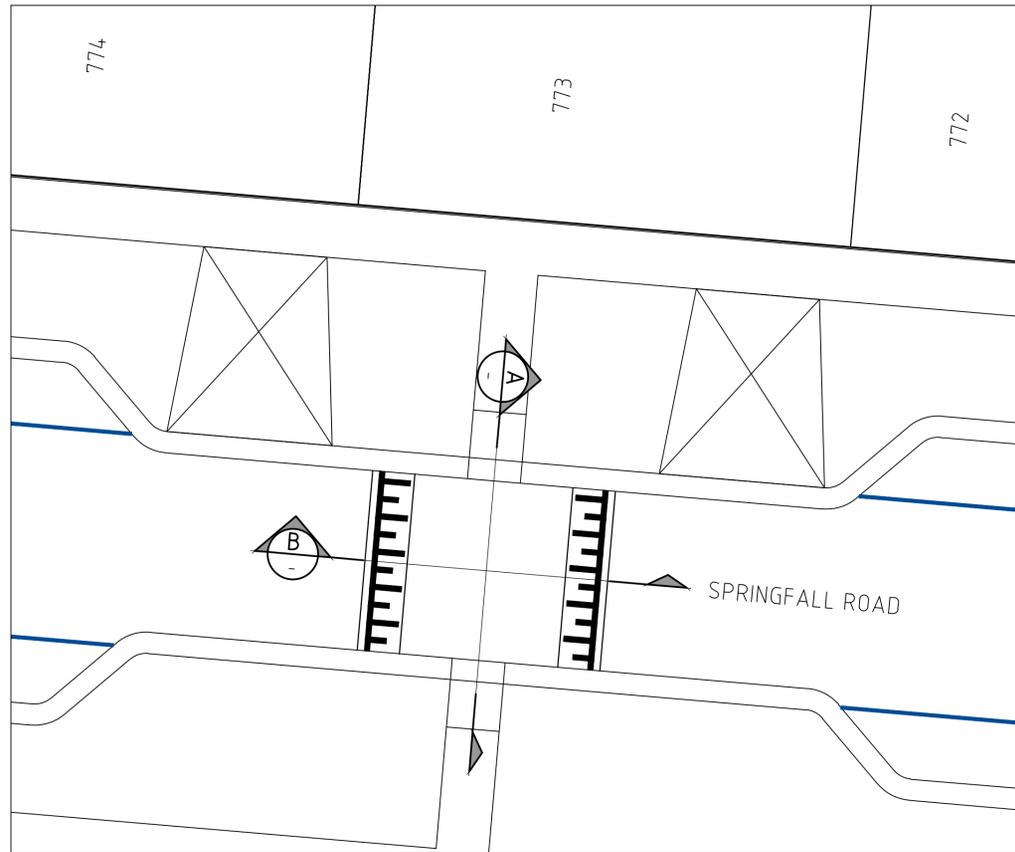

RAISED PAVEMENT PEDESTRIAN CROSSING

H 1:100
SCALE @ A1




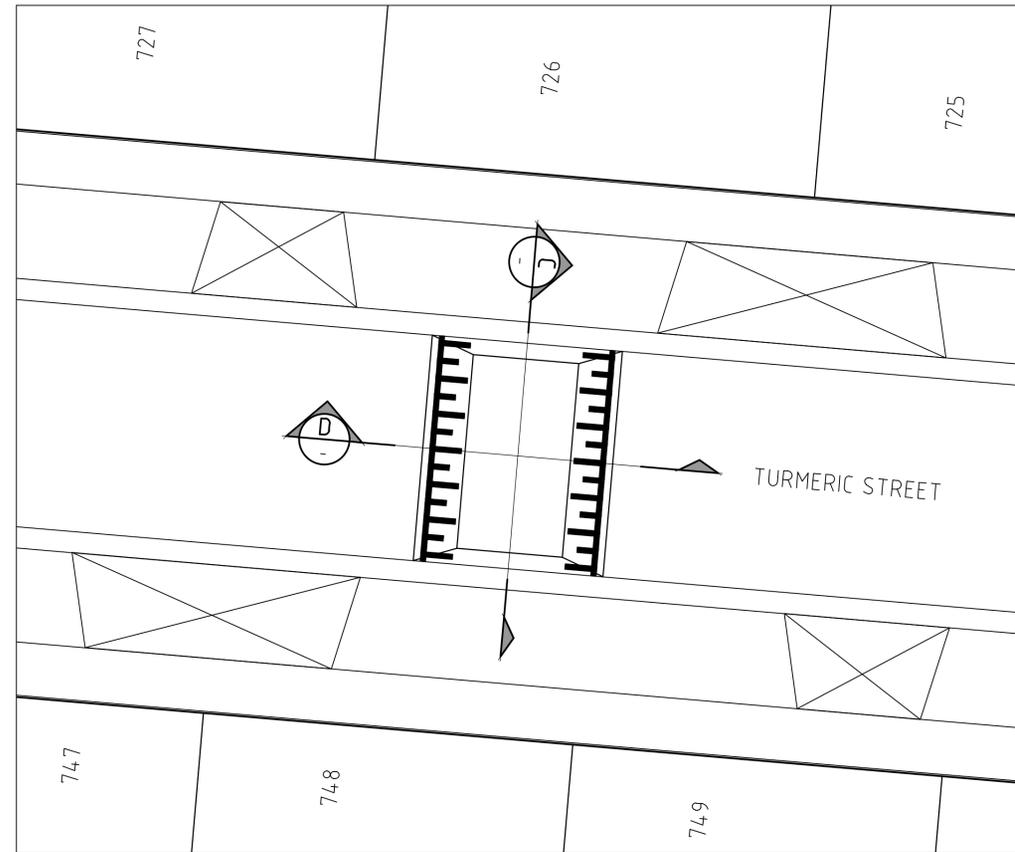


RAISED PAVEMENT FLAT TOP

H 1:100
SCALE @ A1

Planning and Environment Act 1987
Wyndham Planning Scheme

Approved Plan As Required
under Condition 63
Permit No WYP13902/22
Date 02/09/2025

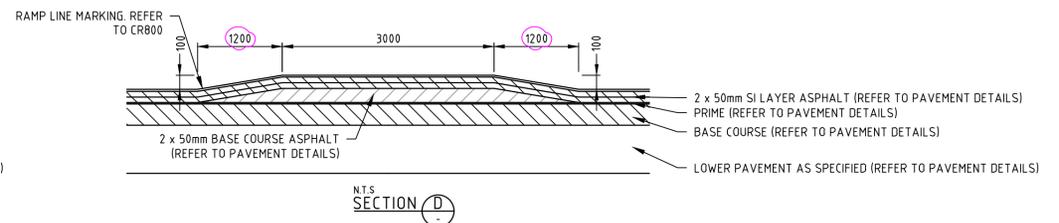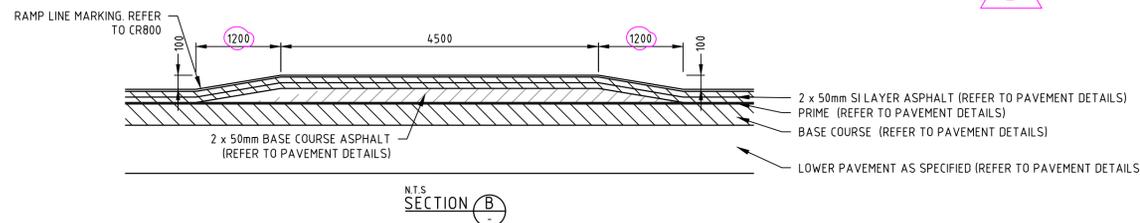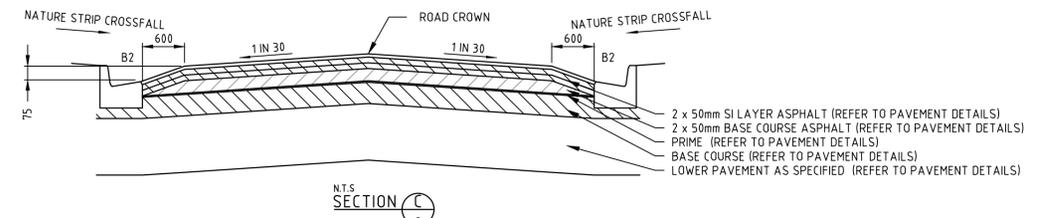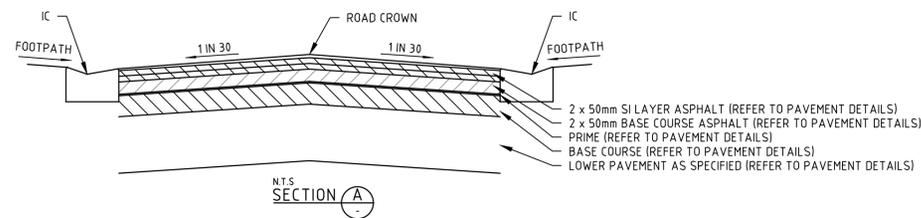

2

file name: 309443CR701.dwg, layout name: CP701, plotted by: Thanh Nguyen, file location: G:\309443\309443\CAD\CAD plot date: 28/08/2025 5:44 PM, Sheet: 20 of 22, Sheets

Rev	Amendments	Approved	Date
2	RAISED PAVEMENT RAMP WIDTH AMENDED	G.K	28/08/25
1	ROAD NAME AMENDED	G.K	21/08/25
0	ISSUED FOR CONSTRUCTION	G.K	29/07/25
B	NOTES AMENDED	G.K	30/05/25
A	ISSUED TO COUNCIL	G.K	04/04/25

System Certified

© Spiire Australia Pty Ltd All Rights Reserved
 This document is produced by Spiire Australia Pty Ltd solely for the benefit of and use by the client in accordance with the terms of the retainer. Spiire Australia Pty Ltd does not and shall not assume any responsibility or liability whatsoever to any third party arising out of any use or reliance by third party on the content of this document.

L6 414 LA TROBE STREET PO BOX 16084 MELBOURNE
 VICTORIA 3007 AUSTRALIA T 61 3 9993 7888
 spiire.com.au ABN 55 050 029 635


Designed
 T. NGUYEN
 Authorised
 G. KOHLMAN

Checked
 G. KOHLMAN
 Date
 04/04/25

HARLOW ESTATE
STAGE 7
ROAD AND DRAINAGE
RAISED PAVEMENT DETAILS - SHEET 1
 WYNDHAM CITY COUNCIL
 SIG GROUP


Drg No
CONSTRUCTION 309443CR701

Rev
2

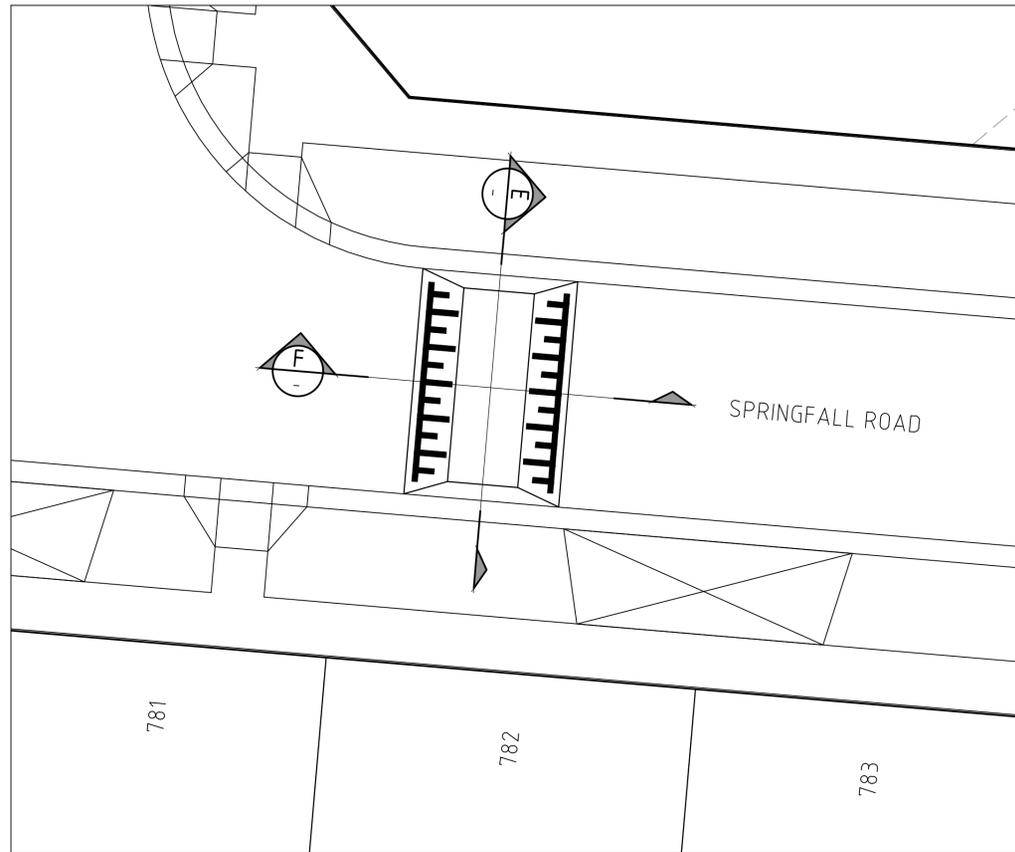





RAISED PAVEMENT FLAT TOP

H 1:100
SCALE @ A1

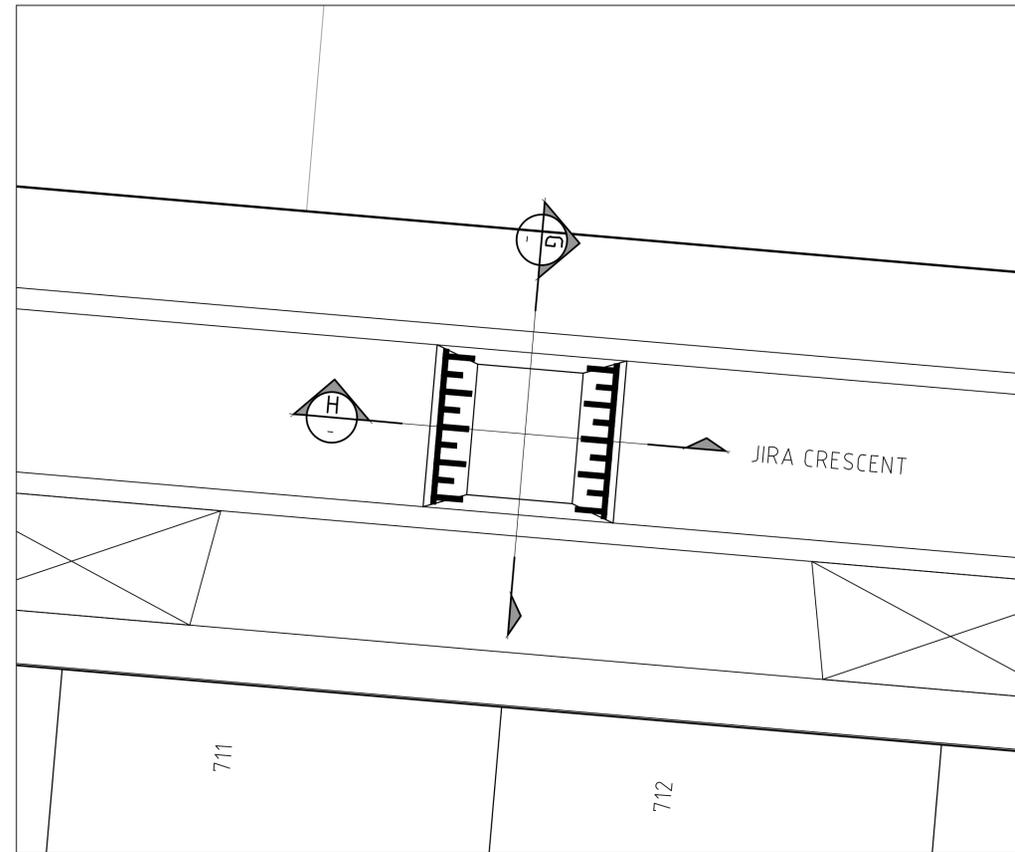

RAISED PAVEMENT FLAT TOP

H 1:100
SCALE @ A1

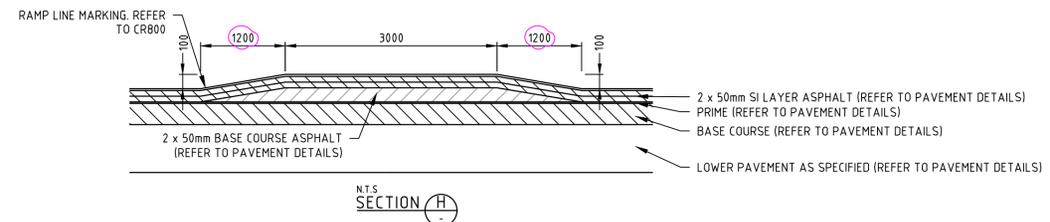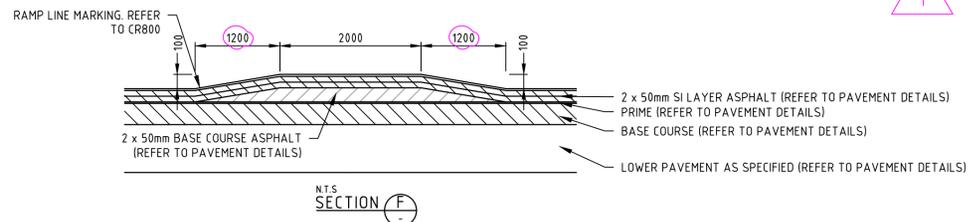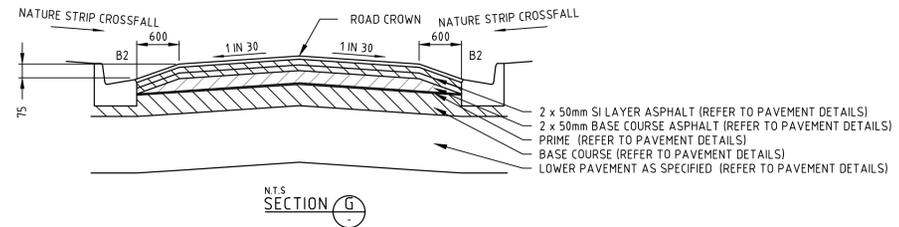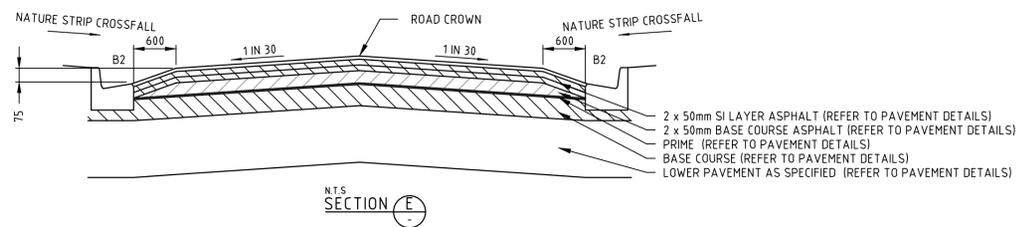

Planning and Environment Act 1987
Wyndham Planning Scheme

Approved Plan As Required
under Condition 63
Permit No WYP13902/22
Date 02/09/2025

file name: 309443CR702.dwg, layout name: CR702, plot date: 28/08/2025 5:44 PM, sheet: 21 of 22, sheets

Rev	Amendments	Approved	Date
1	RAISED PAVEMENT RAMP WIDTH AMENDED	G.K	28/08/25
0	ISSUED FOR CONSTRUCTION	G.K	29/07/25
B	NOTES AMENDED	G.K	30/05/25
A	ISSUED TO COUNCIL	G.K	04/04/25



© Spiire Australia Pty Ltd All Rights Reserved
This document is produced by Spiire Australia Pty Ltd solely for the benefit of and use by the client in accordance with the terms of the retainer. Spiire Australia Pty Ltd does not and shall not assume any responsibility or liability whatsoever to any third party arising out of any use or reliance by third party on the content of this document.



L6 414 LA TROBE STREET PO BOX 16084 MELBOURNE
VICTORIA 3007 AUSTRALIA T 61 3 9993 7888
spiire.com.au ABN 55 050 029 635




Designed
T. NGUYEN
Authorised
G. KOHLMAN

Checked
G. KOHLMAN
Date
04/04/25

**HARLOW ESTATE
STAGE 7
ROAD AND DRAINAGE
PAVEMENT AND TYPICAL DETAILS - SHEET 2**
WYNDHAM CITY COUNCIL
SIG GROUP


CONSTRUCTION Dwg No 309443CR702 Rev 1

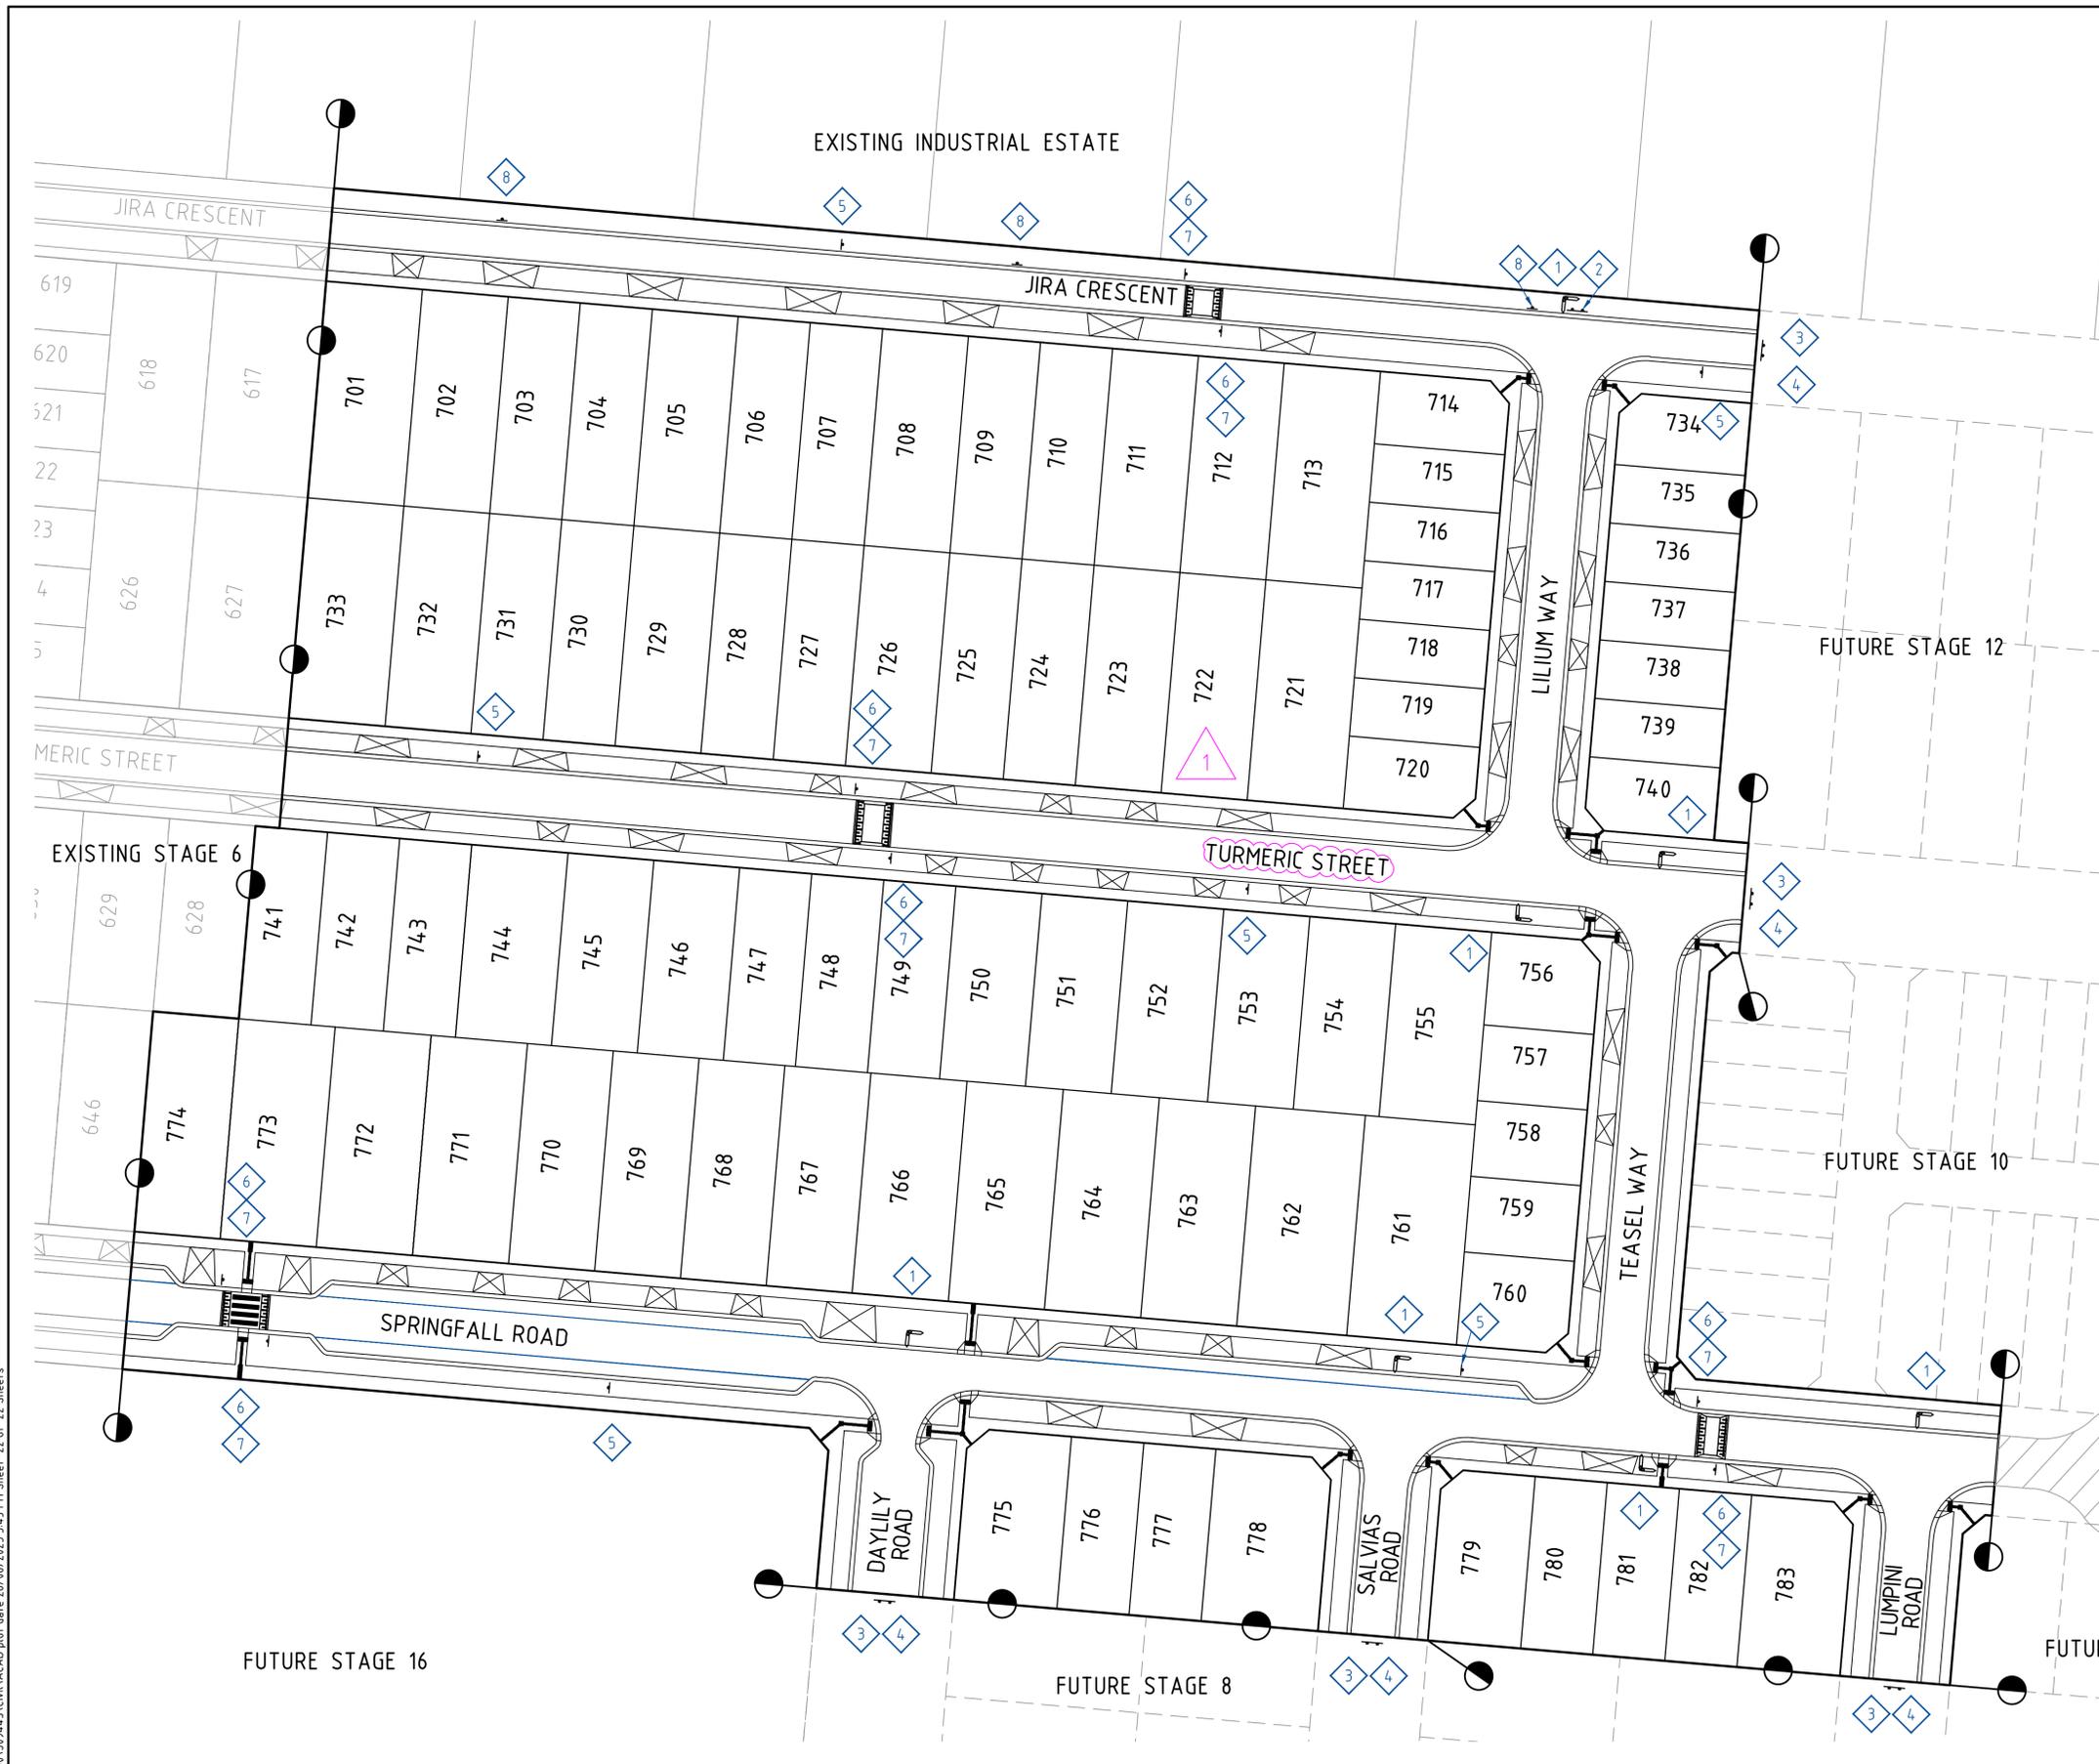

SIGNAGE SCHEDULE


REFERENCE NO.	SIGN	COMMENTS
1	STREET NAME	STREET NAME PLATES TO BE IN ACCORDANCE WITH HCC SD4.08 & SD4.12, INCLUDING "NO THROUGH ROAD" NOMINATION WHERE APPLICABLE
2		D4-2-1
3	ROAD CLOSED	G9-20
4		D4-5
5		W3-4
6		W5-10
7	20 km/h	W8-2
8		R5-35

NOTE: STREET SIGNS ARE TO BE MOUNTED ON LIGHT POLES, WITH A COUNCIL APPROVED BRACKET, IN LIEU OF SIGN POLES WHERE THE TWO POLES ARE IN CLOSE PROXIMITY AND WHERE THE STREET SIGN WOULD NOT BE COMPROMISED IN ITS PURPOSE BY THE RELOCATION.

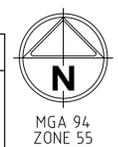

LINEMARKING LEGEND

SYMBOL	DESCRIPTION	REMARK
	CONTINUOUS LANE LINE	100mm WIDE
	TACTILE GROUND SURFACE INDICATORS	SECTION 21.1 VICROADS TRAFFIC ENG. MANUAL VOL. 2

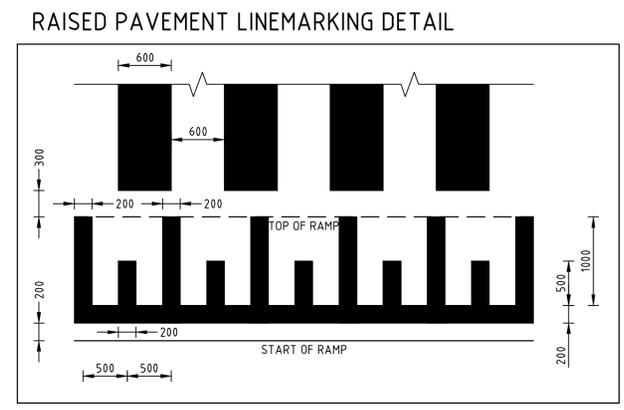


Planning and Environment Act 1987
Wyndham Planning Scheme

Approved Plan As Required
under Condition 63
Permit No WYP13902/22
Date 02/09/2025

file name: 309443CR800.dwg; layout name: CR800; plot style: Harlow.dwt; plot device: HP DesignJet 500; plot date: 28/08/2025 5:45 PM; sheet: 22 of 22; sheets: 22

Rev	Amendments	Approved	Date
1	ROAD NAME AMENDED	G.K	21/08/25
0	ISSUED FOR CONSTRUCTION	G.K	29/07/25
B	SIGNAGE REMOVED, AMENDED & ADDED	G.K	30/05/25
A	ISSUED TO COUNCIL	G.K	04/04/25

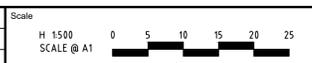

System Certified


© Spiire Australia Pty Ltd All Rights Reserved
 This document is produced by Spiire Australia Pty Ltd solely for the benefit of and use by the client in accordance with the terms of the retainer. Spiire Australia Pty Ltd does not and shall not assume any responsibility or liability whatsoever to any third party arising out of any use or reliance by third party on the content of this document.

L6 414 LA TROBE STREET PO BOX 16084 MELBOURNE
 VICTORIA 8007 AUSTRALIA T 61 3 9993 7888
 spiire.com.au ABN 55 050 029 635

Designed: T. NGUYEN
 Authorised: G. KOHLMAN
 Checked: G. KOHLMAN
 Date: 04/04/25


HARLOW ESTATE
STAGE 7
ROAD AND DRAINAGE
SIGNAGE AND LINEMARKING
 WYNDHAM CITY COUNCIL
 SIG GROUP

CONSTRUCTION Drg No: 309443CR800 Rev: 1

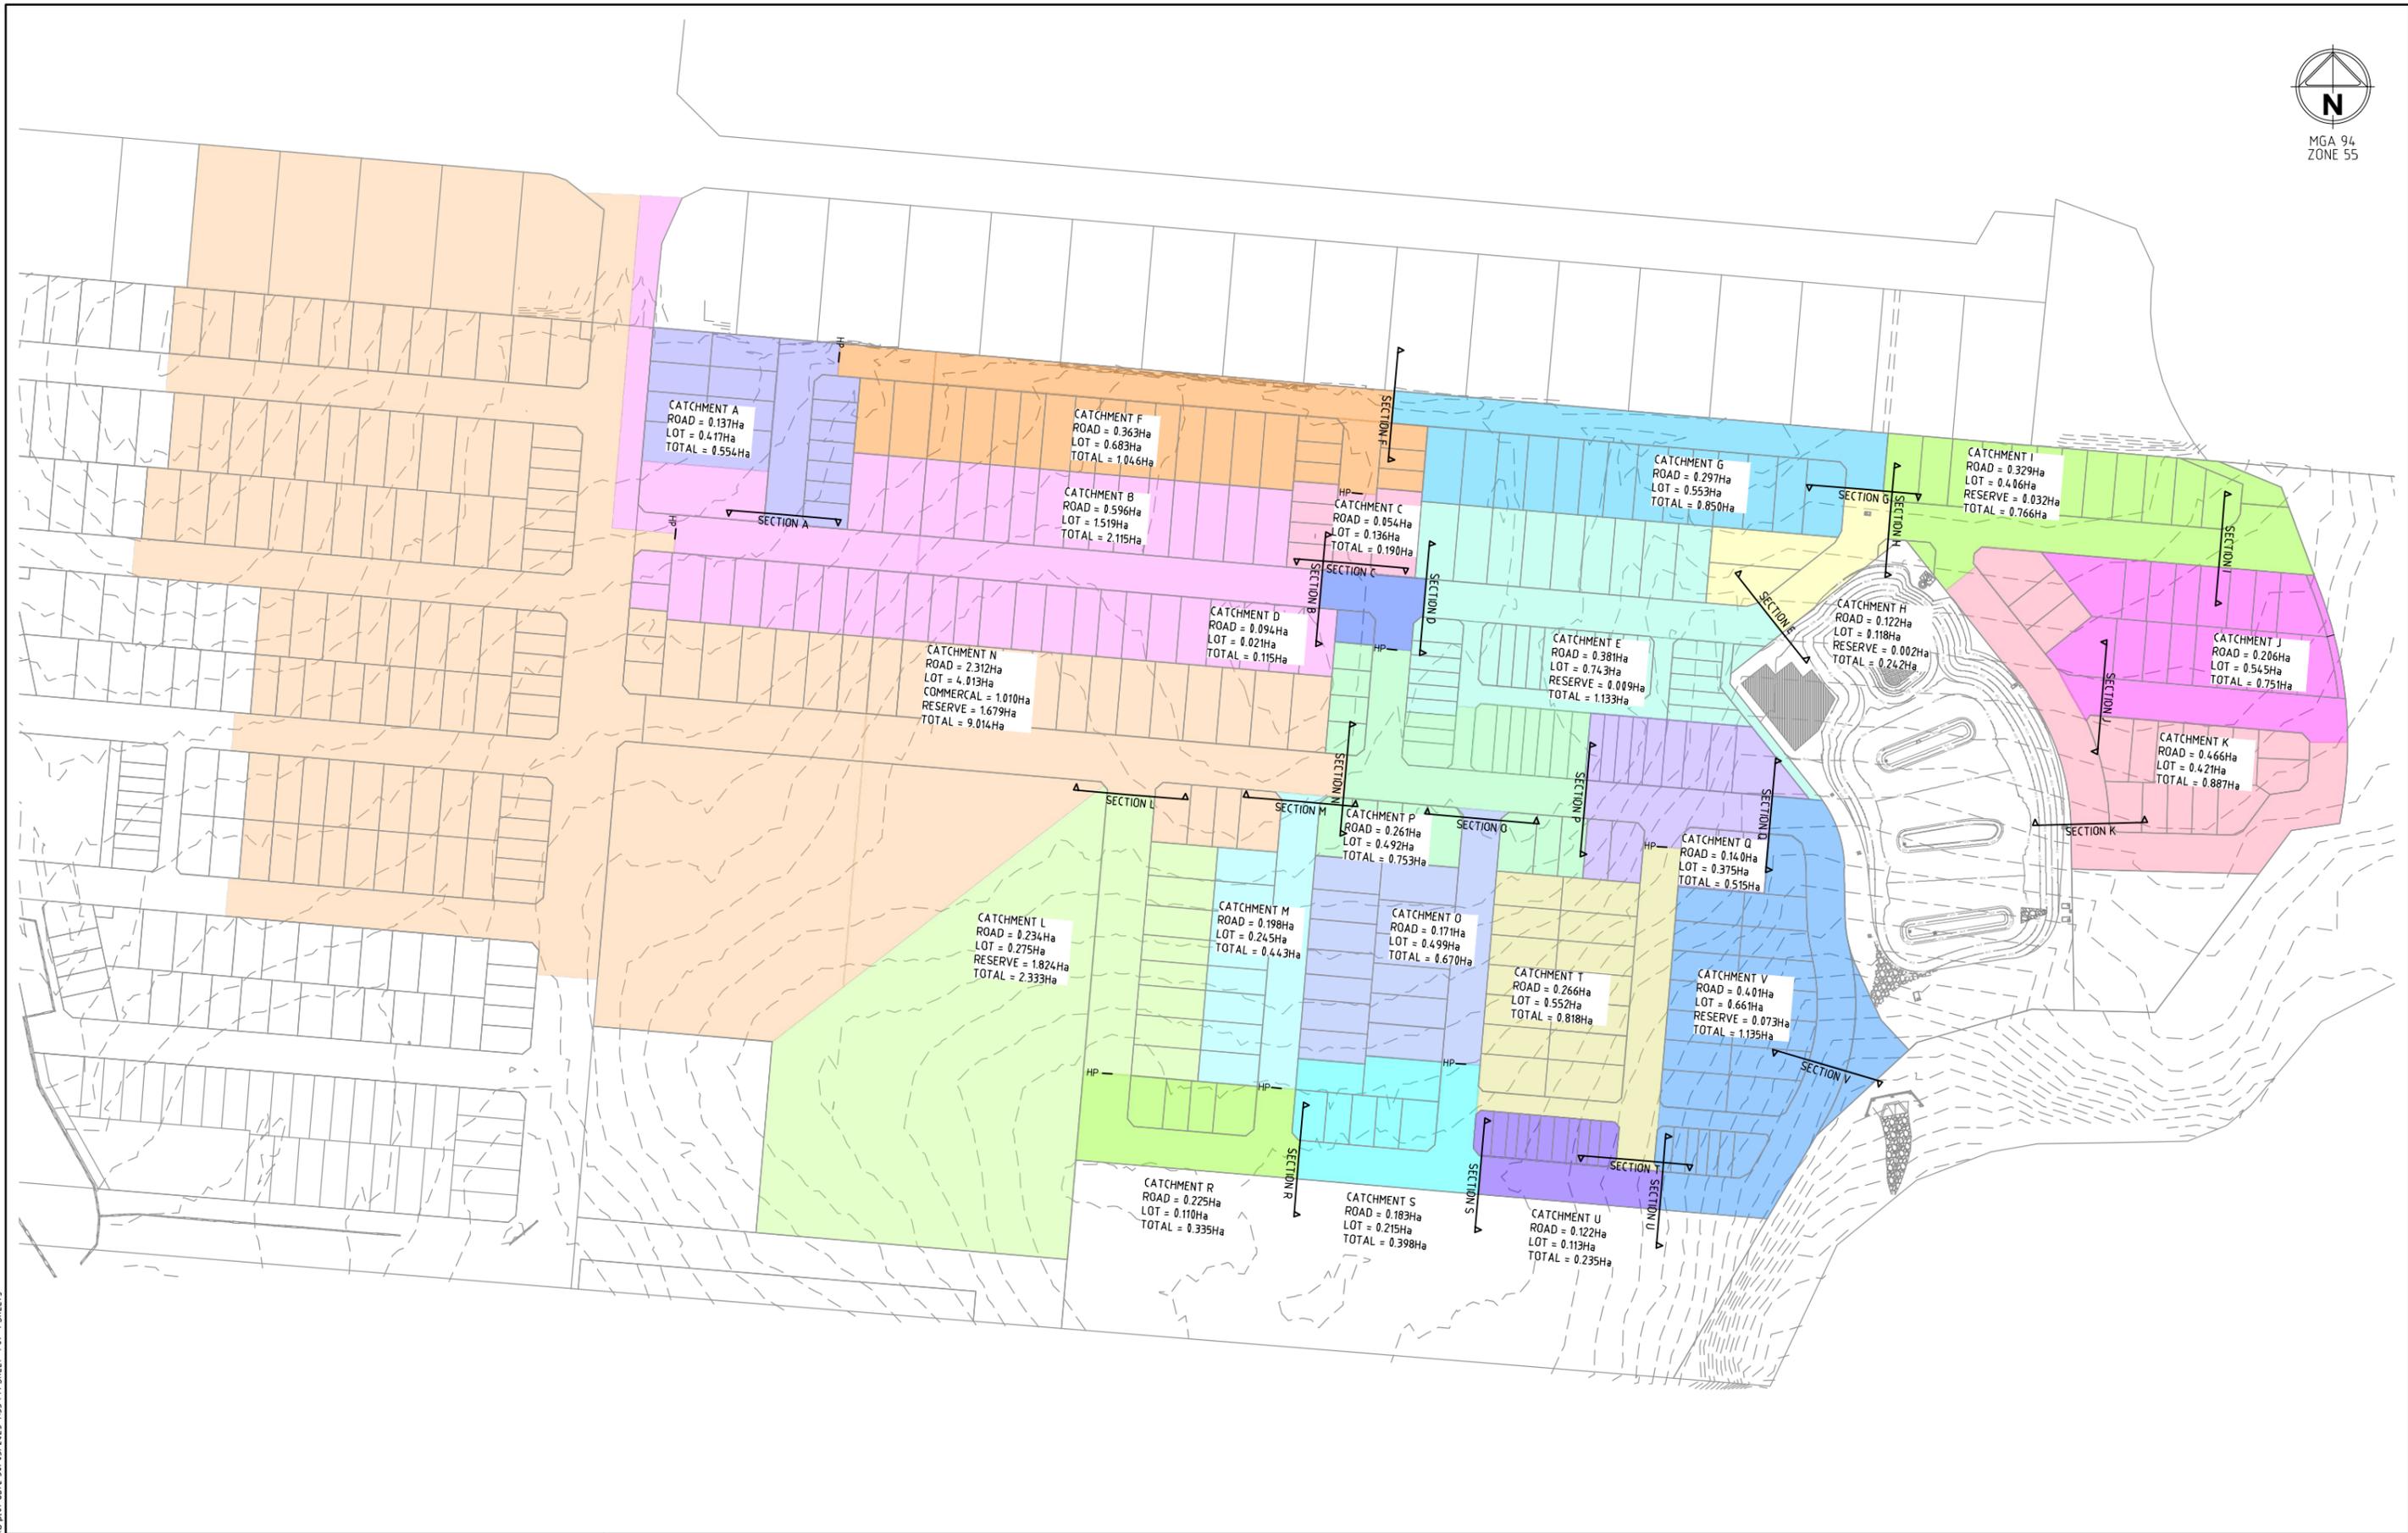

file name: 309443CD500.dwg; layout name: CD500; plotted by: Thinh Nguyen; file location: G:\30\309443\CD500\CD500.dwg; plot date: 30/05/2025 4:33 PM; Sheet: 1 of 1 Sheets

Rev	Amendments	Approved	Date
A	ISSUED TO COUNCIL	G.K	04/04/25

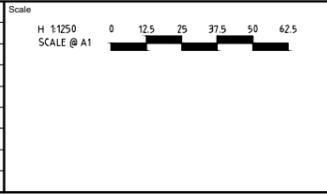

System Certified

© Spiire Australia Pty Ltd All Rights Reserved
This document is produced by Spiire Australia Pty Ltd solely for the benefit of and use by the client in accordance with the terms of the retainer. Spiire Australia Pty Ltd does not and shall not assume any responsibility or liability whatsoever to any third party arising out of any use or reliance by third party on the content of this document.

L6 414 LA TROBE STREET PO BOX 16084 MELBOURNE
VICTORIA 8007 AUSTRALIA T 61 3 9993 7888
spiire.com.au ABN 55 050 029 635

Designed
T. NGUYEN
Authorised
G. KOHLMAN
Checked
G. KOHLMAN
Date
04/04/25

**HARLOW ESTATE
STAGE 7
DRAINAGE COMPUTATIONS
100YR CATCHMENT PLAN
WYNDHAM CITY COUNCIL
SIG GROUP**

 Drg No
309443CD500
 Rev
A

Fraction Impervious	C100	C5	C10
Road Runoff f =	0.6	0.709	0.561
Residential Lot Runoff f =	0.8	0.894	0.708
Commercial Runoff f =	0.9	0.987	0.823
Open Space Runoff f =	0.7	0.802	0.668

Catchment	AREA (Ha)				Fraction Impervious (f)	Weighted Runoff C100	Weighted Runoff C5	Weighted Runoff C10	
	Road	Lots	Commercial	Open Space					
A	0.14	0.42			0.55	0.75	0.849	0.672	0.707
B	0.60	1.52			2.12	0.74	0.842	0.667	0.702
C	0.05	0.14			0.19	0.74	0.842	0.666	0.701
D	0.09	0.02			0.12	0.64	0.743	0.588	0.619
E	0.38	0.74		0.009	1.13	0.73	0.831	0.658	0.693
F	0.36	0.68			1.05	0.73	0.830	0.657	0.692
G	0.30	0.55			0.85	0.73	0.830	0.657	0.691
H	0.12	0.12		0.002	0.24	0.70	0.800	0.633	0.667
I	0.33	0.41		0.032	0.77	0.71	0.811	0.642	0.676
J	0.21	0.55			0.75	0.75	0.844	0.668	0.703
K	0.47	0.42			0.89	0.69	0.797	0.631	0.664
L	0.23	0.28		1.82	2.33	0.70	0.803	0.636	0.669
M	0.20	0.25			0.44	0.71	0.811	0.642	0.676
N	2.31	4.01	1.01	1.68	9.01	0.74	0.840	0.665	0.700
O	0.17	0.50			0.67	0.75	0.847	0.671	0.706
P	0.26	0.49			0.75	0.73	0.830	0.657	0.692
Q	0.14	0.38			0.52	0.75	0.844	0.668	0.703
R	0.23	0.11			0.34	0.67	0.770	0.609	0.642
S	0.18	0.22			0.40	0.71	0.809	0.641	0.674
T	0.27	0.55			0.82	0.73	0.834	0.660	0.695
U	0.12	0.11			0.24	0.70	0.798	0.632	0.665
V	0.40	0.66		0.07	1.14	0.72	0.823	0.651	0.686

Annual Exceedance Probability (%)

ARI	1	2	5	10	20	50	100
C0	0.30852	0.44522	0.8061217	1.0110151	1.190063	1.4027599	1.5511954
C1	0.71811	0.70162	0.6798835	0.66928446	0.659043	0.6401919	0.6328916
C2	0.11054	0.12434	0.1372764	0.14462879	0.153391	0.1754506	0.18463588
C3	-0.09473	-0.09741	-0.096018	-0.0965306	-0.09872	-0.108387	-0.11294799
C4	0.02157	0.02135	0.0195062	0.01904607	0.019171	0.0212029	0.022312067
C5	-0.00209	-0.002	-0.001683	-0.0015911	-0.00158	-0.001782	-0.0019084
C6	7.37E-05	6.82E-05	5.25E-05	4.77E-05	4.64E-05	5.42E-05	5.95E-05


100yr URBAN ARI Drainage Calculations

DEVELOPED CATCHMENT

Catchment	Section	Additional Catchments		Area (ha)	ΣA (ha)	C100	C5	Ae 100 (ha)	Ae 5 (ha)	ΣC100	ΣC5	ΣAe 100 (ha)	ΣAe 5 (ha)	Flow Length (m)	Velocity 100y (m/s)	Velocity 5y (m/s)	Tc 100 (mins)	Tc 5 (mins)	Int 100 (mm/hr)	Int 5 (mm/hr)	Q100 m3/s	Q5 m3/s	Q5gap m3/s	Comments
A	A			0.554	0.554	0.85	0.67	0.47	0.37	0.85	0.67	0.47	0.37	129	0.62	1.5	8.45	6.43	146.80	78.23	0.192	0.081	0.111	
B	B	A		2.115	2.669	0.84	0.67	1.78	1.41	0.84	0.67	2.25	1.78	436	0.87	1.5	13.37	9.84	117.78	64.95	0.737	0.322	0.415	Includes Catchment A
C	C			0.190	0.190	0.84	0.67	0.16	0.13	0.84	0.67	0.16	0.13	55	1.13	1.5	5.81	5.61	170.59	82.46	0.076	0.029	0.047	
D	D	B	C	0.115	2.974	0.74	0.59	0.09	0.07	0.84	0.66	2.50	1.98	44	0.74	1.5	14.37	10.33	113.40	63.46	0.786	0.348	0.438	Includes Catchments A-C
E	E	D		1.133	4.107	0.83	0.66	0.94	0.75	0.84	0.66	3.44	2.72	146	0.85	1.5	17.22	11.96	102.67	59.02	0.981	0.446	0.534	Includes Catchments A-D
F	F	F		1.046	1.046	0.83	0.66	0.87	0.69	0.83	0.66	0.87	0.69	272	0.73	1.5	11.18	8.02	128.96	71.33	0.311	0.136	0.175	
G	G	F		0.850	1.896	0.83	0.66	0.71	0.56	0.83	0.66	1.57	1.25	199	0.87	1.5	14.98	10.23	110.89	63.76	0.485	0.221	0.264	Includes Catchment F
H	H	E	G	0.242	6.245	0.80	0.63	0.19	0.15	0.83	0.66	5.21	4.12	89	0.64	1.5	19.53	12.94	95.54	56.65	1.381	0.648	0.733	Includes Catchments A-G
I	I	H		0.767	7.012	0.81	0.64	0.62	0.49	0.83	0.66	5.83	4.61	175	0.64	1.5	24.07	14.89	84.37	52.56	1.366	0.674	0.692	Includes Catchments A-H
J	J			0.751	0.751	0.84	0.67	0.63	0.50	0.84	0.67	0.63	0.50	151	0.67	1.5	8.75	6.68	144.56	77.07	0.254	0.107	0.147	
K	K	J		0.887	1.638	0.80	0.63	0.71	0.56	0.82	0.65	1.34	1.06	60	1.02	1.5	9.73	7.34	137.76	74.09	0.513	0.218	0.295	Includes Catchment J
L	L			2.333	2.333	0.80	0.64	1.87	1.48	0.80	0.64	1.87	1.48	274	0.94	1.5	9.88	8.04	136.77	71.24	0.712	0.294	0.418	
M	M			0.443	0.443	0.81	0.64	0.36	0.28	0.81	0.64	0.36	0.28	143	0.57	1.5	9.15	6.59	141.69	77.49	0.141	0.061	0.080	
N	N	L	M	9.014	11.790	0.84	0.66	7.57	5.99	0.83	0.66	9.80	7.76	796	0.68	1.5	24.42	13.84	83.61	54.67	2.277	1.179	1.099	Includes Catchments L & M
O	O	N		0.670	0.670	0.85	0.67	0.57	0.45	0.85	0.67	0.57	0.45	180	0.67	1.5	9.47	7.00	139.50	75.60	0.220	0.094	0.126	
P	P	N	O	0.753	13.213	0.83	0.66	0.63	0.49	0.83	0.66	11.00	8.71	105	0.62	1.5	27.25	15.01	78.15	52.33	2.387	1.266	1.122	Includes Catchments L-O
Q	Q	P		0.515	13.728	0.84	0.67	0.43	0.34	0.83	0.66	11.43	9.05	78	1.47	1.5	28.13	15.88	76.61	50.74	2.433	1.276	1.157	Includes Catchments L-P
R	R			0.335	0.335	0.77	0.61	0.26	0.20	0.77	0.61	0.26	0.20	108	0.57	1.5	8.14	6.20	149.24	79.38	0.107	0.045	0.062	
S	S	R		0.398	0.733	0.81	0.64	0.32	0.25	0.79	0.63	0.58	0.46	77	1.21	1.5	9.20	7.06	141.38	75.35	0.228	0.096	0.132	Includes Catchment R
T	T	S		0.818	0.818	0.83	0.66	0.68	0.54	0.83	0.66	0.68	0.54	183	1.72	1.5	6.77	7.03	160.96	75.45	0.305	0.113	0.192	
U	U	S	T	0.235	1.786	0.80	0.63	0.19	0.15	0.81	0.64	1.45	1.15	76	1.44	1.5	10.08	7.90	135.53	71.81	0.546	0.229	0.317	Includes Catchments R-T
V	V	Q	U	1.135	16.649	0.82	0.65	0.93	0.74	0.83	0.66	13.82	10.94	121	0.81	1.5	30.62	17.22	72.61	48.48	2.787	1.473	1.314	Includes Catchments L-U

file name: 309443CD501.dwg, layout name: CD501, plotted by: Thanh Nguyen, file location: G:\30\309443\CD501\A1.dwg, plot date: 30/05/2025, 4:34:58 PM, Sheet: 1 of 1 Sheets

Rev	Amendments	Approved	Date
A	ISSUED TO COUNCIL	G.K	04/04/25

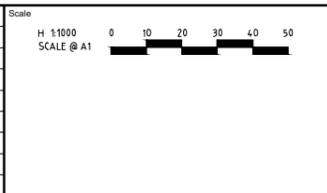

spiire

L6 414 LA TROBE STREET PO BOX 16084 MELBOURNE
VICTORIA 3007 AUSTRALIA T 61 3 9993 7888
spiire.com.au ABN 55 050 029 635

Harlow
TARNETT

Designed: T. NGUYEN
Checked: G. KOHLMAN
Authorised: G. KOHLMAN
Date: 04/04/25

**HARLOW ESTATE
STAGE 7
DRAINAGE COMPUTATIONS
100YR CATCHMENT CALCULATIONS**
WYNDHAM CITY COUNCIL
SIG GROUP

Rev No: 309443CD501
Rev: A

PROJECT: SECTION A
JIRA CRESCENT (CH1084.77)
Print-out date: 14/01/2025 - Time: 9:44
Data File: G:\30309443\Civil\12DPC CONVEY\SECTION A.dwg



2. DISCHARGE INFORMATION:

100 year (1%) storm event

Total discharge = 0.111 cumecs

There is no pipe discharge
Overland / Channel / Watercourse discharge = 0.111 cumecs

3. RESULTS: Water surface elevation = 48.633m


High Flow Channel grade = 1 in 200, Main Channel / Low Flow Channel grade = 1 in 200.

	LEFT OVERBANK	MAIN CHANNEL	RIGHT OVERBANK	TOTAL CROSS-SECTION
Discharge (cumecs):	0.00	0.11	0.00	0.11
D(Max) = Max. Depth (m):	0.00	0.10	0.00	0.10
D(Ave) = Ave. Depth (m):	0.00	0.04	0.00	0.04
V = Ave. Velocity (m/s):	0.00	0.62	0.00	0.62
D(Max) x V (cumecs/m):	0.00	0.06	0.00	0.06
D(Ave) x V (cumecs/m):	0.00	0.03	0.00	0.03
Froude Number:	0.00	0.99	0.00	N/A
Area (m ²):	0.00	0.18	0.00	0.18
Wetted Perimeter (m):	0.00	4.70	0.00	4.70
Flow Width (m):	0.00	4.54	0.00	4.54
Hydraulic Radius (m):	0.00	0.04	0.00	0.04
Composite Manning's n:	0.000	0.013	0.000	N/A
Split Flow?	-	-	-	Yes

4. CROSS-SECTION DATA:

SEGMENT NO.	LEFT HAND POINT CHAINAGE (m)	LEFT HAND POINT R.L. (m)	RIGHT HAND POINT CHAINAGE (m)	RIGHT HAND POINT R.L. (m)	MANNING'S N
1	-8.00	49.823	-7.950	49.822	0.035
2	-7.950	49.822	-6.450	49.792	0.013
3	-6.450	49.792	-3.800	49.703	0.035
4	-3.800	49.703	-3.690	49.703	0.013
5	-3.690	49.703	-3.650	49.553	0.013
6	-3.650	49.553	-3.200	49.593	0.013
7	-3.200	49.593	0.000	49.700	0.013
8	0.000	49.700	3.200	49.593	0.013
9	3.200	49.593	3.650	49.553	0.013
10	3.650	49.553	3.690	49.703	0.013
11	3.690	49.703	3.800	49.703	0.013
12	3.800	49.703	6.450	49.792	0.035
13	6.450	49.792	7.950	49.822	0.013
14	7.950	49.822	8.000	49.823	0.035

PROJECT: SECTION E
BOURNESIDE STREET (CH486.85)
Print-out date: 14/01/2025 - Time: 4:07
Data File: G:\30309443\Civil\12DPC CONVEY\SECTION E.dwg

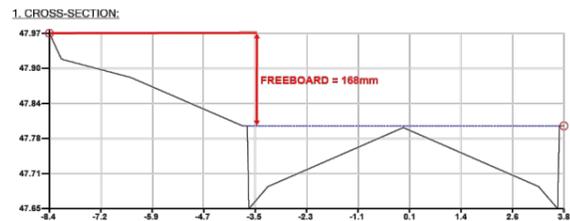

2. DISCHARGE INFORMATION:

100 year (1%) storm event

Total discharge = 0.534 cumecs

There is no pipe discharge
Overland / Channel / Watercourse discharge = 0.534 cumecs

3. RESULTS: Water surface elevation = 47.798m


High Flow Channel grade = 1 in 200, Main Channel / Low Flow Channel grade = 1 in 200.

	LEFT OVERBANK	MAIN CHANNEL	RIGHT OVERBANK	TOTAL CROSS-SECTION
Discharge (cumecs):	0.00	0.42	0.00	0.42
D(Max) = Max. Depth (m):	0.00	0.15	0.00	0.15
D(Ave) = Ave. Depth (m):	0.00	0.07	0.00	0.07
V = Ave. Velocity (m/s):	0.00	0.87	0.00	0.87
D(Max) x V (cumecs/m):	0.00	0.13	0.00	0.13
D(Ave) x V (cumecs/m):	0.00	0.06	0.00	0.06
Froude Number:	0.00	1.08	0.00	1.08
Area (m ²):	0.00	0.48	0.00	0.48
Wetted Perimeter (m):	0.00	7.62	0.00	7.62
Flow Width (m):	0.00	7.38	0.00	7.38
Hydraulic Radius (m):	0.00	0.06	0.00	0.06
Composite Manning's n:	0.000	0.013	0.000	0.013
Split Flow?	-	-	-	No

4. CROSS-SECTION DATA:

SEGMENT NO.	LEFT HAND POINT CHAINAGE (m)	LEFT HAND POINT R.L. (m)	RIGHT HAND POINT CHAINAGE (m)	RIGHT HAND POINT R.L. (m)	MANNING'S N
1	-8.368	47.966	-8.089	47.920	0.013
2	-8.089	47.920	-8.035	47.918	0.035
3	-8.035	47.918	-6.450	47.886	0.013
4	-6.450	47.886	-3.800	47.798	0.035
5	-3.800	47.798	-3.690	47.798	0.013
6	-3.690	47.798	-3.650	47.648	0.013
7	-3.650	47.648	-3.200	47.688	0.013
8	-3.200	47.688	0.000	47.795	0.013
9	0.000	47.795	3.200	47.688	0.013
10	3.200	47.688	3.650	47.648	0.013
11	3.650	47.648	3.690	47.798	0.013
12	3.690	47.798	3.800	47.798	0.013

PROJECT: SECTION B
BOURNESIDE STREET (CH297.42)
Print-out date: 31/01/2024 - Time: 4:21
Data File: G:\30309443\Civil\12DPC CONVEY\SECTION B.dwg

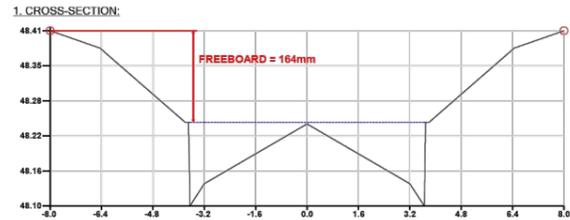

2. DISCHARGE INFORMATION:

100 year (1%) storm event

Total discharge = 0.415 cumecs

There is no pipe discharge
Overland / Channel / Watercourse discharge = 0.415 cumecs

3. RESULTS: Water surface elevation = 48.245m


High Flow Channel grade = 1 in 200, Main Channel / Low Flow Channel grade = 1 in 200.

	LEFT OVERBANK	MAIN CHANNEL	RIGHT OVERBANK	TOTAL CROSS-SECTION
Discharge (cumecs):	0.00	0.15	0.00	0.15
D(Max) = Max. Depth (m):	0.00	0.13	0.00	0.13
D(Ave) = Ave. Depth (m):	0.00	0.07	0.00	0.07
V = Ave. Velocity (m/s):	0.00	0.87	0.00	0.87
D(Max) x V (cumecs/m):	0.00	0.13	0.00	0.13
D(Ave) x V (cumecs/m):	0.00	0.06	0.00	0.06
Froude Number:	0.00	1.08	0.00	1.08
Area (m ²):	0.00	0.48	0.00	0.48
Wetted Perimeter (m):	0.00	7.62	0.00	7.62
Flow Width (m):	0.00	7.38	0.00	7.38
Hydraulic Radius (m):	0.00	0.06	0.00	0.06
Composite Manning's n:	0.000	0.013	0.000	0.013
Split Flow?	-	-	-	No

4. CROSS-SECTION DATA:

SEGMENT NO.	LEFT HAND POINT CHAINAGE (m)	LEFT HAND POINT R.L. (m)	RIGHT HAND POINT CHAINAGE (m)	RIGHT HAND POINT R.L. (m)	MANNING'S N
1	-8.000	48.409	-7.950	48.408	0.035
2	-7.950	48.408	-6.450	48.378	0.013
3	-6.450	48.378	-3.800	48.245	0.035
4	-3.800	48.245	-3.690	48.245	0.013
5	-3.690	48.245	-3.650	48.095	0.013
6	-3.650	48.095	-3.200	48.135	0.013
7	-3.200	48.135	0.000	48.242	0.013
8	0.000	48.242	3.200	48.135	0.013
9	3.200	48.135	3.650	48.095	0.013
10	3.650	48.095	3.690	48.245	0.013
11	3.690	48.245	3.800	48.245	0.013
12	3.800	48.245	6.450	48.378	0.035
13	6.450	48.378	7.950	48.408	0.013
14	7.950	48.408	8.000	48.409	0.035

PROJECT: SECTION F
JIRA CRESCENT (CH771.21)
Print-out date: 04/02/2025 - Time: 4:07
Data File: G:\30309443\Civil\12DPC CONVEY\SECTION F.dwg

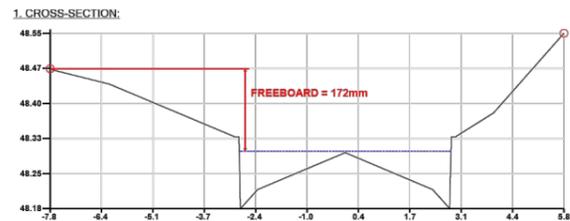

2. DISCHARGE INFORMATION:

100 year (1%) storm event

Total discharge = 0.175 cumecs

There is no pipe discharge
Overland / Channel / Watercourse discharge = 0.175 cumecs

3. RESULTS: Water surface elevation = 48.299m

High Flow Channel grade = 1 in 200, Main Channel / Low Flow Channel grade = 1 in 200.

	LEFT OVERBANK	MAIN CHANNEL	RIGHT OVERBANK	TOTAL CROSS-SECTION
Discharge (cumecs):	0.00	0.21	0.00	0.21
D(Max) = Max. Depth (m):	0.00	0.12	0.00	0.12
D(Ave) = Ave. Depth (m):	0.00	0.05	0.00	0.05
V = Ave. Velocity (m/s):	0.00	0.73	0.00	0.73
D(Max) x V (cumecs/m):	0.00	0.09	0.00	0.09
D(Ave) x V (cumecs/m):	0.00	0.04	0.00	0.04
Froude Number:	0.00	1.03	0.00	1.03
Area (m ²):	0.00	0.28	0.00	0.28
Wetted Perimeter (m):	0.00	5.75	0.00	5.75
Flow Width (m):	0.00	5.56	0.00	5.56
Hydraulic Radius (m):	0.00	0.05	0.00	0.05
Composite Manning's n:	0.000	0.013	0.000	0.013
Split Flow?	-	-	-	No

4. CROSS-SECTION DATA:

SEGMENT NO.	LEFT HAND POINT CHAINAGE (m)	LEFT HAND POINT R.L. (m)	RIGHT HAND POINT CHAINAGE (m)	RIGHT HAND POINT R.L. (m)	MANNING'S N
1	-7.750	48.471	-7.700	48.469	0.035
2	-7.700	48.469	-6.200	48.439	0.013
3	-6.200	48.439	-2.900	48.329	0.013
4	-2.900	48.329	-2.790	48.329	0.013
5	-2.790	48.329	-2.750	48.179	0.013
6	-2.750	48.179	-2.300	48.219	0.013
7	-2.300	48.219	0.000	48.296	0.013
8	0.000	48.296	2.300	48.219	0.013
9	2.300	48.219	2.750	48.179	0.013
10	2.750	48.179	2.790	48.329	0.013
11	2.790	48.329	2.900	48.329	0.013
12	2.900	48.329	3.900	48.379	0.035

PROJECT: SECTION C
LILJUM WAY (CH11.80)
Print-out date: 14/01/2025 - Time: 4:25
Data File: G:\30309443\Civil\12DPC CONVEY\SECTION C.dwg



2. DISCHARGE INFORMATION:

100 year (1%) storm event

Total discharge = 0.047 cumecs

There is no pipe discharge
Overland / Channel / Watercourse discharge = 0.047 cumecs

3. RESULTS: Water surface elevation = 48.291m


High Flow Channel grade = 1 in 28.571, Main Channel / Low Flow Channel grade = 1 in 28.571.

	LEFT OVERBANK	MAIN CHANNEL	RIGHT OVERBANK	TOTAL CROSS-SECTION
Discharge (cumecs):	0.00	0.06	0.00	0.06
D(Max) = Max. Depth (m):	0.00	0.06	0.00	0.06
D(Ave) = Ave. Depth (m):	0.00	0.02	0.00	0.02
V = Ave. Velocity (m/s):	0.00	1.13	0.00	1.13
D(Max) x V (cumecs/m):	0.00	0.07	0.00	0.07
D(Ave) x V (cumecs/m):	0.00	0.03	0.00	0.03
Froude Number:	0.00	2.38	0.00	N/A
Area (m ²):	0.00	0.05	0.00	0.05
Wetted Perimeter (m):	0.00	2.24	0.00	2.24
Flow Width (m):	0.00	2.14	0.00	2.14
Hydraulic Radius (m):	0.00	0.02	0.00	0.02
Composite Manning's n:	0.000	0.013	0.000	N/A
Split Flow?	-	-	-	Yes

4. CROSS-SECTION DATA:

SEGMENT NO.	LEFT HAND POINT CHAINAGE (m)	LEFT HAND POINT R.L. (m)	RIGHT HAND POINT CHAINAGE (m)	RIGHT HAND POINT R.L. (m)	MANNING'S N
1	-8.000	48.501	-7.950	48.499	0.035
2	-7.950	48.499	-6.450	48.469	0.013
3	-6.450	48.469	-3.800	48.381	0.035
4	-3.800	48.381	-3.690	48.381	0.013
5	-3.690	48.381	-3.650	48.231	0.013
6	-3.650	48.231	-3.200	48.271	0.013
7	-3.200	48.271	0.000	48.377	0.013
8	0.000	48.377	3.200	48.271	0.013
9	3.200	48.271	3.650	48.231	0.013
10	3.650	48.231	3.690	48.381	0.013
11	3.690	48.381	3.800	48.381	0.013
12	3.800	48.381	6.450	48.469	0.035

PROJECT: SECTION G
JIRA CRESCENT (CH557.41)
Print-out date: 04/02/2025 - Time: 4:27
Data File: G:\30309443\Civil\12DPC CONVEY\SECTION G.dwg

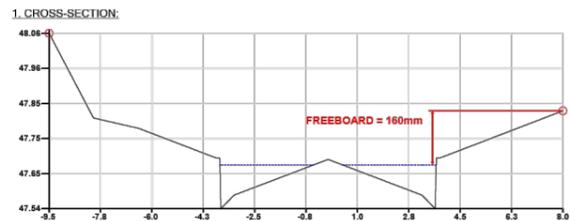

2. DISCHARGE INFORMATION:

100 year (1%) storm event

Total discharge = 0.264 cumecs



2. DISCHARGE INFORMATION:

100 year (1%) storm event
 Total discharge = 0.692 cumecs

There is no pipe discharge
 Overland / Channel / Watercourse discharge = 0.692 cumecs


3. RESULTS: Water surface elevation = 47.377m

High Flow Channel grade = 1 in 200, Main Channel / Low Flow Channel grade = 1 in 200.

	LEFT OVERBANK	MAIN CHANNEL	RIGHT OVERBANK	TOTAL CROSS-SECTION
Discharge (cumecs):	0.00	0.75	0.00	0.75
D(Max) = Max. Depth (m):	0.00	0.22	0.00	0.22
D(Ave) = Ave. Depth (m):	0.00	0.10	0.00	0.10
V = Ave. Velocity (m/s):	0.00	0.64	0.00	0.64
D(Max) x V (cumecs/m):	0.00	0.14	0.00	0.14
D(Ave) x V (cumecs/m):	0.00	0.06	0.00	0.06
Froude Number:	0.00	0.65	0.00	0.65
Area (m ²):	0.00	1.16	0.00	1.16
Wetted Perimeter (m):	0.00	12.06	0.00	12.06
Flow Width (m):	0.00	11.82	0.00	11.82
Hydraulic Radius (m):	0.00	0.10	0.00	0.10
Composite Manning's n:	0.000	0.023	0.000	0.023
Split Flow?	-	-	-	No

4. CROSS-SECTION DATA:

SEGMENT NO.	LEFT HAND POINT CHAINAGE (m)	R.L. (m)	RIGHT HAND POINT CHAINAGE (m)	R.L. (m)	MANNING'S N
1	-9.357	47.653	-8.000	47.427	0.013
2	-8.000	47.427	-7.950	47.425	0.035
3	-7.950	47.425	-6.450	47.395	0.013
4	-6.450	47.395	-3.800	47.307	0.035
5	-3.800	47.307	-3.690	47.307	0.013
6	-3.690	47.307	-3.650	47.157	0.013
7	-3.650	47.157	-3.200	47.197	0.013
8	-3.200	47.197	0.000	47.304	0.013
9	0.000	47.304	3.200	47.197	0.013
10	3.200	47.197	3.690	47.307	0.013
11	3.690	47.307	3.800	47.307	0.013
12	3.800	47.307	6.450	47.395	0.035
13	6.450	47.395	7.950	47.425	0.013
14	7.950	47.425	8.000	47.427	0.035
15	8.000	47.427	9.000	47.594	0.035

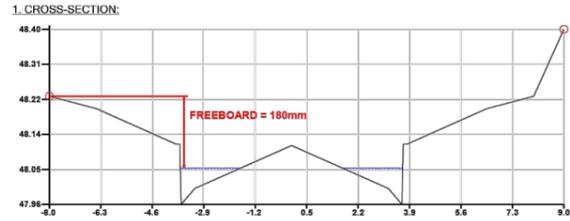

2. DISCHARGE INFORMATION:

100 year (1%) storm event
 Total discharge = 0.08 cumecs

There is no pipe discharge
 Overland / Channel / Watercourse discharge = 0.080 cumecs


3. RESULTS: Water surface elevation = 48.052m

High Flow Channel grade = 1 in 200, Main Channel / Low Flow Channel grade = 1 in 200.

	LEFT OVERBANK	MAIN CHANNEL	RIGHT OVERBANK	TOTAL CROSS-SECTION
Discharge (cumecs):	0.00	0.08	0.00	0.08
D(Max) = Max. Depth (m):	0.00	0.09	0.00	0.09
D(Ave) = Ave. Depth (m):	0.00	0.04	0.00	0.04
V = Ave. Velocity (m/s):	0.00	0.57	0.00	0.57
D(Max) x V (cumecs/m):	0.00	0.05	0.00	0.05
D(Ave) x V (cumecs/m):	0.00	0.02	0.00	0.02
Froude Number:	0.00	0.97	0.00	N/A
Area (m ²):	0.00	0.14	0.00	0.14
Wetted Perimeter (m):	0.00	4.08	0.00	4.08
Flow Width (m):	0.00	3.94	0.00	3.94
Hydraulic Radius (m):	0.00	0.03	0.00	0.03
Composite Manning's n:	0.000	0.013	0.000	N/A
Split Flow?	-	-	-	Yes

4. CROSS-SECTION DATA:

SEGMENT NO.	LEFT HAND POINT CHAINAGE (m)	R.L. (m)	RIGHT HAND POINT CHAINAGE (m)	R.L. (m)	MANNING'S N
1	-8.000	48.232	-7.950	48.231	0.035
2	-7.950	48.231	-6.450	48.201	0.013
3	-6.450	48.201	-3.800	48.112	0.035
4	-3.800	48.112	-3.690	48.112	0.013
5	-3.690	48.112	-3.650	47.962	0.013
6	-3.650	47.962	-3.200	48.002	0.013
7	-3.200	48.002	0.000	48.109	0.013
8	0.000	48.109	3.200	48.002	0.013
9	3.200	48.002	3.690	47.962	0.013
10	3.690	47.962	6.450	48.112	0.013
11	6.450	48.112	7.950	48.201	0.035
12	7.950	48.201	8.000	48.201	0.013
13	8.000	48.201	9.000	48.231	0.035
14	9.000	48.231	10.000	48.232	0.035

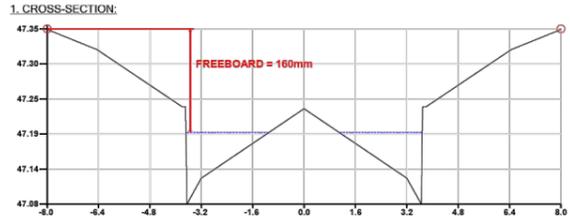

2. DISCHARGE INFORMATION:

100 year (1%) storm event
 Total discharge = 0.147 cumecs

There is no pipe discharge
 Overland / Channel / Watercourse discharge = 0.147 cumecs


3. RESULTS: Water surface elevation = 47.193m

High Flow Channel grade = 1 in 200, Main Channel / Low Flow Channel grade = 1 in 200.

	LEFT OVERBANK	MAIN CHANNEL	RIGHT OVERBANK	TOTAL CROSS-SECTION
Discharge (cumecs):	0.00	0.15	0.00	0.15
D(Max) = Max. Depth (m):	0.00	0.11	0.00	0.11
D(Ave) = Ave. Depth (m):	0.00	0.04	0.00	0.04
V = Ave. Velocity (m/s):	0.00	0.67	0.00	0.67
D(Max) x V (cumecs/m):	0.00	0.07	0.00	0.07
D(Ave) x V (cumecs/m):	0.00	0.03	0.00	0.03
Froude Number:	0.00	1.01	0.00	N/A
Area (m ²):	0.00	0.23	0.00	0.23
Wetted Perimeter (m):	0.00	5.32	0.00	5.32
Flow Width (m):	0.00	5.15	0.00	5.15
Hydraulic Radius (m):	0.00	0.04	0.00	0.04
Composite Manning's n:	0.000	0.013	0.000	N/A
Split Flow?	-	-	-	Yes

4. CROSS-SECTION DATA:

SEGMENT NO.	LEFT HAND POINT CHAINAGE (m)	R.L. (m)	RIGHT HAND POINT CHAINAGE (m)	R.L. (m)	MANNING'S N
1	-8.000	47.353	-7.950	47.351	0.035
2	-7.950	47.351	-6.450	47.321	0.013
3	-6.450	47.321	-3.800	47.233	0.035
4	-3.800	47.233	-3.690	47.233	0.013
5	-3.690	47.233	-3.650	47.083	0.013
6	-3.650	47.083	-3.200	47.123	0.013
7	-3.200	47.123	0.000	47.230	0.013
8	0.000	47.230	3.200	47.123	0.013
9	3.200	47.123	3.650	47.083	0.013
10	3.650	47.083	3.690	47.233	0.013
11	3.690	47.233	3.800	47.233	0.013
12	3.800	47.233	6.450	47.321	0.035
13	6.450	47.321	7.950	47.351	0.013
14	7.950	47.351	8.000	47.353	0.035

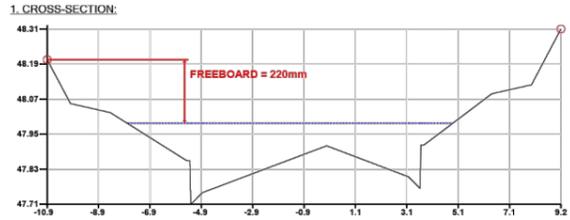

2. DISCHARGE INFORMATION:

100 year (1%) storm event
 Total discharge = 1.1 cumecs

There is no pipe discharge
 Overland / Channel / Watercourse discharge = 1.099 cumecs


3. RESULTS: Water surface elevation = 47.986m

High Flow Channel grade = 1 in 300, Main Channel / Low Flow Channel grade = 1 in 300.

	LEFT OVERBANK	MAIN CHANNEL	RIGHT OVERBANK	TOTAL CROSS-SECTION
Discharge (cumecs):	0.00	1.11	0.00	1.11
D(Max) = Max. Depth (m):	0.00	0.28	0.00	0.28
D(Ave) = Ave. Depth (m):	0.00	0.13	0.00	0.13
V = Ave. Velocity (m/s):	0.00	0.88	0.00	0.88
D(Max) x V (cumecs/m):	0.00	0.19	0.00	0.19
D(Ave) x V (cumecs/m):	0.00	0.09	0.00	0.09
Froude Number:	0.00	0.61	0.00	0.61
Area (m ²):	0.00	1.63	0.00	1.63
Wetted Perimeter (m):	0.00	12.95	0.00	12.95
Flow Width (m):	0.00	12.71	0.00	12.71
Hydraulic Radius (m):	0.00	0.13	0.00	0.13
Composite Manning's n:	0.000	0.021	0.000	0.021
Split Flow?	-	-	-	No

4. CROSS-SECTION DATA:

SEGMENT NO.	LEFT HAND POINT CHAINAGE (m)	R.L. (m)	RIGHT HAND POINT CHAINAGE (m)	R.L. (m)	MANNING'S N
1	-10.910	48.206	-10.000	48.054	0.013
2	-10.000	48.054	-9.950	48.053	0.035
3	-9.950	48.053	-8.450	48.023	0.013
4	-8.450	48.023	-5.800	47.856	0.013
5	-5.800	47.856	-5.340	47.856	0.013
6	-5.340	47.856	-5.300	47.706	0.013
7	-5.300	47.706	-4.850	47.746	0.013
8	-4.850	47.746	0.000	47.908	0.013
9	0.000	47.908	3.200	47.801	0.013
10	3.200	47.801	3.650	47.761	0.013
11	3.650	47.761	3.690	47.911	0.013
12	3.690	47.911	3.800	47.911	0.013
13	3.800	47.911	6.450	48.088	0.035
14	6.450	48.088	7.950	48.118	0.013
15	7.950	48.118	8.000	48.119	0.035
16	8.000	48.119	9.155	48.312	0.035

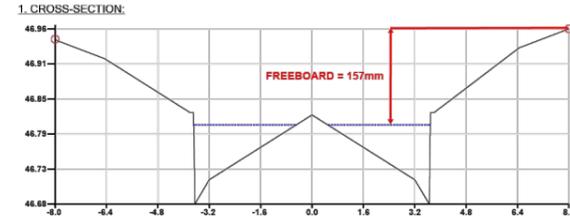

2. DISCHARGE INFORMATION:

100 year (1%) storm event
 Total discharge = 0.295 cumecs

There is no pipe discharge
 Overland / Channel / Watercourse discharge = 0.295 cumecs


3. RESULTS: Water surface elevation = 46.806m

High Flow Channel grade = 1 in 111.29, Main Channel / Low Flow Channel grade = 1 in 111.29.

	LEFT OVERBANK	MAIN CHANNEL	RIGHT OVERBANK	TOTAL CROSS-SECTION
Discharge (cumecs):	0.00	0.36	0.00	0.36
D(Max) = Max. Depth (m):	0.00	0.13	0.00	0.13
D(Ave) = Ave. Depth (m):	0.00	0.05	0.00	0.05
V = Ave. Velocity (m/s):	0.00	1.02	0.00	1.02
D(Max) x V (cumecs/m):	0.00	0.13	0.00	0.13
D(Ave) x V (cumecs/m):	0.00	0.06	0.00	0.06
Froude Number:	0.00	1.40	0.00	N/A
Area (m ²):	0.00	0.35	0.00	0.35
Wetted Perimeter (m):	0.00	6.61	0.00	6.61
Flow Width (m):	0.00	6.40	0.00	6.40
Hydraulic Radius (m):	0.00	0.05	0.00	0.05
Composite Manning's n:	0.000	0.013	0.000	N/A
Split Flow?	-	-	-	Yes

4. CROSS-SECTION DATA:

SEGMENT NO.	LEFT HAND POINT CHAINAGE (m)	R.L. (m)	RIGHT HAND POINT CHAINAGE (m)	R.L. (m)	MANNING'S N
1	-8.000	46.944	-7.950	46.944	0.035
2	-7.950	46.944	-6.450	46.914	0.013
3	-6.450	46.914	-3.800	46.826	0.035
4	-3.800	46.826	-3.690	46.826	0.013
5	-3.690	46.826	-3.650	46.676	0.013
6	-3.650	46.676	-3.200	46.716	0.013
7	-3.200	46.716	0.000	46.822	0.013
8	0.000	46.822	3.200	46.716	0.013
9	3.200	46.716	3.650	46.676	0.013
10	3.650	46.676	3.690	46.826	0.013
11	3.690	46.826	3.800	46.826	0.013
12	3.800	46.826	6.450	46.914	0.035
13	6.450	46.914	7.950	46.944	0.013
14	7.950	46.944	8.000	46.944	0.035

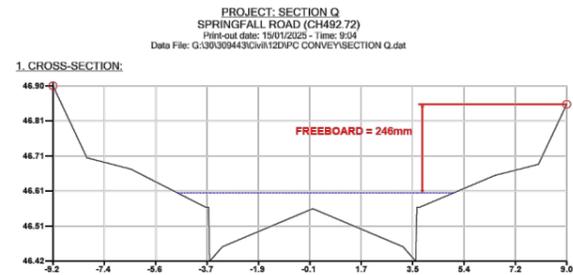


2. DISCHARGE INFORMATION:
 100 year (1%) storm event
 Total discharge = 1.16 cumecs
 There is no pipe discharge
 Overland / Channel / Watercourse discharge = 1.157 cumecs
 3. RESULTS: Water surface elevation = 46.607m
 High Flow Channel grade = 1 in 41.667, Main Channel / Low Flow Channel grade = 1 in 41.667.

	LEFT OVERBANK	MAIN CHANNEL	RIGHT OVERBANK	TOTAL CROSS-SECTION
Discharge (cumecs):	0.00	1.23	0.00	1.23
D(Max) = Max. Depth (m):	0.00	0.19	0.00	0.19
D(Ave) = Ave. Depth (m):	0.00	0.09	0.00	0.09
V = Ave. Velocity (m/s):	0.00	1.47	0.00	1.47
D(Max) x V (cumecs/m):	0.00	0.28	0.00	0.28
D(Ave) x V (cumecs/m):	0.00	0.13	0.00	0.13
Froude Number:	0.00	1.61	0.00	1.61
Area (m ²):	0.00	0.84	0.00	0.84
Wetted Perimeter (m):	0.00	10.04	0.00	10.04
Flow Width (m):	0.00	9.80	0.00	9.80
Hydraulic Radius (m):	0.00	0.08	0.00	0.08
Composite Manning's n:	0.000	0.020	0.000	0.020
Split Flow?	-	-	-	No

4. CROSS-SECTION DATA:

SEGMENT NO.	LEFT HAND POINT CHAINAGE (m)	R.L. (m)	RIGHT HAND POINT CHAINAGE (m)	R.L. (m)	MANNING'S N
1	-9.200	46.904	-8.000	46.704	0.013
2	-8.000	46.704	-7.950	46.703	0.035
3	-7.950	46.703	-6.450	46.673	0.013
4	-6.450	46.673	-3.800	46.567	0.035
5	-3.800	46.567	-3.690	46.567	0.013
6	-3.690	46.567	-3.650	46.417	0.013
7	-3.650	46.417	-3.200	46.457	0.013
8	-3.200	46.457	0.000	46.563	0.013
9	0.000	46.563	3.200	46.457	0.013
10	3.200	46.457	3.690	46.417	0.013
11	3.690	46.417	3.800	46.567	0.013
12	3.800	46.567	3.800	46.567	0.013
13	3.800	46.567	6.450	46.655	0.035
14	6.450	46.655	7.950	46.685	0.013
15	7.950	46.685	8.000	46.687	0.035
16	8.000	46.687	9.000	46.853	0.035

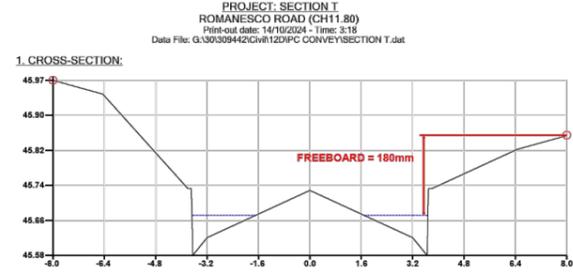


2. DISCHARGE INFORMATION:
 100 year (1%) storm event
 Total discharge = 0.192 cumecs
 There is no pipe discharge
 Overland / Channel / Watercourse discharge = 0.192 cumecs
 3. RESULTS: Water surface elevation = 45.671m
 High Flow Channel grade = 1 in 22.222, Main Channel / Low Flow Channel grade = 1 in 22.222.

	LEFT OVERBANK	MAIN CHANNEL	RIGHT OVERBANK	TOTAL CROSS-SECTION
Discharge (cumecs):	0.00	0.24	0.00	0.24
D(Max) = Max. Depth (m):	0.00	0.09	0.00	0.09
D(Ave) = Ave. Depth (m):	0.00	0.04	0.00	0.04
V = Ave. Velocity (m/s):	0.00	1.72	0.00	1.72
D(Max) x V (cumecs/m):	0.00	0.15	0.00	0.15
D(Ave) x V (cumecs/m):	0.00	0.06	0.00	0.06
Froude Number:	0.00	2.92	0.00	N/A
Area (m ²):	0.00	0.14	0.00	0.14
Wetted Perimeter (m):	0.00	4.11	0.00	4.11
Flow Width (m):	0.00	3.97	0.00	3.97
Hydraulic Radius (m):	0.00	0.03	0.00	0.03
Composite Manning's n:	0.000	0.013	0.000	N/A
Split Flow?	-	-	-	Yes

4. CROSS-SECTION DATA:

SEGMENT NO.	LEFT HAND POINT CHAINAGE (m)	R.L. (m)	RIGHT HAND POINT CHAINAGE (m)	R.L. (m)	MANNING'S N
1	-8.000	45.974	-7.950	45.973	0.035
2	-7.950	45.973	-6.450	45.943	0.013
3	-6.450	45.943	-3.800	45.731	0.035
4	-3.800	45.731	-3.690	45.731	0.013
5	-3.690	45.731	-3.650	45.581	0.013
6	-3.650	45.581	-3.200	45.621	0.013
7	-3.200	45.621	0.000	45.727	0.013
8	0.000	45.727	3.200	45.621	0.013
9	3.200	45.621	3.650	45.581	0.013
10	3.650	45.581	3.690	45.731	0.013
11	3.690	45.731	3.800	45.731	0.013
12	3.800	45.731	6.450	45.819	0.035
13	6.450	45.819	7.950	45.849	0.013
14	7.950	45.849	8.000	45.851	0.035

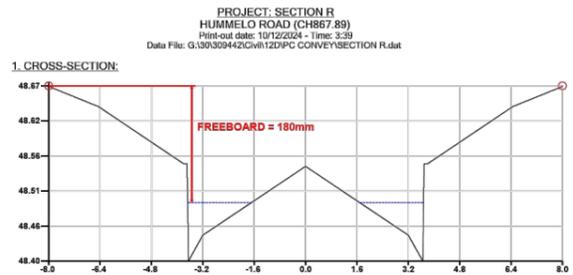


2. DISCHARGE INFORMATION:
 100 year (1%) storm event
 Total discharge = 0.062 cumecs
 There is no pipe discharge
 Overland / Channel / Watercourse discharge = 0.062 cumecs
 3. RESULTS: Water surface elevation = 48.491m
 High Flow Channel grade = 1 in 200, Main Channel / Low Flow Channel grade = 1 in 200.

	LEFT OVERBANK	MAIN CHANNEL	RIGHT OVERBANK	TOTAL CROSS-SECTION
Discharge (cumecs):	0.00	0.08	0.00	0.08
D(Max) = Max. Depth (m):	0.00	0.09	0.00	0.09
D(Ave) = Ave. Depth (m):	0.00	0.04	0.00	0.04
V = Ave. Velocity (m/s):	0.00	0.57	0.00	0.57
D(Max) x V (cumecs/m):	0.00	0.05	0.00	0.05
D(Ave) x V (cumecs/m):	0.00	0.02	0.00	0.02
Froude Number:	0.00	0.97	0.00	N/A
Area (m ²):	0.00	0.14	0.00	0.14
Wetted Perimeter (m):	0.00	4.11	0.00	4.11
Flow Width (m):	0.00	3.97	0.00	3.97
Hydraulic Radius (m):	0.00	0.03	0.00	0.03
Composite Manning's n:	0.000	0.013	0.000	N/A
Split Flow?	-	-	-	Yes

4. CROSS-SECTION DATA:

SEGMENT NO.	LEFT HAND POINT CHAINAGE (m)	R.L. (m)	RIGHT HAND POINT CHAINAGE (m)	R.L. (m)	MANNING'S N
1	-8.000	48.671	-7.950	48.669	0.035
2	-7.950	48.669	-6.450	48.639	0.013
3	-6.450	48.639	-3.800	48.551	0.035
4	-3.800	48.551	-3.690	48.551	0.013
5	-3.690	48.551	-3.650	48.401	0.013
6	-3.650	48.401	-3.200	48.441	0.013
7	-3.200	48.441	0.000	48.547	0.013
8	0.000	48.547	3.200	48.441	0.013
9	3.200	48.441	3.650	48.401	0.013
10	3.650	48.401	3.690	48.551	0.013
11	3.690	48.551	3.800	48.551	0.013
12	3.800	48.551	6.450	48.639	0.035
13	6.450	48.639	7.950	48.669	0.013
14	7.950	48.669	8.000	48.671	0.035

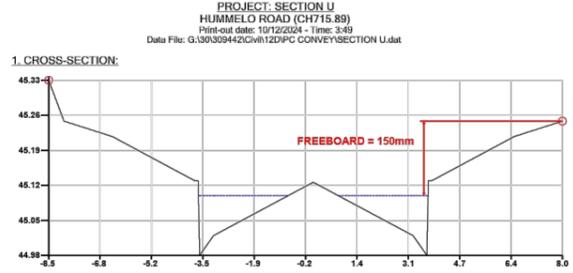

2. DISCHARGE INFORMATION:
 100 year (1%) storm event
 Total discharge = 0.317 cumecs
 There is no pipe discharge
 Overland / Channel / Watercourse discharge = 0.317 cumecs
 3. RESULTS: Water surface elevation = 45.098m
 High Flow Channel grade = 1 in 50, Main Channel / Low Flow Channel grade = 1 in 50.

	LEFT OVERBANK	MAIN CHANNEL	RIGHT OVERBANK	TOTAL CROSS-SECTION
Discharge (cumecs):	0.00	0.41	0.00	0.41
D(Max) = Max. Depth (m):	0.00	0.12	0.00	0.12
D(Ave) = Ave. Depth (m):	0.00	0.05	0.00	0.05
V = Ave. Velocity (m/s):	0.00	1.44	0.00	1.44
D(Max) x V (cumecs/m):	0.00	0.17	0.00	0.17
D(Ave) x V (cumecs/m):	0.00	0.07	0.00	0.07
Froude Number:	0.00	2.06	0.00	N/A
Area (m ²):	0.00	0.29	0.00	0.29
Wetted Perimeter (m):	0.00	5.94	0.00	5.94
Flow Width (m):	0.00	5.75	0.00	5.75
Hydraulic Radius (m):	0.00	0.05	0.00	0.05
Composite Manning's n:	0.000	0.013	0.000	N/A
Split Flow?	-	-	-	Yes

4. CROSS-SECTION DATA:

SEGMENT NO.	LEFT HAND POINT CHAINAGE (m)	R.L. (m)	RIGHT HAND POINT CHAINAGE (m)	R.L. (m)	MANNING'S N
1	-8.491	45.330	-8.000	45.248	0.013
2	-8.000	45.248	-7.950	45.247	0.035
3	-7.950	45.247	-6.450	45.217	0.013
4	-6.450	45.217	-3.800	45.128	0.035
5	-3.800	45.128	-3.690	45.128	0.013
6	-3.690	45.128	-3.650	44.978	0.013
7	-3.650	44.978	-3.200	45.018	0.013
8	-3.200	45.018	0.000	45.018	0.013
9	0.000	45.125	3.200	45.018	0.013
10	3.200	45.018	3.650	44.978	0.013
11	3.650	44.978	3.690	45.128	0.013
12	3.690	45.128	3.800	45.128	0.013
13	3.800	45.128	6.450	45.217	0.035
14	6.450	45.217	7.950	45.247	0.013



2. DISCHARGE INFORMATION:
 100 year (1%) storm event
 Total discharge = 0.132 cumecs
 There is no pipe discharge
 Overland / Channel / Watercourse discharge = 0.132 cumecs
 3. RESULTS: Water surface elevation = 47.888m
 High Flow Channel grade = 1 in 37.6598, Main Channel / Low Flow Channel grade = 1 in 37.6598.

	LEFT OVERBANK	MAIN CHANNEL	RIGHT OVERBANK	TOTAL CROSS-SECTION
Discharge (cumecs):	0.00	0.13	0.00	0.13
D(Max) = Max. Depth (m):	0.00	0.08	0.00	0.08
D(Ave) = Ave. Depth (m):	0.00	0.03	0.00	0.03
V = Ave. Velocity (m/s):	0.00	1.21	0.00	1.21
D(Max) x V (cumecs/m):	0.00	0.10	0.00	0.10
D(Ave) x V (cumecs/m):	0.00	0.04	0.00	0.04
Froude Number:	0.00	2.19	0.00	N/A
Area (m ²):	0.00	0.10	0.00	0.10
Wetted Perimeter (m):	0.00	3.46	0.00	3.46
Flow Width (m):	0.00	3.34	0.00	3.34
Hydraulic Radius (m):	0.00	0.03	0.00	0.03
Composite Manning's n:	0.000	0.013	0.000	N/A
Split Flow?	-	-	-	Yes


4. CROSS-SECTION DATA:

SEGMENT NO.	LEFT HAND POINT CHAINAGE (m)	R.L. (m)	RIGHT HAND POINT CHAINAGE (m)	R.L. (m)	MANNING'S N
1	-8.000	48.078	-7.950	48.077	0.035
2	-7.950	48.077	-6.450	48.047	0.013
3	-6.450	48.047	-3.800	47.958	0.035
4	-3.800	47.958	-3.690	47.958	0.013
5	-3.690	47.958	-3.650	47.808	0.013
6	-3.650	47.808	-3.200	47.848	0.013
7	-3.200	47.848	0.000	47.955	0.013
8	0.000	47.955	3.200	47.848	0.013
9	3.200	47.848	3.650	47.808	0.013
10	3.650	47.808	3.690	47.958	0.013
11	3.690	47.958	3.800	47.958	0.013
12	3.800	47.958	6.450	48.047	0.035
13	6.450	48.047	7.950	48.077	0.013
14	7.950	48.077	8.000	48.078	0.035



2. DISCHARGE INFORMATION:
 100 year (1%) storm event
 Total discharge = 1.31 cumecs
 There is no pipe discharge
 Overland / Channel / Watercourse discharge = 1.314 cumecs
 3. RESULTS: Water surface elevation = 44.220m
 High Flow Channel grade = 1 in 200, Main Channel / Low Flow Channel grade = 1 in 200.

	LEFT OVERBANK	MAIN CHANNEL	RIGHT OVERBANK	TOTAL CROSS-SECTION
Discharge (cumecs):	0.00	1.17	0.00	1.17
D(Max) = Max. Depth (m):	0.00	0.14	0.00	0.14
D(Ave) = Ave. Depth (m):	0.00	0.06	0.00	0.06
V = Ave. Velocity (m/s):	0.00	0.81	0.00	0.81
D(Max) x V (cumecs/m):	0.00	0.11	0.00	0.11
D(Ave) x V (cumecs/m):	0.00	0.05	0.00	0.05
Froude Number:	0.00	1.06	0.00	1.06
Area (m ²):	0.00	0.21	0.00	0.21
Wetted Perimeter (m):	0.00	3.62	0.00	3.62
Flow Width (m):	0.00	3.51	0.00	3.51
Hydraulic Radius (m):				

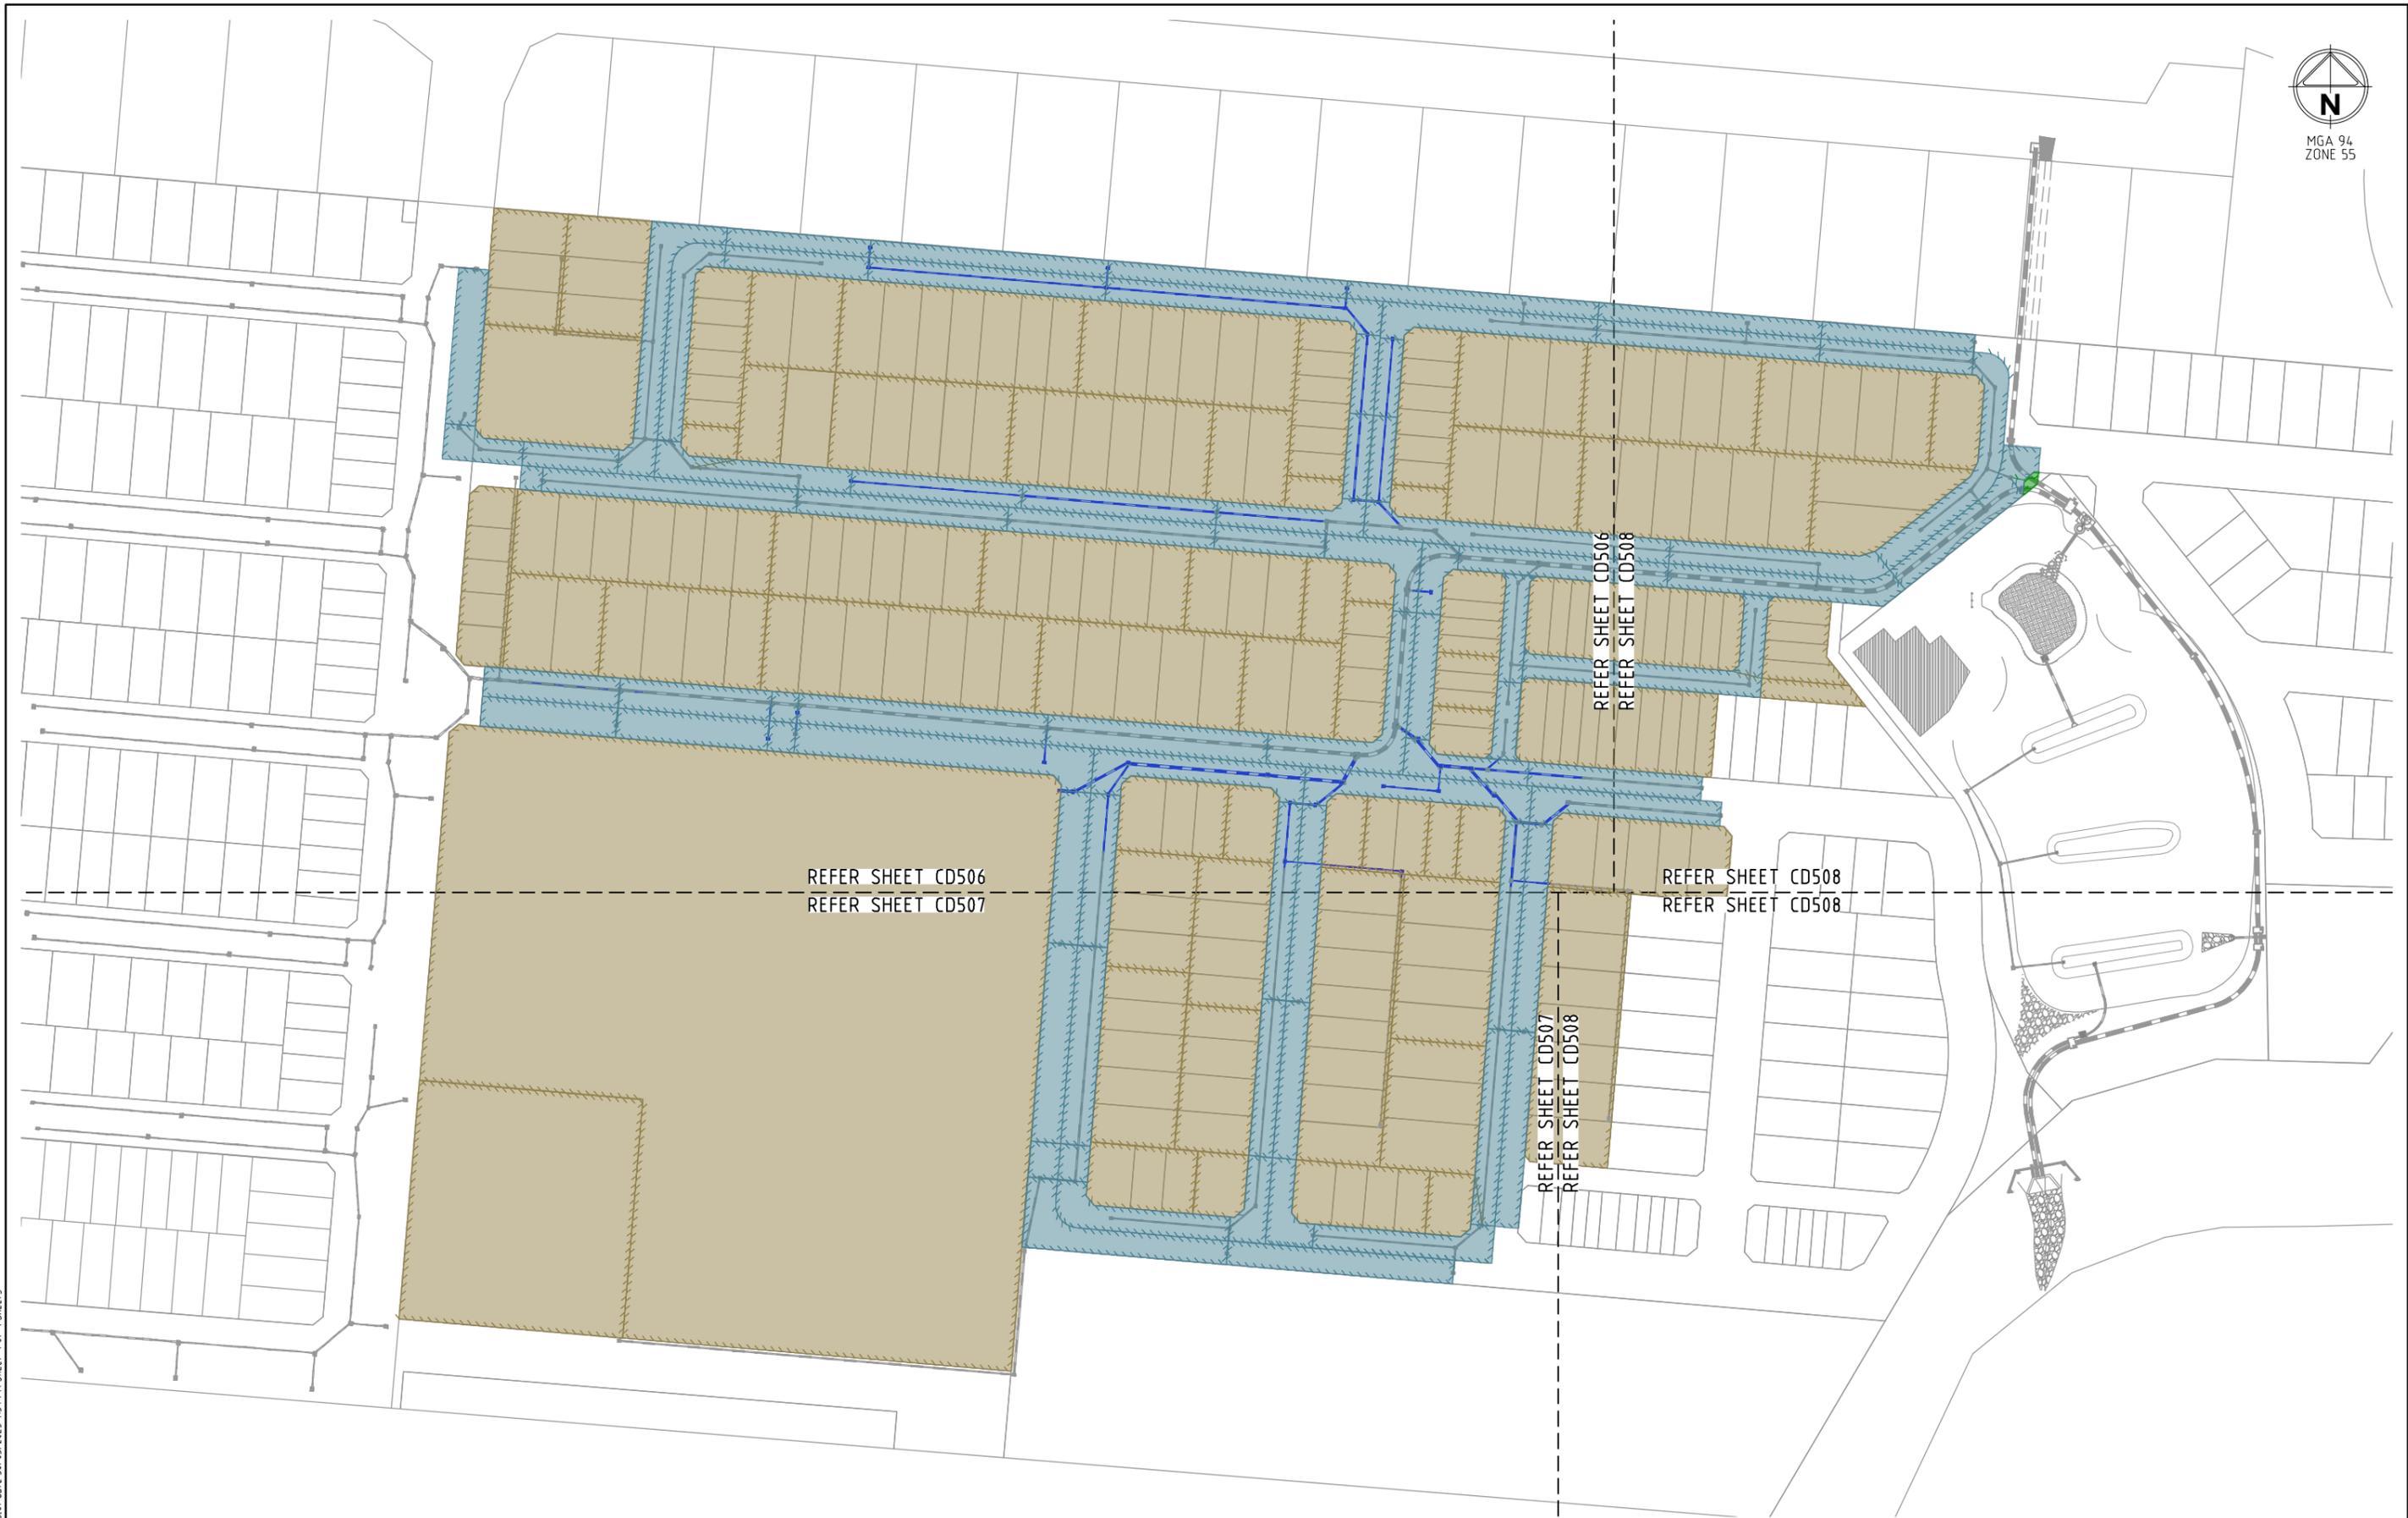

file name: 309443CD505.dwg, layout name: CD505, plotted by: Thinh Nguyen,
 file location: G:\309443 CD505\A1.dwg, plot date: 30/05/2025 4:34 PM, sheet: 1 of 1 sheets

Rev	Amendments	Approved	Date
A	ISSUED TO COUNCIL	G.K	04/04/25



System Certified

© Spiire Australia Pty Ltd All Rights Reserved
 This document is produced by Spiire Australia Pty Ltd solely for the benefit of and use by the client in accordance with the terms of the retainer. Spiire Australia Pty Ltd does not and shall not assume any responsibility or liability whatsoever to any third party arising out of any use or reliance by third party on the content of this document.

L6 414 LA TROBE STREET PO BOX 16084 MELBOURNE
 VICTORIA 8007 AUSTRALIA T 61 3 9993 7888
 spiire.com.au ABN 55 050 029 635

Designed
 T. NGUYEN

Checked
 G. KOHLMAN


Authorised
 G. KOHLMAN

Date
 04/04/25

**HARLOW ESTATE
 STAGE 7
 DRAINAGE COMPUTATIONS
 5YR CATCHMENT PLAN - SHEET 1**
 WYNDHAM CITY COUNCIL
 SIG GROUP


Drw No
309443CD505

Rev
A

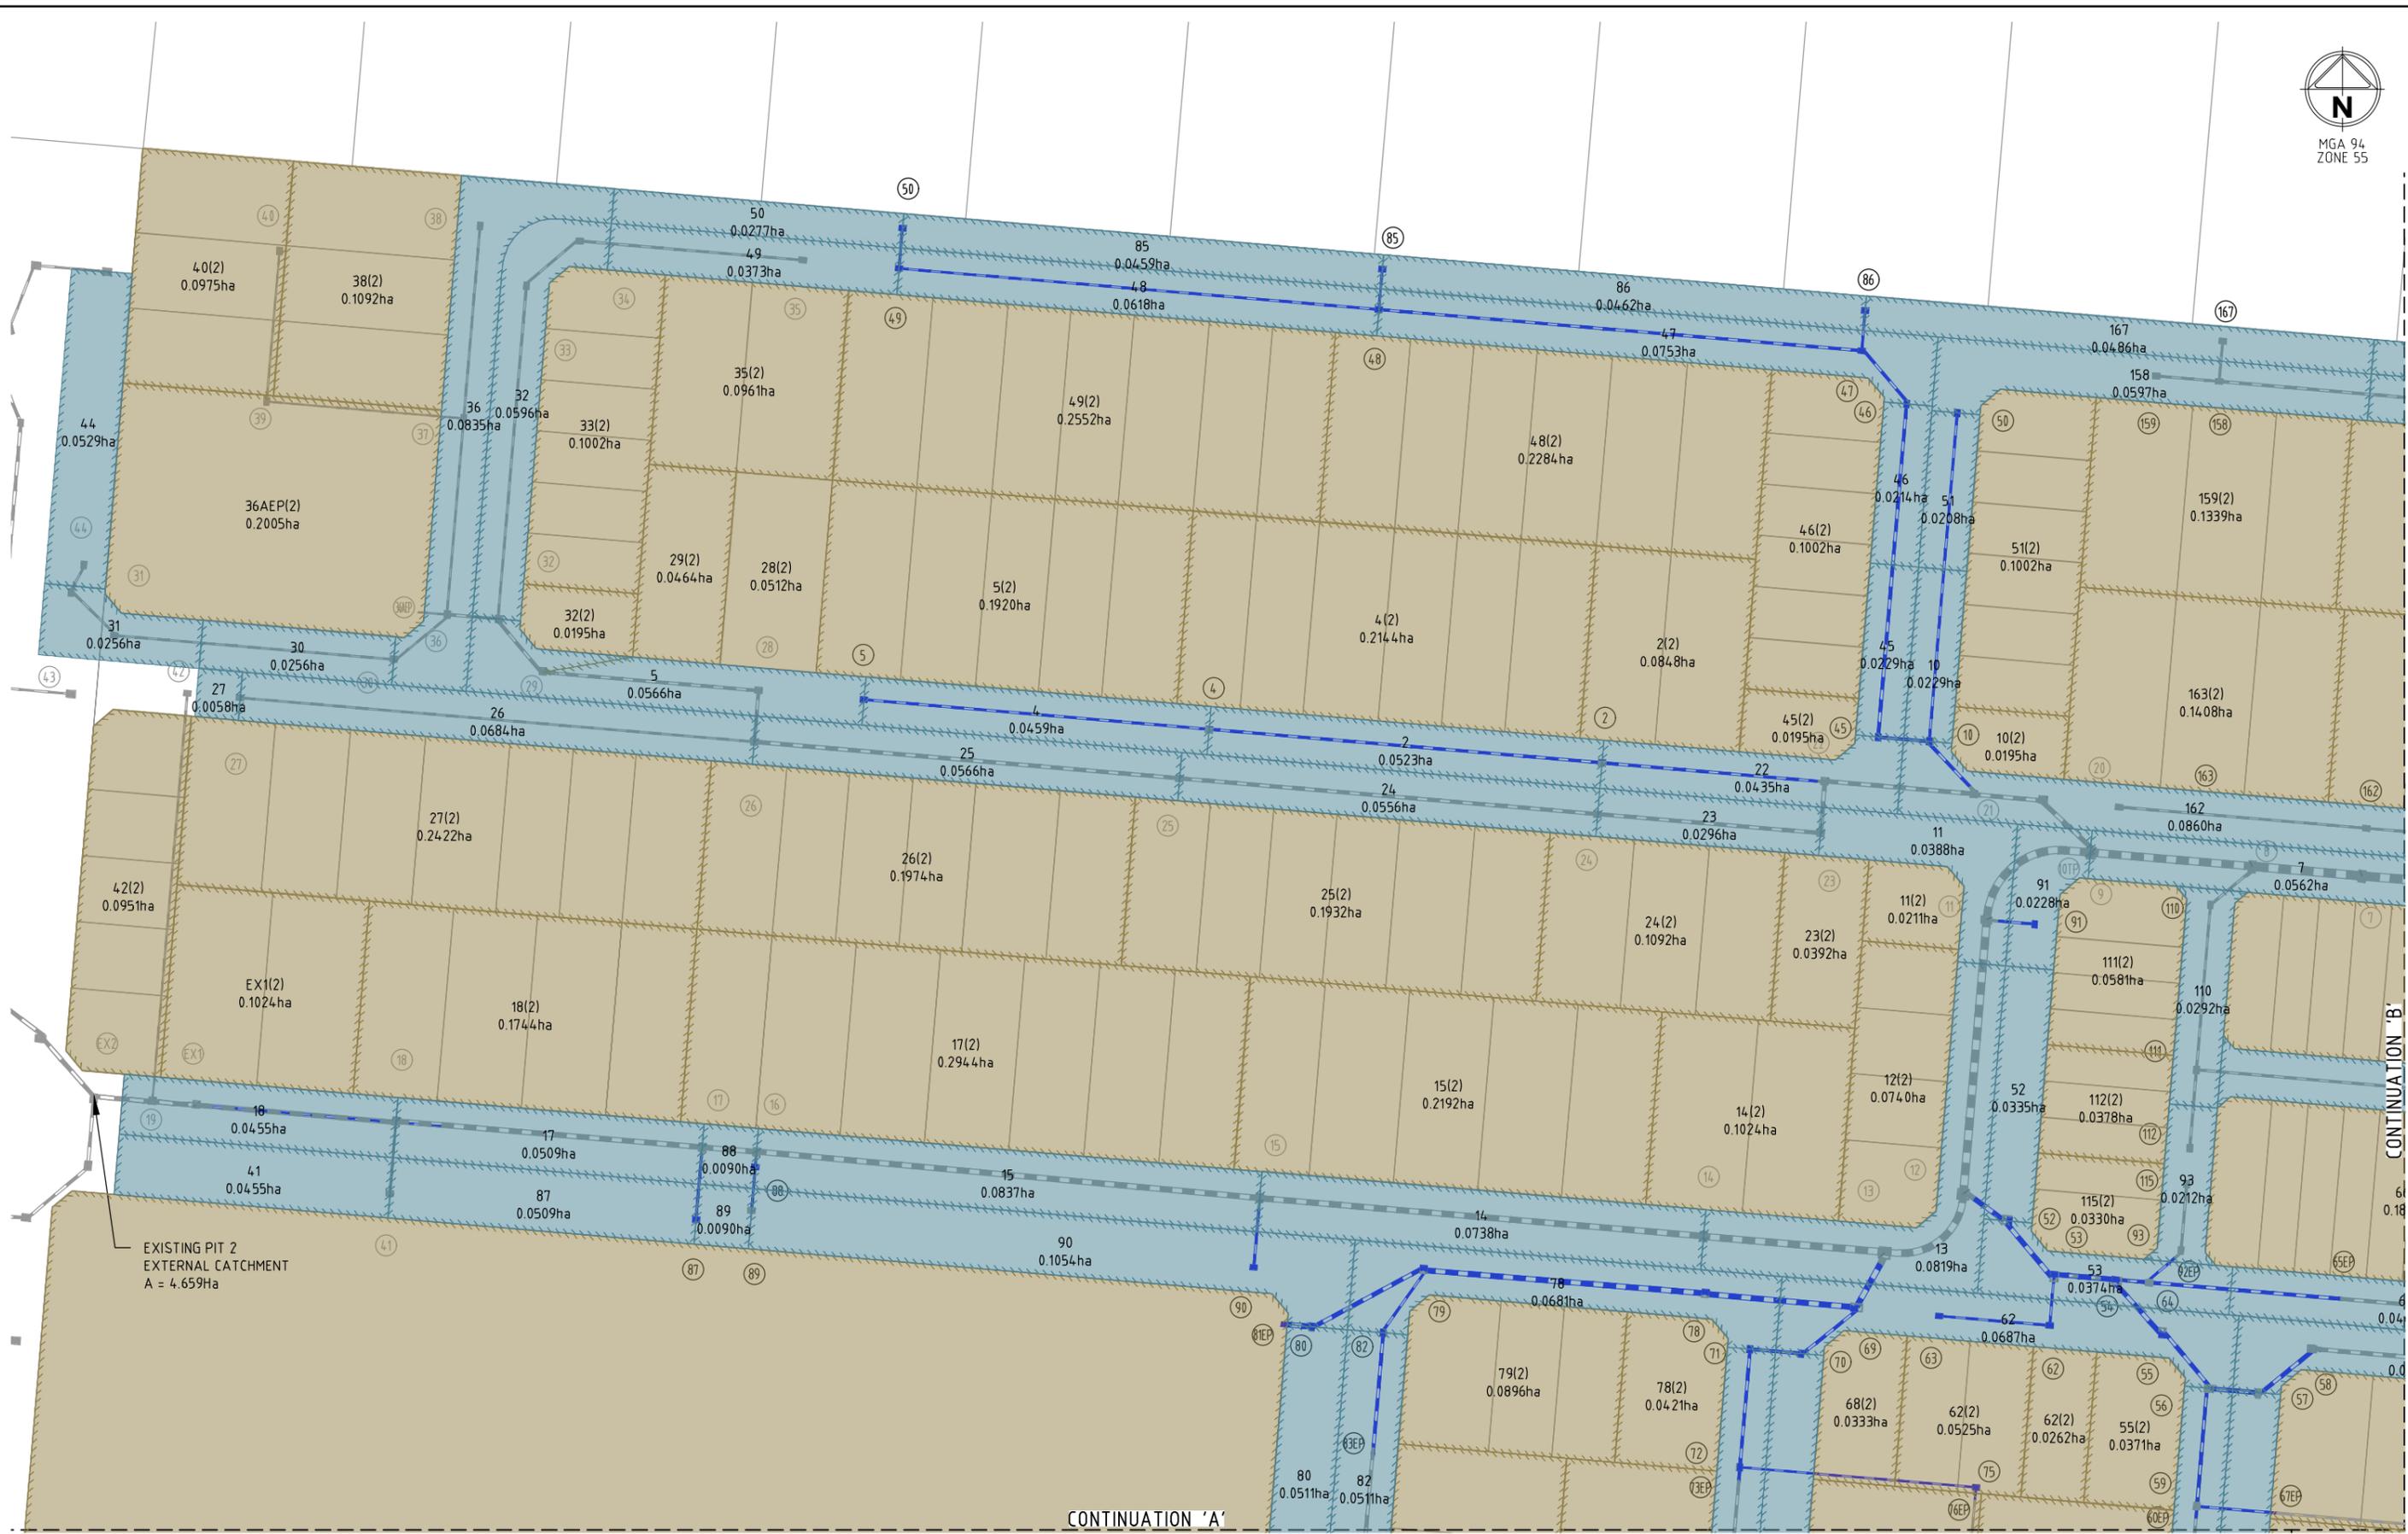

file name: 309443CD506.dwg, layout name: CD506, plot date: 30/05/2025 4:34 PM, sheet: 1 of 1 sheets
 file location: G:\309443 CD506\LA02.dwg

Rev	Amendments	Approved	Date
A	ISSUED TO COUNCIL	G.K	04/04/25

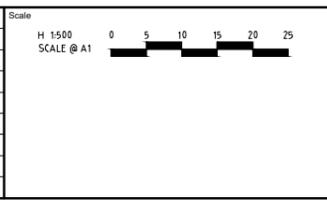

System Certified

© Spiire Australia Pty Ltd All Rights Reserved
 This document is produced by Spiire Australia Pty Ltd solely for the benefit of and use by the client in accordance with the terms of the retainer. Spiire Australia Pty Ltd does not and shall not assume any responsibility or liability whatsoever to any third party arising out of any use or reliance by third party on the content of this document.

L6 414 LA TROBE STREET PO BOX 16084 MELBOURNE
 VICTORIA 3007 AUSTRALIA T 61 3 9993 7888
 spiire.com.au ABN 55 050 029 635

Designed
 T. NGUYEN

Checked
 G. KOHLMAN


Authorised
 G. KOHLMAN

Date
 04/04/25

**HARLOW ESTATE
 STAGE 7
 DRAINAGE COMPUTATIONS
 5YR CATCHMENT PLAN - SHEET 2
 WYNDHAM CITY COUNCIL
 SIG GROUP**


Drg No
309443CD506

Rev
A

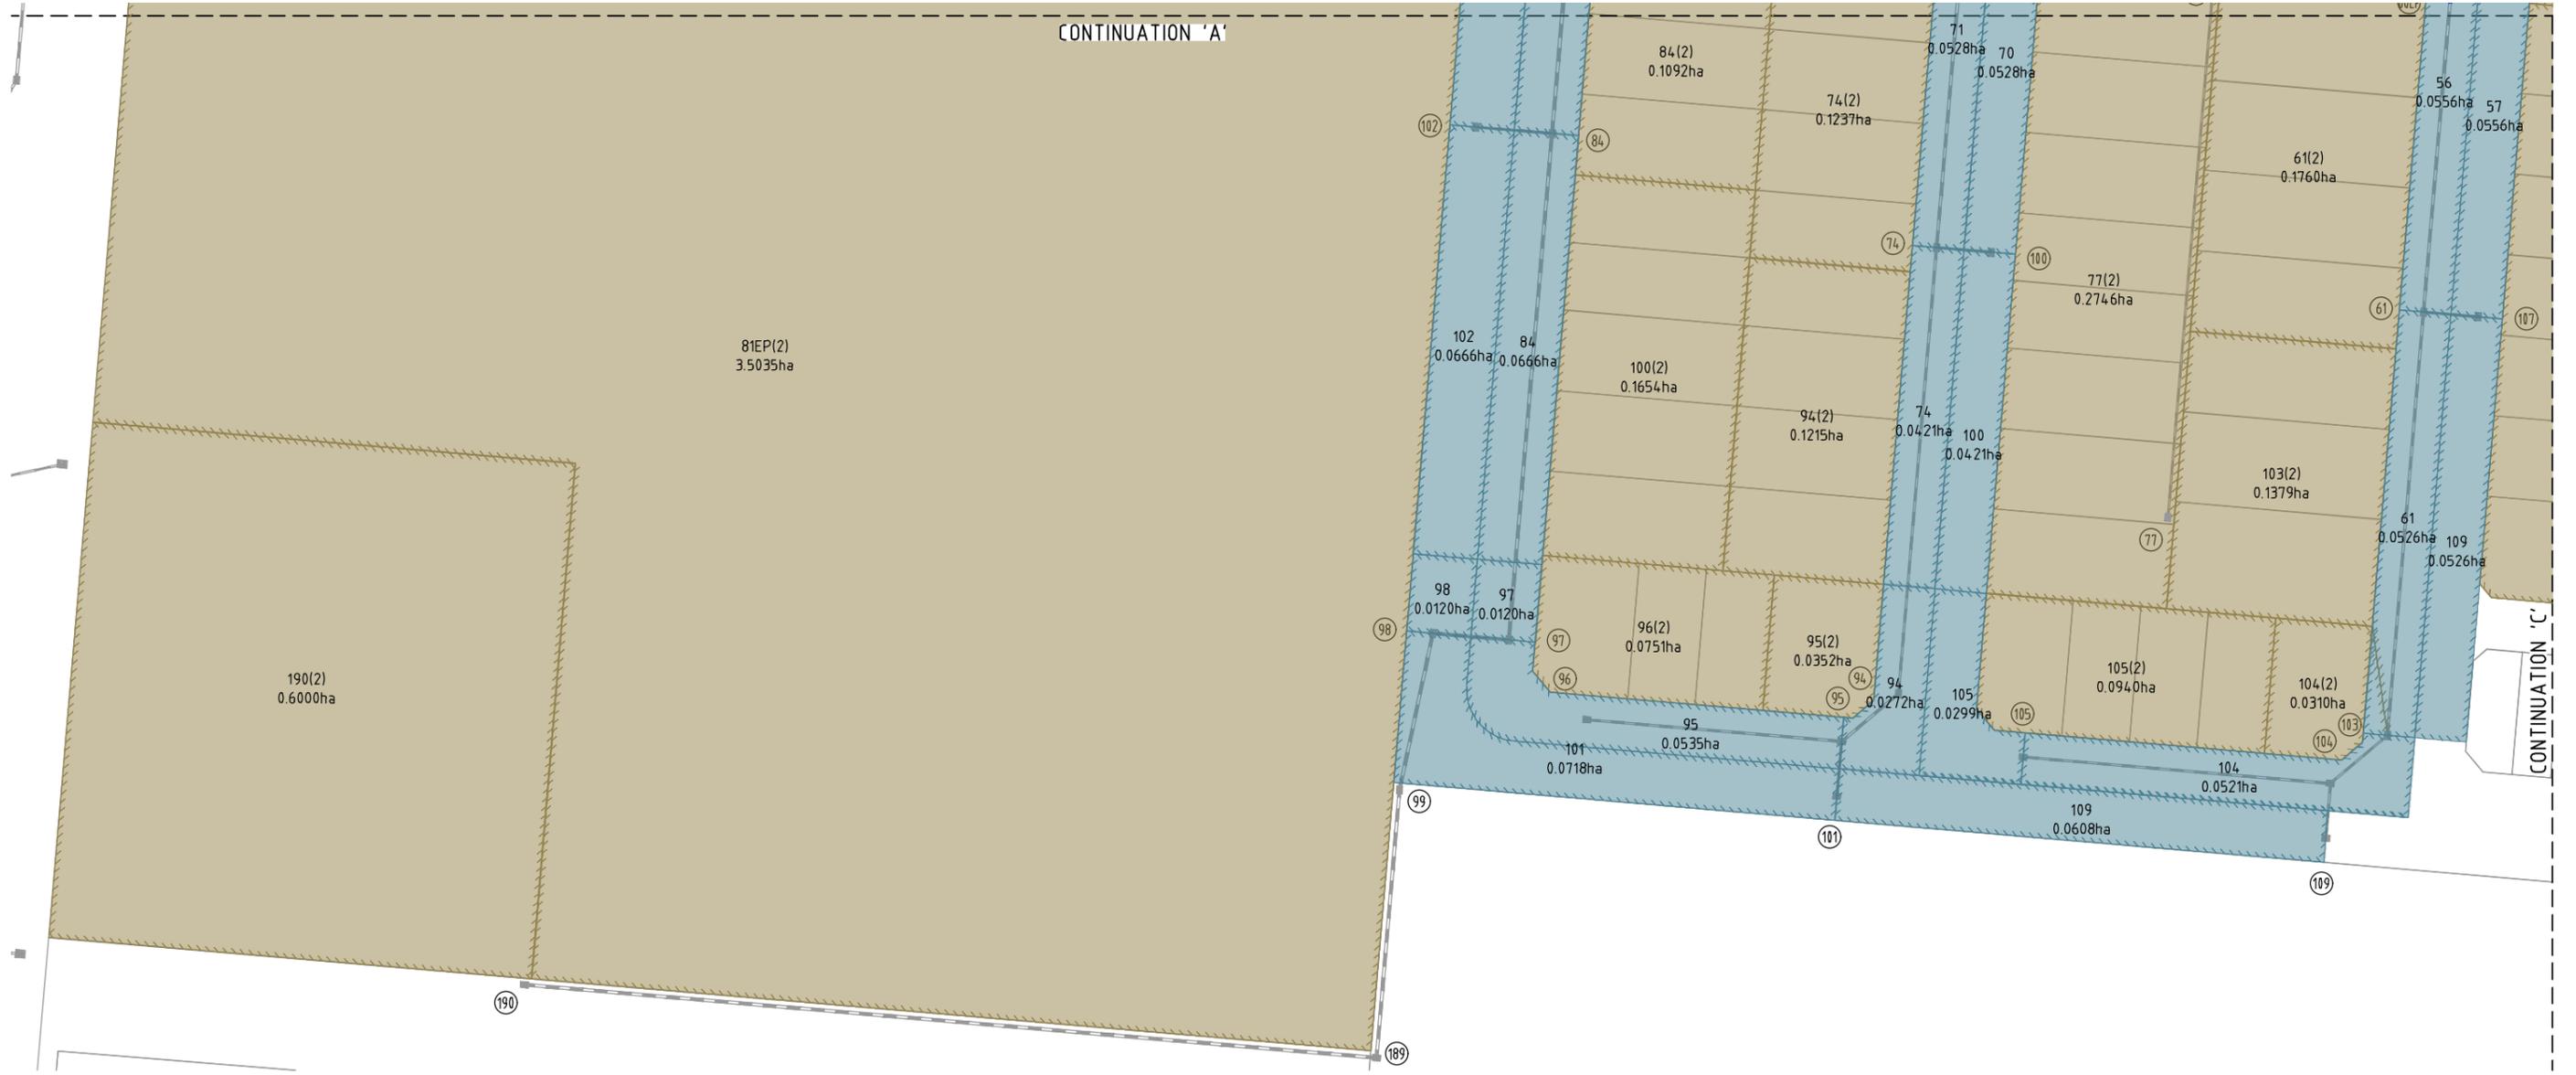

file name: 309443CD507.dwg, layout name: CD507, plotted by: Thinh Nguyen, file location: G:\309443\CD507\A1.dwg, plot date: 30/05/2025 4:34 PM, sheet: 1 of 1 sheets

Rev	Amendments	Approved	Date
A	ISSUED TO COUNCIL	G.K	04/04/25

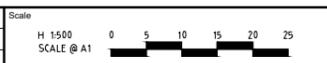

System Certified

© Spiire Australia Pty Ltd All Rights Reserved
This document is produced by Spiire Australia Pty Ltd solely for the benefit of and use by the client in accordance with the terms of the retainer. Spiire Australia Pty Ltd does not and shall not assume any responsibility or liability whatsoever to any third party arising out of any use or reliance by third party on the content of this document.

L6 414 LA TROBE STREET PO BOX 16084 MELBOURNE
VICTORIA 8007 AUSTRALIA T 61 3 9993 7888
spiire.com.au ABN 55 050 029 635

Designed
T. NGUYEN

Checked
G. KOHLMAN


Authorised
G. KOHLMAN

Date
04/04/25

**HARLOW ESTATE
STAGE 7
DRAINAGE COMPUTATIONS
5YR CATCHMENT PLAN - SHEET 3**
WYNDHAM CITY COUNCIL
SIG GROUP

Drw No
309443CD507

Rev
A

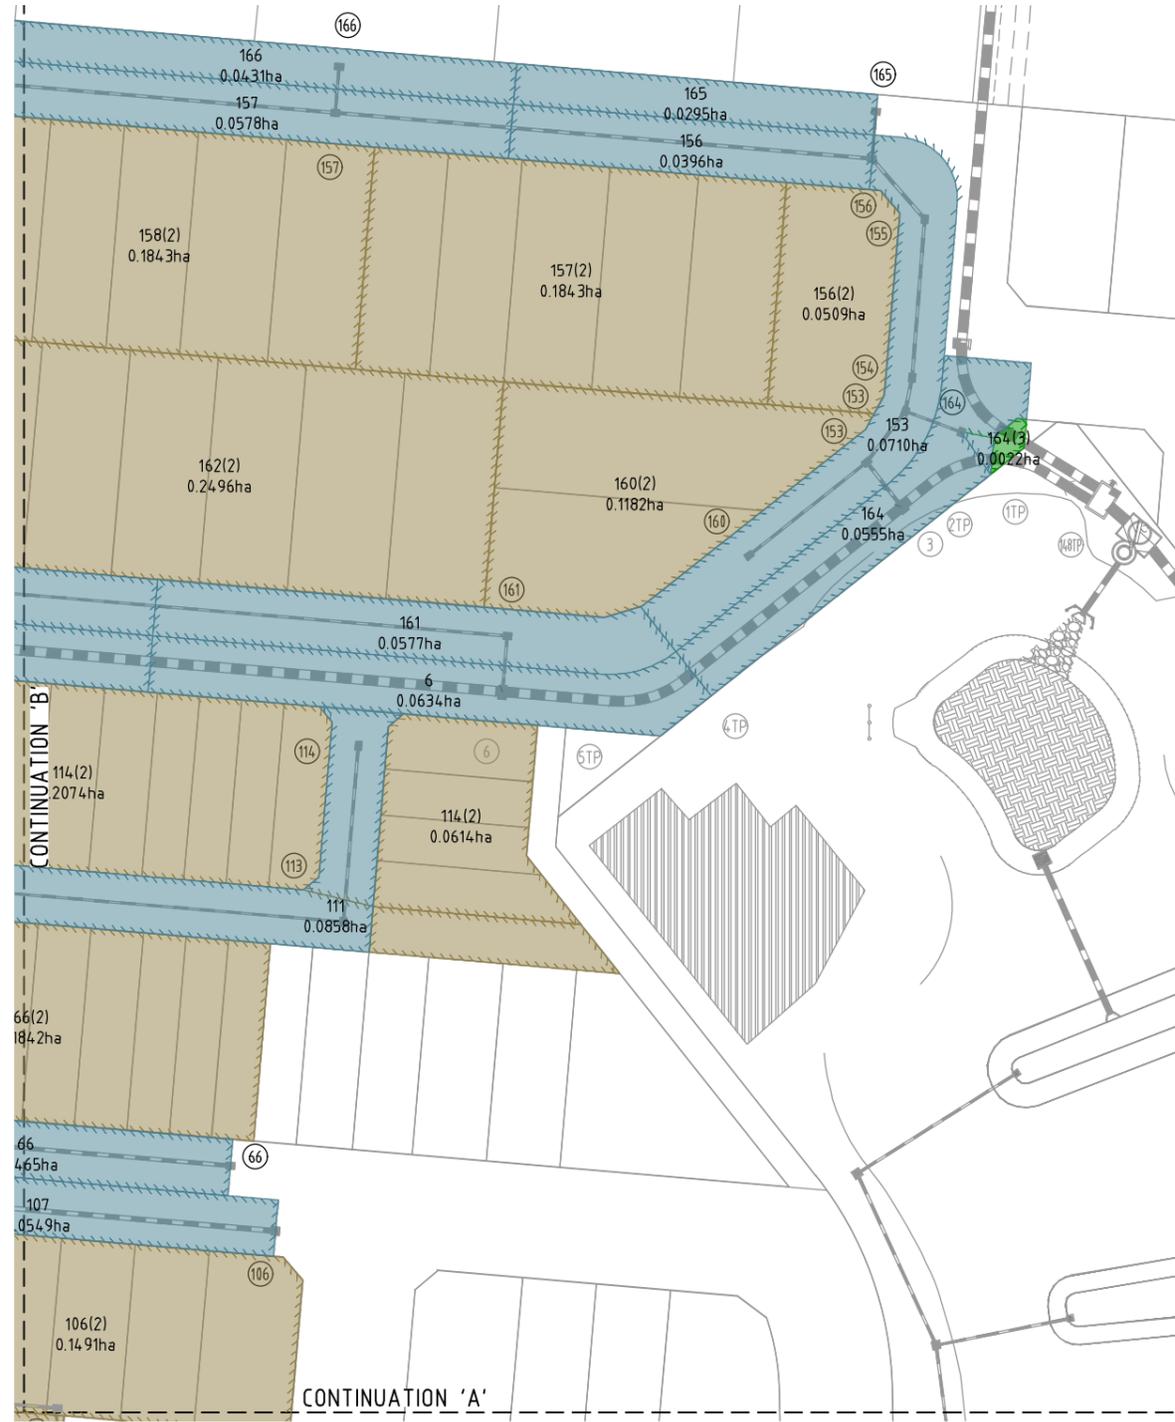

file name: 309443CD508.dwg, layout name: CD508, plotted by: Thanh Nguyen,
file location: G:\309443 CD508\CD508.dwg, plot date: 30/05/2025 4:34 PM, sheet: 1 of 1 sheets

Rev	Amendments	Approved	Date
A	ISSUED TO COUNCIL	G.K	04/04/25



System Certified

© Spiire Australia Pty Ltd All Rights Reserved
This document is produced by Spiire Australia Pty Ltd solely for the benefit of and use by the client in accordance with the terms of the retainer. Spiire Australia Pty Ltd does not and shall not assume any responsibility or liability whatsoever to any third party arising out of any use or reliance by third party on the content of this document.

L6 414 LA TROBE STREET PO BOX 16084 MELBOURNE
VICTORIA 3007 AUSTRALIA T 61 3 9993 7888
spiire.com.au ABN 55 050 029 635

Designed
T. NGUYEN

Checked
G. KOHLMAN

Authorised
G. KOHLMAN

Date
04/04/25

**HARLOW ESTATE
STAGE 7
DRAINAGE COMPUTATIONS
5YR CATCHMENT PLAN - SHEET 4
WYNDHAM CITY COUNCIL
SIG GROUP**

Drw No
309443CD508

Rev
A

STRUCTURE No.	DOWNSTREAM STRUCTURE No.	PIT TYPE	SUB-CATCHMENT RUNOFF						DRAIN DESIGN										HEADLOSSES						PART FULL				DESIGN LEVELS										
			C	A	C	A	C	A	Q	tc	i	A	C	CA	Qp	L	S	T	Qcap	Qa/Qcap	Vcap	TIME IN PIPE	V2/2g	Ku	hu	Kw	hw	Sf	hf	NORMAL DEPTH	NORMAL DEPTH VELOCITY	UPSTREAM PIPE H.G.L.	DOWNSTREAM PIPE H.G.L.	PIT GRADE LEVEL	CALCULATED FREEBOARD	STRUCTURE			
			CO-EFFICIENT OF RUNOFF	SUB-CATCHMENT AREA (ROAD) ha	CO-EFFICIENT OF RUNOFF	SUB-CATCHMENT AREA (LOT) ha	CO-EFFICIENT OF RUNOFF	SUB-CATCHMENT AREA (MISC) ha	SUB-CATCHMENT DISCHARGE l/s	CRITICAL TIME OF CONCENTRATION min	RAINFALL INTENSITY mm/hr	CUMULATIVE CATCHMENT AREA ha	EFFECTIVE CO-EFFICIENT OF RUNOFF	TOTAL (C x A) ha	PIPE FLOW l/s	REACH LENGTH m	PIPE GRADE (1 in)	PIPE DIAMETER mm	PIPE GRADE CAPACITY l/s	Q(actual) / Q(capacity) %	CAPACITY VELOCITY (Qcap/AREA) m/s	min	PIPE VELOCITY HEAD m	UIS PIT HEADLOSS COEFF	UIS PIT PRESSURE HEADLOSS m	W.S.E. COEFF	CHANGE IN W.S.E. m	PIPE FRICTION SLOPE %	PIPE FRICTION (HEADLOSS L'S)	m	m/s	m	m	m	m	m	m	m	m
148TP	1	TANGENT POINT							12.03	59.589	17.828	0.642	11.453	1896	4.57	500	1350	2388	80	1.668	0.046	0.090	0.00	0.000		0.000	0.126	0.006	0.909	1.85	46.499	46.493	47.741	1.242					
1TP	148TP	TANGENT POINT							12.00	59.652	17.828	0.642	11.453	1898	2.61	500	1350	2388	80	1.668	0.026	0.090	0.00	0.000		0.000	0.126	0.003	0.909	1.85	46.502	46.499	47.693	1.190					
2TP	1TP	TANGENT POINT							11.83	60.065	17.828	0.642	11.453	1911	17.09	500	1350	2388	81	1.668	0.171	0.091	0.00	0.000		0.000	0.128	0.022	0.914	1.85	46.524	46.502	47.478	0.954					
3	2TP	JUNCTION PIT						0	11.77	60.212	17.828	0.642	11.453	1916	6.07	500	1350	2388	81	1.668	0.061	0.091	0.50	0.046		0.046	0.129	0.008	0.916	1.85	46.532	46.524	47.564	0.986					
4TP	3	TANGENT POINT							11.37	61.176	16.750	0.642	10.750	1827	39.87	500	1350	2388	77	1.668	0.398	0.083	0.00	0.000		0.000	0.117	0.047	0.885	1.84	46.625	46.578	47.735	1.115					
5TP	4TP	TANGENT POINT							11.27	61.431	16.750	0.642	10.750	1834	10.57	500	1350	2388	78	1.668	0.106	0.084	0.00	0.000		0.000	0.118	0.012	0.887	1.84	46.637	46.625	47.756	1.119					
6	5TP	JUNCTION PIT	0.561	0.063				8	11.11	61.812	16.750	0.642	10.750	1846	15.76	500	1350	2388	78	1.668	0.157	0.085	0.50	0.042		0.042	0.119	0.019	0.891	1.84	46.656	46.637	47.523	0.824					
7	6	JUNCTION PIT	0.561	0.056				8	10.36	63.626	16.152	0.641	10.358	1831	75.00	500	1350	2388	78	1.668	0.749	0.083	0.50	0.042		0.042	0.118	0.088	0.886	1.84	46.787	46.699	47.648	0.819					
8	7	JUNCTION PIT						0	10.18	64.067	16.096	0.642	10.326	1838	18.28	500	1350	2388	78	1.668	0.183	0.084	0.50	0.042		0.042	0.118	0.022	0.888	1.84	46.851	46.829	47.926	1.033					
9	8	JUNCTION PIT						0	9.91	64.889	15.616	0.641	10.004	1803	26.95	500	1350	2388	77	1.668	0.269	0.081	0.70	0.057		0.057	0.114	0.031	0.877	1.83	46.924	46.893	48.049	1.069					
10TP	9	TANGENT POINT							13.14	56.904	13.705	0.631	8.650	1367	4.65	500	1200	1744	79	1.542	0.050	0.075	0.00	0.000		0.000	0.123	0.006	0.800	1.71	46.986	46.981	47.979	0.989					
11	10TP	GRATED SIDE ENTRY PIT	0.561	0.039	0.708	0.021		9	12.94	57.397	13.705	0.631	8.650	1379	18.86	500	1200	1744	80	1.542	0.204	0.076	0.50	0.038		0.038	0.125	0.024	0.805	1.71	47.010	46.986	48.093	1.044					
12	11	JUNCTION PIT			0.708	0.074		13	9.16	68.112	11.789	0.632	7.456	1411	45.85	500	1200	1744	82	1.542	0.495	0.079	0.50	0.040		0.040	0.131	0.060	0.819	1.72	47.109	47.049	48.043	0.894					
12ATP	12	TANGENT POINT							12.27	58.998	11.748	0.627	7.365	1207	15.73	400	1050	1366	89	1.577	0.166	0.099	0.00	0.000		0.000	0.195	0.031	0.767	1.78	47.180	47.149	47.914	0.735					
13	12ATP	GRATED SIDE ENTRY PIT	0.561	0.082				11	12.26	59.031	11.748	0.627	7.365	1208	1.28	400	1050	1366	89	1.578	0.014	0.099	1.50	0.149		0.149	0.195	0.002	0.768	1.78	47.182	47.180	47.978	0.375					
14	13	GRATED SIDE ENTRY PIT	0.561	0.074	0.708	0.102		27	12.65	58.096	6.121	0.585	3.579	578	30.47	263	1050	1683	34	1.944	0.261	0.023	0.50	0.011		0.011	0.045	0.014	0.424	1.76	47.347	47.333	47.810	0.451					
15	14	GRATED SIDE ENTRY PIT	0.561	0.084	0.708	0.219		48	11.90	59.907	5.945	0.583	3.465	577	73.83	300	900	1046	55	1.644	0.749	0.042	0.50	0.021		0.021	0.101	0.075	0.477	1.68	47.433	47.358	48.056	0.602					
16	15	JUNCTION PIT						0	11.19	61.617	5.536	0.579	3.204	548	83.72	185	825	1056	52	1.975	0.706	0.054	0.50	0.027		0.027	0.146	0.122	0.422	1.99	47.576	47.454	48.608	1.005					
17	16	GRATED SIDE ENTRY PIT	0.561	0.051	0.708	0.294		57	11.10	61.845	5.518	0.579	3.194	549	9.03	250	750	704	78	1.594	0.094	0.079	0.50	0.039		0.039	0.243	0.022	0.498	1.78	47.625	47.603	48.365	0.728					
18	17	GRATED SIDE ENTRY PIT	0.561	0.046	0.708	0.174		36	10.57	63.130	5.122	0.572	2.928	513	50.92	249	750	706	73	1.598	0.531	0.069	0.50	0.034		0.034	0.213	0.108	0.475	1.74	47.773	47.684	48.535	0.824					
EX1	18	JUNCTION PIT			0.708	0.102		17	10.33	63.710	4.856	0.567	2.754	487	33.19	104	675	826	59	2.308	0.240	0.095	0.50	0.047		0.047	0.336	0.111	0.373	2.40	47.918	47.807	48.820	0.810					
19	EX1	JUNCTION PIT						0	10.25	63.894	4.754	0.564	2.681	476	7.31	213	675	576	83	1.611	0.076	0.090	0.50	0.045		0.045	0.320	0.023	0.468	1.80	47.989	47.968	48.845	0.854					
EX2	19	JUNCTION PIT	0.561	4.659				466	10.15	64.137	4.659	0.561	2.614	466	9.22	213	675	576	81	1.611	0.101	0.086	0.43	0.037		0.037	0.307	0.030	0.460	1.79	48.064	48.034	48.874	0.773					
20	9	JUNCTION PIT						0	8.80	69.655	3.641	0.667	2.428	470	12.55	63	675	1063	44	2.970	0.070	0.088	0.90	0.079		0.079	0.312	0.039	0.314	2.98	47.020	46.981	48.083	0.984					
21	20	JUNCTION PIT						0	8.71	70.029	3.641	0.667	2.428	472	11.34	100	600	614	77	2.173	0.087	0.142	1.40	0.199		0.199	0.591	0.067	0.395	2.40	47.166	47.099	48.138	0.774					
22	21	GRATED SIDE ENTRY PIT	0.561	0.044				6	8.70	70.108	2.561	0.671	1.719	335	24.80	65	600	761	44	2.691	0.154	0.072	1.80	0.129		0.129	0.297	0.074	0.279	2.60	47.439	47.365	48.096	0.531					
23	22	GRATED SIDE ENTRY PIT	0.561	0.030	0.708	0.039		11	8.66	70.273	1.882	0.673	1.267	247	8.50	276	600	370	67	1.307	0.108	0.039	1.50	0.059		0.059	0.162	0.014	0.359	1.40	47.581	47.568	48.096	0.458					
24	23	GRATED SIDE ENTRY PIT	0.561	0.056	0.708	0.109		26	8.15	72.469	1.813	0.674	1.222	246	37.06	270	525	262	94	1.209	0.511	0.066	0.50	0.033		0.033	0.327	0.121	0.405	1.37	47.671	47.640	48.284	0.489					
25	24	GRATED SIDE ENTRY PIT	0.561	0.057	0.708	0.193		40	7.57	74.962	1.680	0.676	1.143	238	69.54	300	525	248	96	1.147	1.010	0.062	0.50	0.031		0.031	0.306	0.213	0.412	1.31	48.007	47.794	48.631	0.594					
26	25	GRATED SIDE ENTRY PIT	0.561	0.068	0.708	0.197		43	6.54	79.378	1.441	0.676	0.974	215	70.70	300	525	248	86	1.147	1.027	0.050	2.00	0.100		0.100	0.249	0.176	0.377	1.29	48.214	48.038	49.095	0.781					
27	26	GRATED SIDE ENTRY PIT	0.561	0.006	0.708	0.242		42	5.00	86.000	0.248	0.705	0.175	42	85.50	89	300	103	41	1.454	0.980	0.018	5.00	0.089		0.089	0.186	0.159	0.133	1.38	48.473	48.314	49.605	1.043					
28	27	JUNCTION PIT			0.708	0.051		9	6.85	78.025	0.955	0.670	0.640	139	8.50	300	450	165	84	1.035	0.137	0.039	1.30	0.059		0.059	0.237	0.020	0.317	1.16	48.334	48.314	49.263	0.878					
29	28	JUNCTION PIT			0.708	0.046		8	6.36	80.163	0.908	0.668	0.607	135	35.90	300	450	165	82	1.035	0.578	0.037	0.60	0.022		0.022</													

STRUCTURE No.	DOWNSTREAM STRUCTURE No.	PIT TYPE	SUB-CATCHMENT RUNOFF						DRAIN DESIGN										HEADLOSSES						PART FULL		DESIGN LEVELS				STRUCTURE						
			C	A	C	A	C	A	Q	t _c	i	A	C	CA	Q _p	L	S	T	Q _{cap}	Q _a /Q _{cap}	V _{cap}	TIME IN PIPE	V _{2/2g}	K _u	h _u	K _w	h _w	S _f	h _f	NORMAL DEPTH		NORMAL DEPTH VELOCITY	UPSTREAM PIPE H.G.L.	DOWNSTREAM PIPE H.G.L.	PIT GRATE LEVEL	CALCULATED FREEBOARD	
			CO-EFFICIENT OF RUNOFF	SUB-CATCHMENT AREA (ROAD)	CO-EFFICIENT OF RUNOFF	SUB-CATCHMENT AREA (LOT)	CO-EFFICIENT OF RUNOFF	SUB-CATCHMENT AREA (MISC)	DISCHARGE	CRITICAL TIME OF CONCENTRATION	RAINFALL INTENSITY	CUMULATIVE CATCHMENT AREA	EFFECTIVE CO-EFFICIENT OF RUNOFF	TOTAL (C x A)	PIPE FLOW	REACH LENGTH	PIPE GRADE	PIPE DIAMETER	PIPE GRADE CAPACITY	Q(actual) / Q(capacity)	CAPACITY VELOCITY (Q _{cap} /AREA)	MIN	PIPE VELOCITY HEAD	U/S PIT HEADLOSS COEFF	U/S PIT PRESSURE HEADLOSS	W.S.E. COEFF	CHANGE IN W.S.E.	PIPE FRICTION SLOPE	PIPE FRICTION (HEADLOSS L/S)	M	M/S	M	M	M	M	M	M
81EP	80	ENDPIPE			0.635	3.503			452	8.00	73.100	3.503	0.635	2.225	452	5.10	400	825	718	63	1.343	0.063	0.036	0.00	0.000		0.000	0.099	0.005	0.475	1.42	47.849	47.844	48.476	0.627		
82	79	GRATED SIDE ENTRY PIT	0.561	0.051					7	11.41	61.095	1.083	0.842	0.911	155	12.82	250	450	180	86	1.134	0.188	0.048	0.70	0.034	0.034	0.294	0.038	0.321	1.27	47.673	47.635	48.154	0.447			
83EP	82	ENDPIPE							0	11.11	61.810	1.032	0.855	0.883	154	20.12	250	450	180	84	1.134	0.296	0.046	0.00	0.000	0.000	0.282	0.057	0.316	1.27	47.763	47.707	48.442	0.679			
84	83EP	GRATED SIDE ENTRY PIT	0.561	0.067	0.708	0.109			27	10.66	62.911	1.032	0.855	0.883	154	30.95	250	450	180	86	1.134	0.455	0.048	0.80	0.038	0.038	0.292	0.091	0.320	1.27	47.854	47.763	48.460	0.568			
85	48	GRATED SIDE ENTRY PIT	0.561	0.046					6	5.00	86.000	0.046	0.561	0.026	6	6.70	94	300	100	6	1.409	0.079	0.000	5.00	0.002	0.002	0.004	0.000	0.051	0.78	48.048	48.048	48.702	0.652			
86	47	GRATED SIDE ENTRY PIT	0.561	0.046					6	5.00	86.000	0.046	0.561	0.026	6	6.70	100	300	97	6	1.369	0.082	0.000	5.00	0.002	0.002	0.004	0.000	0.051	0.77	47.708	47.708	48.300	0.590			
87	17	GRATED SIDE ENTRY PIT	0.561	0.051					7	5.00	86.000	0.051	0.561	0.029	7	11.80	41	300	151	5	2.137	0.092	0.000	5.00	0.002	0.002	0.005	0.001	0.043	1.08	47.665	47.664	48.365	0.698			
88	16	GRATED SIDE ENTRY PIT	0.561	0.009					1	5.06	85.733	0.018	0.561	0.010	2	2.30	50	300	137	2	1.936	0.020	0.000	0.50	0.000	0.000	0.001	0.000	0.028	0.74	47.603	47.603	48.411	0.808			
89	88	GRATED SIDE ENTRY PIT	0.561	0.009					1	5.00	86.000	0.009	0.561	0.005	1	7.20	50	300	137	1	1.936	0.062	0.000	5.00	0.000	0.000	0.000	0.000	0.020	0.80	47.603	47.603	48.411	0.808			
90	15	GRATED SIDE ENTRY PIT	0.561	0.105					14	5.00	86.000	0.105	0.561	0.059	14	11.80	27	300	187	8	2.650	0.074	0.002	5.00	0.010	0.010	0.021	0.003	0.056	1.56	47.457	47.454	48.056	0.589			
91	11	GRATED SIDE ENTRY PIT	0.561	0.023					3	5.00	86.000	0.023	0.561	0.013	3	8.50	50	300	137	2	1.936	0.073	0.000	5.00	0.000	0.000	0.001	0.000	0.031	0.79	47.049	47.049	48.093	1.043			
92EP	64	ENDPIPE							0	5.09	85.592	0.054	0.650	0.035	8	6.08	17	300	235	4	3.319	0.031	0.001	0.00	0.000	0.000	0.007	0.000	0.039	1.56	47.215	47.215	48.080	0.865			
93	92EP	JUNCTION PIT	0.561	0.021					3	5.09	85.627	0.054	0.650	0.035	8	1.64	17	300	235	4	3.319	0.008	0.001	1.37	0.001	0.001	0.007	0.000	0.039	1.56	47.215	47.215	48.078	0.862			
94	74	GRATED SIDE ENTRY PIT	0.561	0.027	0.708	0.121			24	5.32	84.614	0.380	0.649	0.246	58	69.24	123	300	87	66	1.235	0.934	0.034	1.70	0.058	0.058	0.358	0.248	0.179	1.32	48.035	47.787	48.578	0.485			
95	94	GRATED SIDE ENTRY PIT	0.561	0.053	0.708	0.035			13	5.46	84.035	0.236	0.630	0.148	35	11.53	230	375	116	30	1.047	0.183	0.005	1.90	0.010	0.010	0.039	0.004	0.141	0.91	48.098	48.094	48.444	0.336			
96	95	GRATED SIDE ENTRY PIT	0.561	0.075	0.708	0.075			13	5.00	86.000	0.075	0.708	0.053	13	39.60	90	300	102	12	1.444	0.457	0.002	0.90	0.001	0.001	0.017	0.007	0.071	0.98	48.114	48.108	48.678	0.563			
97	84	GRATED SIDE ENTRY PIT	0.561	0.012	0.708	0.165			30	9.39	67.118	0.789	0.925	0.731	136	78.81	300	450	165	83	1.035	1.265	0.037	1.50	0.056	0.056	0.228	0.179	0.312	1.16	48.072	47.892	48.810	0.682			
98	97	GRATED SIDE ENTRY PIT	0.561	0.012					2	9.20	67.935	0.612	0.991	0.607	114	11.80	300	450	165	70	1.035	0.190	0.026	1.60	0.042	0.042	0.161	0.019	0.276	1.12	48.147	48.128	48.810	0.621			
99	98	JUNCTION PIT							0	8.80	69.646	0.600	1.000	0.600	116	24.73	300	450	165	70	1.035	0.398	0.027	0.30	0.008	0.008	0.166	0.041	0.279	1.12	48.230	48.189	49.140	0.902			
100	74	GRATED SIDE ENTRY PIT	0.561	0.042					6	5.00	86.000	0.042	0.561	0.024	6	8.50	180	300	72	8	1.020	0.139	0.000	5.00	0.002	0.002	0.003	0.000	0.057	0.61	47.788	47.787	48.350	0.561			
101	95	GRATED SIDE ENTRY PIT	0.561	0.072					10	5.00	86.000	0.072	0.561	0.040	10	8.50	180	300	72	13	1.020	0.139	0.001	5.00	0.005	0.005	0.010	0.001	0.074	0.71	48.108	48.108	48.444	0.331			
102	84	GRATED SIDE ENTRY PIT	0.561	0.067					9	5.00	86.000	0.067	0.561	0.037	9	11.80	19	300	224	4	3.167	0.062	0.001	5.00	0.004	0.004	0.009	0.001	0.041	1.54	47.893	47.892	48.460	0.563			
103	61	GRATED SIDE ENTRY PIT			0.708	0.138			23	5.76	82.727	0.406	0.656	0.286	61	65.74	230	375	116	53	1.047	1.046	0.016	1.70	0.027	0.027	0.122	0.080	0.194	1.06	47.617	47.537	48.236	0.593			
104	103	GRATED SIDE ENTRY PIT	0.561	0.052	0.708	0.031			12	5.58	83.516	0.288	0.630	0.169	39	11.53	230	375	116	34	1.047	0.183	0.006	1.90	0.012	0.012	0.050	0.006	0.150	0.95	47.649	47.643	48.064	0.403			
105	104	GRATED SIDE ENTRY PIT	0.561	0.030	0.708	0.094			20	5.00	86.000	0.124	0.673	0.083	20	47.80	99	300	97	20	1.379	0.578	0.004	5.00	0.020	0.020	0.042	0.020	0.092	1.08	47.681	47.661	48.303	0.601			
106	58	GRATED SIDE ENTRY PIT	0.561	0.055	0.708	0.149			33	5.00	86.000	0.204	0.668	0.136	33	51.20	300	600	355	9	1.254	0.680	0.001	5.00	0.003	0.003	0.003	0.001	0.123	0.78	47.254	47.253	47.802	0.344			
107	68	JUNCTION PIT			0.708	0.258			44	5.00	86.000	0.258	0.708	0.182	44	76.50	142	300	81	54	1.147	1.112	0.019	5.00	0.097	0.097	0.203	0.155	0.157	1.17	47.575	47.420	48.058	0.384			
108	61	GRATED SIDE ENTRY PIT	0.561	0.053					7	5.00	86.000	0.053	0.561	0.030	7	8.50	12	300	275	3	3.896	0.036	0.001	5.00	0.003	0.003	0.005	0.000	0.033	1.66	47.537	47.537	48.232	0.693			
109	104	GRATED SIDE ENTRY PIT	0.561	0.061					8	5.00	86.000	0.061	0.561	0.034	8	8.50	100	300	97	8	1.369	0.104	0.001	5.00	0.003	0.003	0.007	0.001	0.059	0.83	47.662	47.661	48.064	0.399			
110	8	GRATED ENTRY PIT	0.561	0.029					4	6.11	81.229	0.475	0.672	0.319	72	9.24	50	450	403	18	2.536	0.061	0.010	0.90	0.009	0.009	0.064	0.006	0.129	1.92	46.899	46.893	48.143	1.235			
111	110	GRATED ENTRY PIT	0.561	0.086	0.708	0.058			21	5.92	82.048	0.446	0.680	0.303	69	27.40	56	450	381	18	2.398	0.190	0.010	1.60	0.015	0.015	0.059	0.016	0.130	1.82	46.924	46.908	48.280	1.340			
112	111	JUNCTION PIT			0.708	0.038			6	5.00	86.000	0.038	0.708	0.027	6	13.00	12	375	513	1	4.647	0.047	0.000	5.00	0.001	0.001	0.001	0.000	0.029	1.59	46.940	46.940	48.304	1.364			
113	111	JUNCTION PIT			0.708	0.207			35	5.00	86.000	0.264	0.708	0.187	45	79.95	120	375	160	28	1.450	0.919	0.008	1.50	0.012	0.012	0.065	0.052	0.135	1.24	46.992	46.940	48.044	1.040			
114	113	JUNCTION PIT			0.708	0.061			10	5.00	86.000	0.061	0.708	0.043	10	25.00	230	375	116	9	1.047	0.398	0.000	5.00	0.002	0.002	0.004	0.001	0.076	0.65	47.005	47.004	47.917	0.910			
115	93	JUNCTION PIT			0.708	0.033			6	5.00	86.000	0.033	0.708	0.023	6	11.00	64	300	121	5	1.709	0.107	0.000	3.62	0.001	0.001	0.003	0.000	0.044	0.87	47.216	47.216	48.243	1.025			
152	3	JUNCTION PIT							0	7.95	73.299	1.075	0.652	0.701	143	8.50	100	450	285	50	1.793	0.079	0.041	1.90	0.078	0.078	0.250	0.021	0.225	1.79	46.599	46.578	47.624	0.947			
153	152	GRATED SIDE ENTRY PIT	0.561	0.071					10	7.90	73.546	0.956	0.645	0.617	126	9.05	37	375	290	43	2.624	0.057</															

PLAN OF SUBDIVISION		EDITION 1	PS923410J	
LOCATION OF LAND PARISH: TARNEIT TOWNSHIP: - SECTION: 22 CROWN ALLOTMENT: - CROWN PORTION: F (Part) TITLE REFERENCE: C/T VOL FOL LAST PLAN REFERENCE: LOT P ON PS918479Y POSTAL ADDRESS: 860 DERRIMUT ROAD, (at time of subdivision) TARNEIT, VIC 3029 MGA2020 CO-ORDINATES: E: 298 040 ZONE: 55 (of approx centre of land in plan) N: 5 812 710		Council Name: Wyndham City Council SPEAR Reference Number: S237788S		
VESTING OF ROADS AND/OR RESERVES		NOTATIONS		
IDENTIFIER	COUNCIL / BODY / PERSON	Land being subdivided is enclosed within thick continuous lines Lots 1 to 700, and A to Q (all inclusive) have been omitted from this plan. <u>OTHER PURPOSE OF THIS PLAN</u> To remove by agreement that part of Sewerage and Drainage Easement E-3 created on PS918479Y now contained in roads on this plan via section 6(1)(k)(iv) of the Subdivision Act 1988. To remove by agreement drainage Easements E-4 & E-5 created in PS912514H on this plan via section 6 (1) (k) (iv) of the Subdivision Act 1988.		
ROAD R-1	WYNDHAM CITY COUNCIL			
RESERVE No.1	POWERCOR AUSTRALIA LIMITED			
RESERVE Nos. 2 & 3	WYNDHAM CITY COUNCIL			
NOTATIONS				
DEPTH LIMITATION : DOES NOT APPLY				
SURVEY: This plan is based on survey (PS901682W) STAGING: This is not a staged subdivision Planning Permit No. WYP 13902/22 This survey has been connected to permanent marks No(s).PM158 & PM 159 In Proclaimed Survey Area No. -				
EASEMENT INFORMATION				
LEGEND: A - Appurtenant Easement E - Encumbering Easement R - Encumbering Easement (Road)				
Easement Reference	Purpose	Width (Metres)	Origin	Land Benefited / In Favour of
SEE SHEET 2 FOR EASEMENT INFORMATION				
HARLOW ESTATE - STAGE 7 (83 LOTS)			AREA OF STAGE - 6.221ha	
414 La Trobe Street PO Box 16084 Melbourne Vic 8007 T 61 3 9993 7888 spiire.com.au		SURVEYORS FILE REF: 309443SV00		ORIGINAL SHEET SIZE: A3
		Digitally signed by: Brent O'Grady, Licensed Surveyor, Surveyor's Plan Version (7), 22/12/2025, SPEAR Ref: S237788S		SHEET 1 OF 10

EASEMENT INFORMATION

LEGEND: A - Appurtenant Easement E - Encumbering Easement R - Encumbering Easement (Road)

Easement Reference	Purpose	Width (Metres)	Origin	Land Benefited / In Favour of
E-1, E-9, E-11	SEWERAGE	3	PS901682W	GREATER WESTERN WATER CORPORATION
E-2, E-5	SEWERAGE	SEE DIAGRAM	THIS PLAN	GREATER WESTERN WATER CORPORATION
E-2, E-4, E-6	DRAINAGE	SEE DIAGRAM	THIS PLAN	WYNDHAM CITY COUNCIL
E-3, E-12, E-14, E-15	SEWERAGE	SEE DIAGRAM	PS918479Y	GREATER WESTERN WATER CORPORATION
E-3, E-12, E-14, E-15	DRAINAGE	SEE DIAGRAM	PS918479Y	WYNDHAM CITY COUNCIL
E-8, E-9, E-10, E-11, E-12, E-13	CARRIAGEWAY	SEE DIAGRAM	PS928255R	WYNDHAM CITY COUNCIL
E-10, E-11	DRAINAGE	SEE DIAGRAM	PS928255R	WYNDHAM CITY COUNCIL
E-2, E-5, E-6, E-14	GAS DISTRIBUTION PIPELINE (THROUGH UNDERGROUND PIPES)	SEE DIAGRAM	THIS PLAN	AUSNET GAS SERVICES PTY LTD
E-2, E-5, E-6, E-14	SUPPLY OF WATER (THROUGH UNDERGROUND PIPES & ABOVE GROUND FITTINGS)	SEE DIAGRAM	THIS PLAN	GREATER WESTERN WATER CORPORATION
E-15	POWERLINE	4	THIS PLAN - SECTION 88 OF THE ELECTRICITY INDUSTRY ACT 2000	POWERCOR AUSTRALIA LTD
E-16	SEWERAGE	SEE DIAGRAM	PS909597T	GREATER WESTERN WATER CORPORATION
E-16, E-17	CREATION AND MAINTENANCE OF WETLANDS, FLOODWAY AND DRAINAGE AS SPECIFIED AND SET OUT IN MEMORANDUM OF COMMON PROVISIONS No.AA2741	SEE DIAGRAM	THIS PLAN	MELBOURNE WATER CORPORATION
E-18	PARTY WALL	0.125	THIS PLAN	RELEVANT ABUTTING LOT IN THIS PLAN
E-19	POWERLINE	SEE DIAGRAM	THIS PLAN - SECTION 88 OF THE ELECTRICITY INDUSTRY ACT 2000	POWERCOR AUSTRALIA LTD

SURVEYOR'S FILE REF: 309443SV00



ORIGINAL SHEET
SIZE: A3

SHEET 2



414 La Trobe Street
PO Box 16084
Melbourne Vic 8007
T 61 3 9993 7888
spiire.com.au

Digitally signed by: Brent O'Grady, Licensed Surveyor,
Surveyor's Plan Version (7),
22/12/2025, SPEAR Ref: S237788S

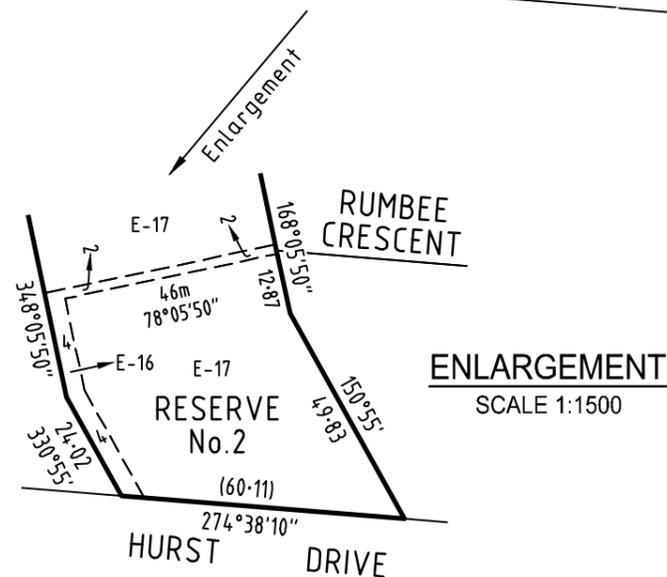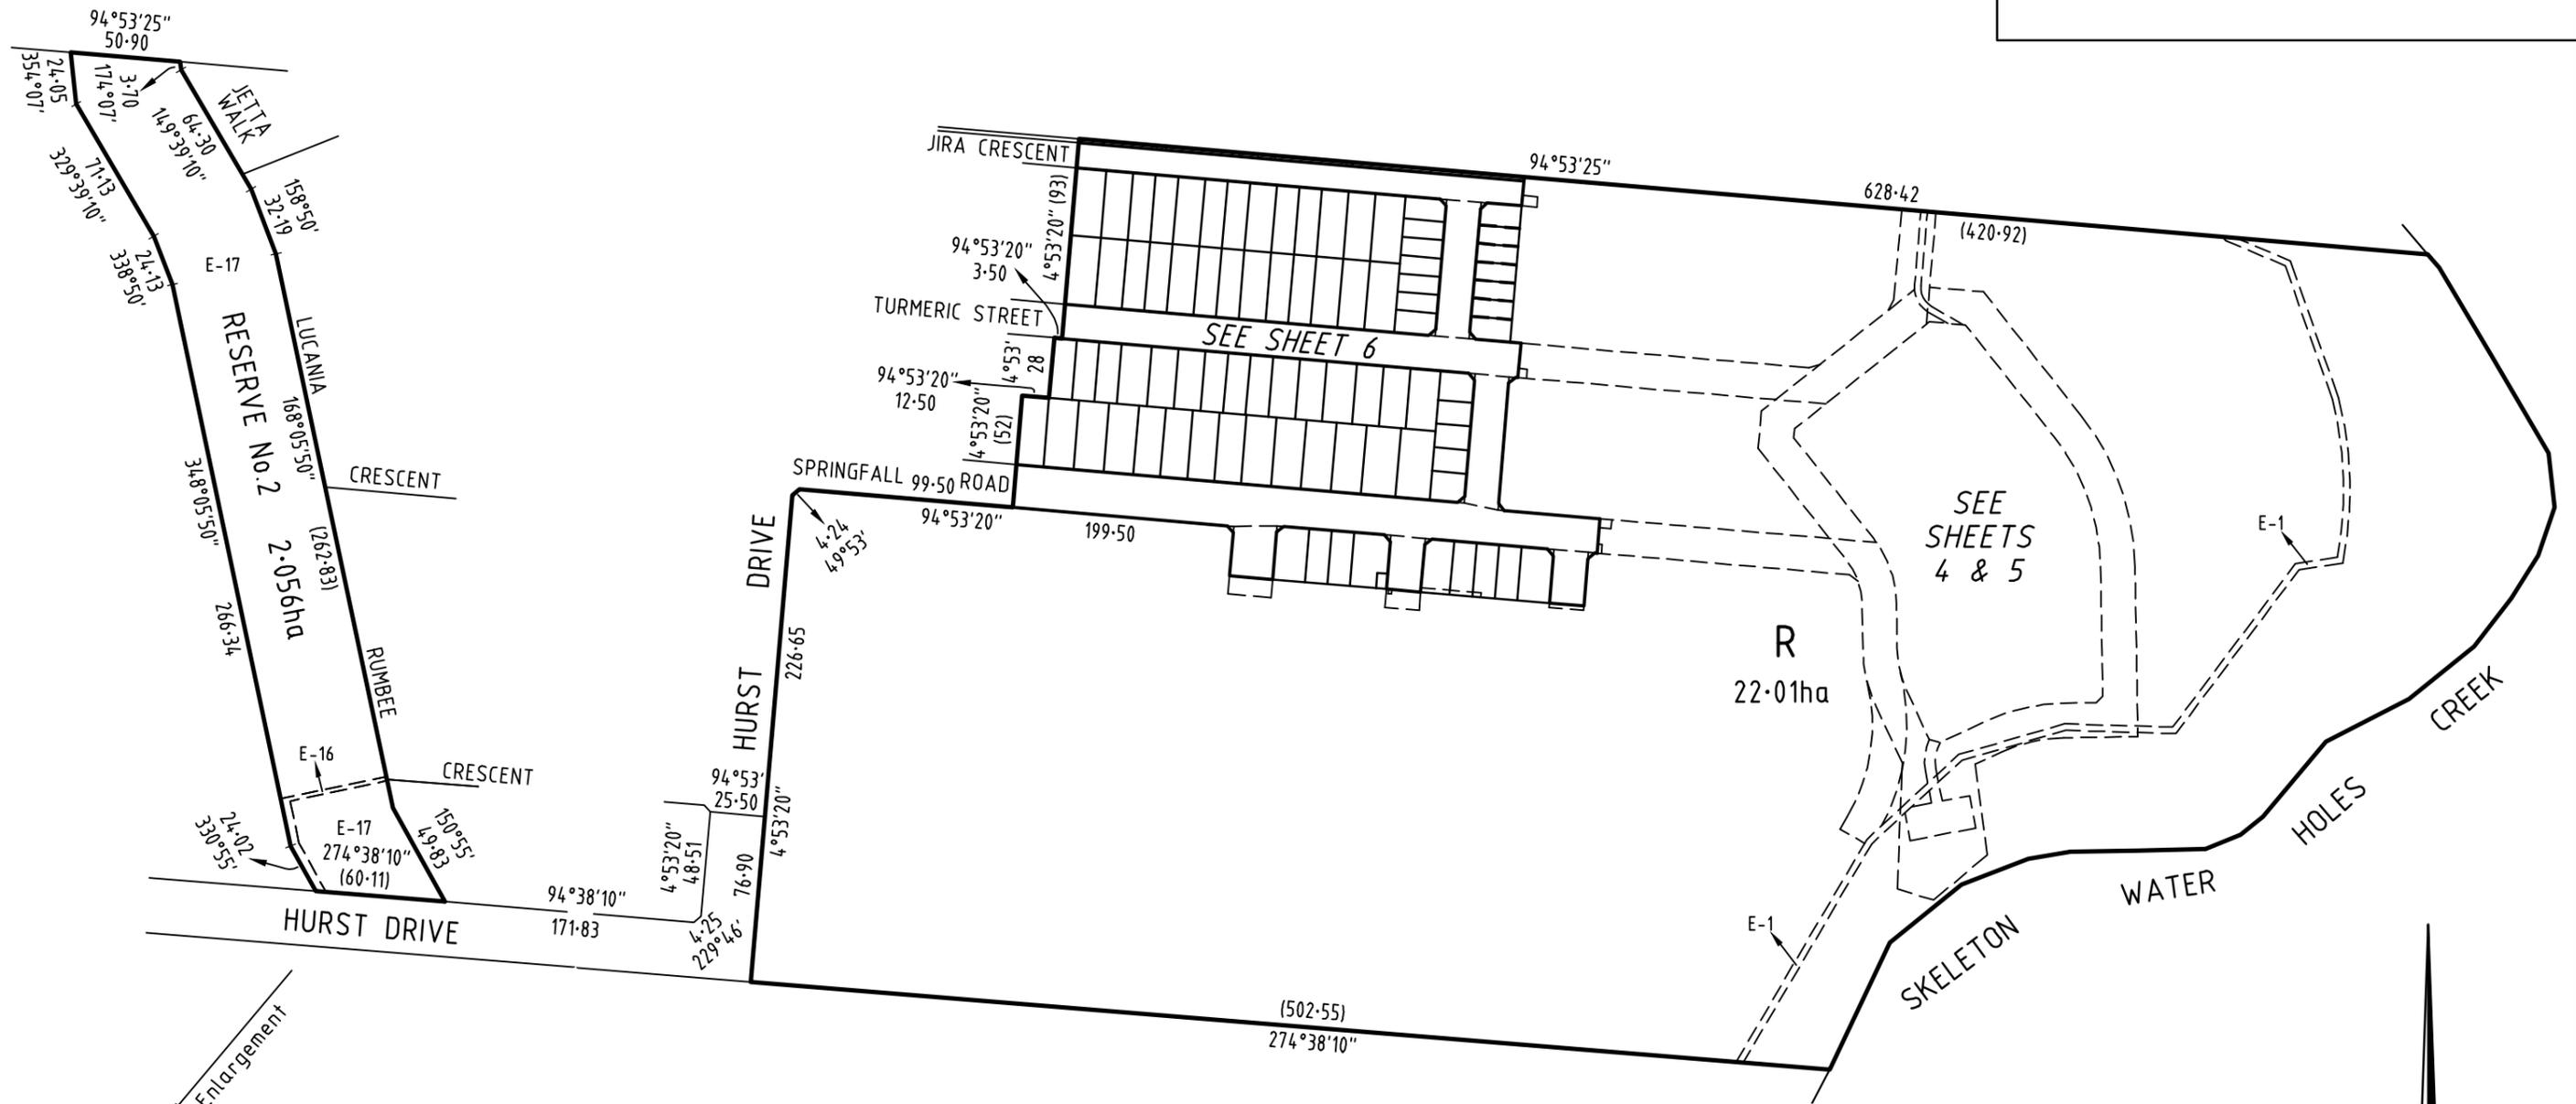

SURVEYOR'S FILE REF: 309443SV00

spiire
414 La Trobe Street
PO Box 16084
Melbourne Vic 8007
T 61 3 9993 7888
spiire.com.au

Digitally signed by: Brent O'Grady, Licensed Surveyor,
Surveyor's Plan Version (7),
22/12/2025, SPEAR Ref: S237788S


SCALE 1: 3000

30 0 30 60 90 120
LENGTHS ARE IN METRES

ORIGINAL SHEET SIZE: A3

SHEET 3

MGA 2020
ZONE 55

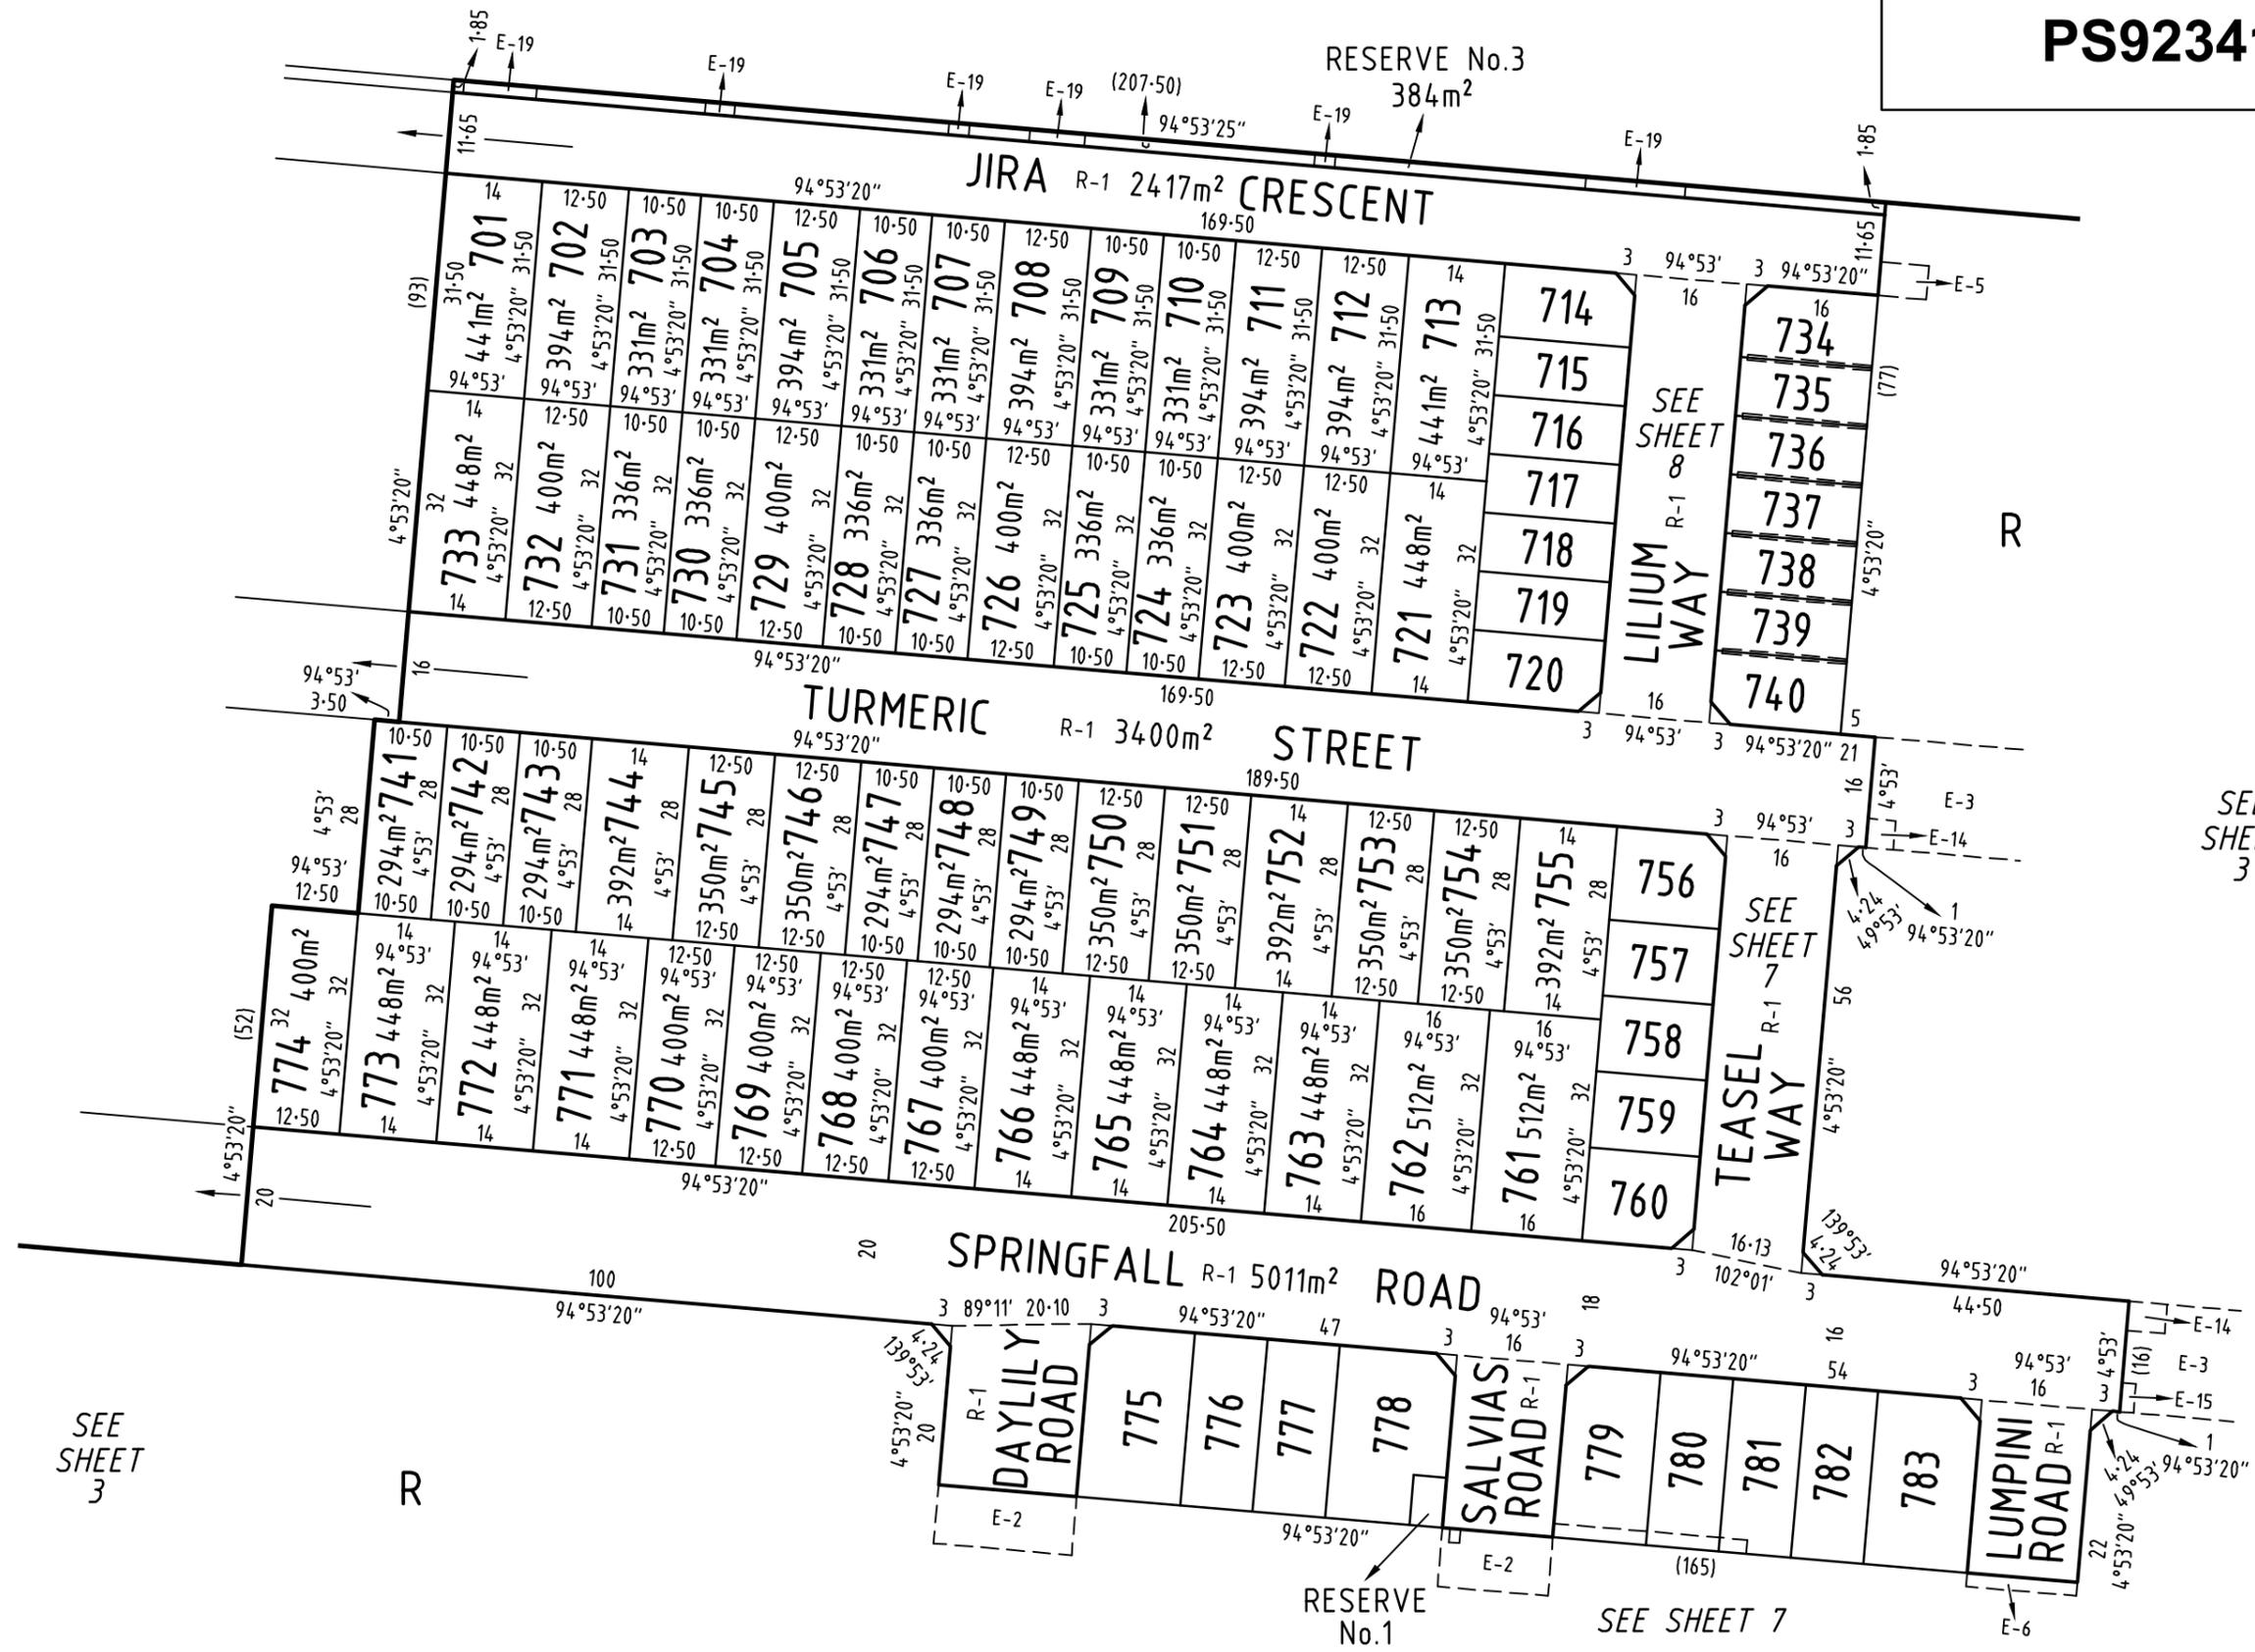

SEE SHEET 3

SEE SHEET 3

SEE SHEET 7

SURVEYOR'S FILE REF: 309443SV00



414 La Trobe Street
PO Box 16084
Melbourne Vic 8007
T 61 3 9993 7888
spiire.com.au


SCALE 1: 1000
10 0 10 20 30 40
LENGTHS ARE IN METRES

ORIGINAL SHEET SIZE: A3

SHEET 6

Digitally signed by: Brent O'Grady, Licensed Surveyor,
Surveyor's Plan Version (7),
22/12/2025, SPEAR Ref: S237788S


SEE SHEET 6

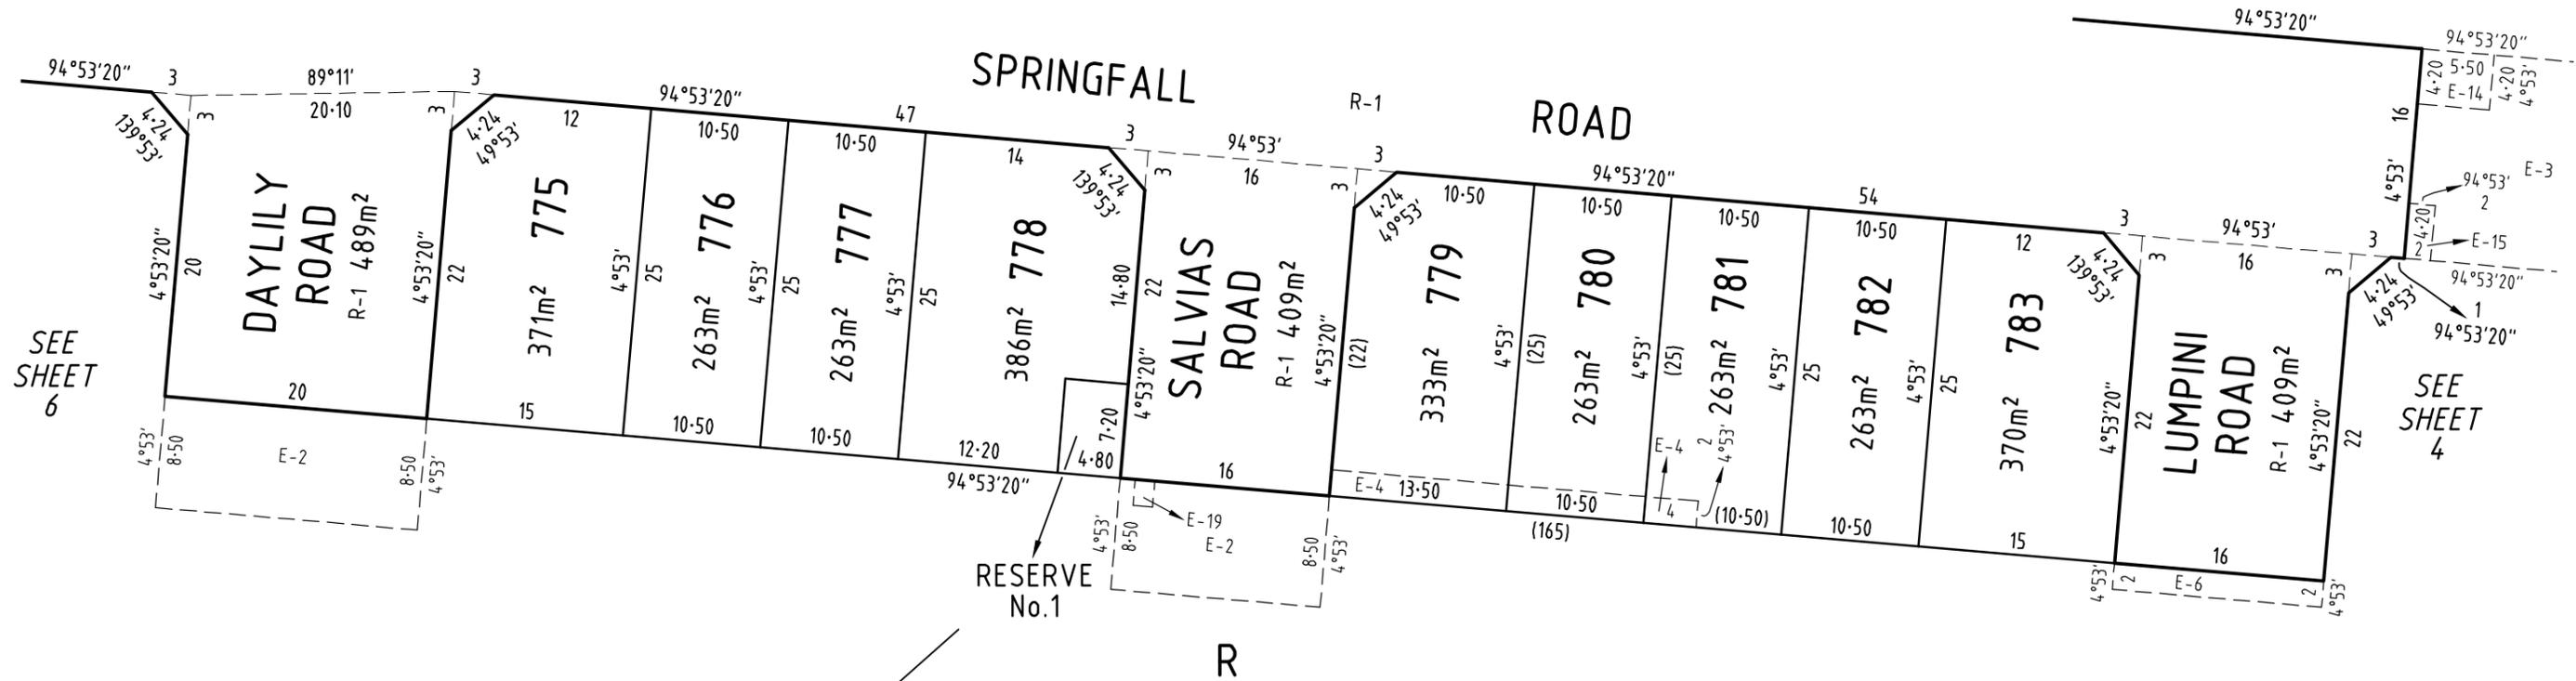

SEE SHEET 6

SEE SHEET 4

Enlargement

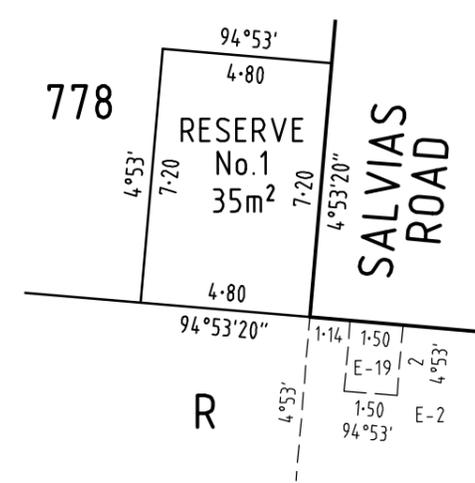



ENLARGEMENT
SCALE 1:200



<p>SURVEYOR'S FILE REF: 309443SV00</p>	<p>SCALE 1: 500</p> <p>LENGTHS ARE IN METRES</p>	<p>ORIGINAL SHEET SIZE: A3</p>	<p>SHEET 7</p>
<p>414 La Trobe Street PO Box 16084 Melbourne Vic 8007 T 61 3 9993 7888 spiire.com.au</p>	<p>Digitally signed by: Brent O'Grady, Licensed Surveyor, Surveyor's Plan Version (7), 22/12/2025, SPEAR Ref: S237788S</p>		


RESERVE No.3

ENLARGEMENT
SCALE 1:250

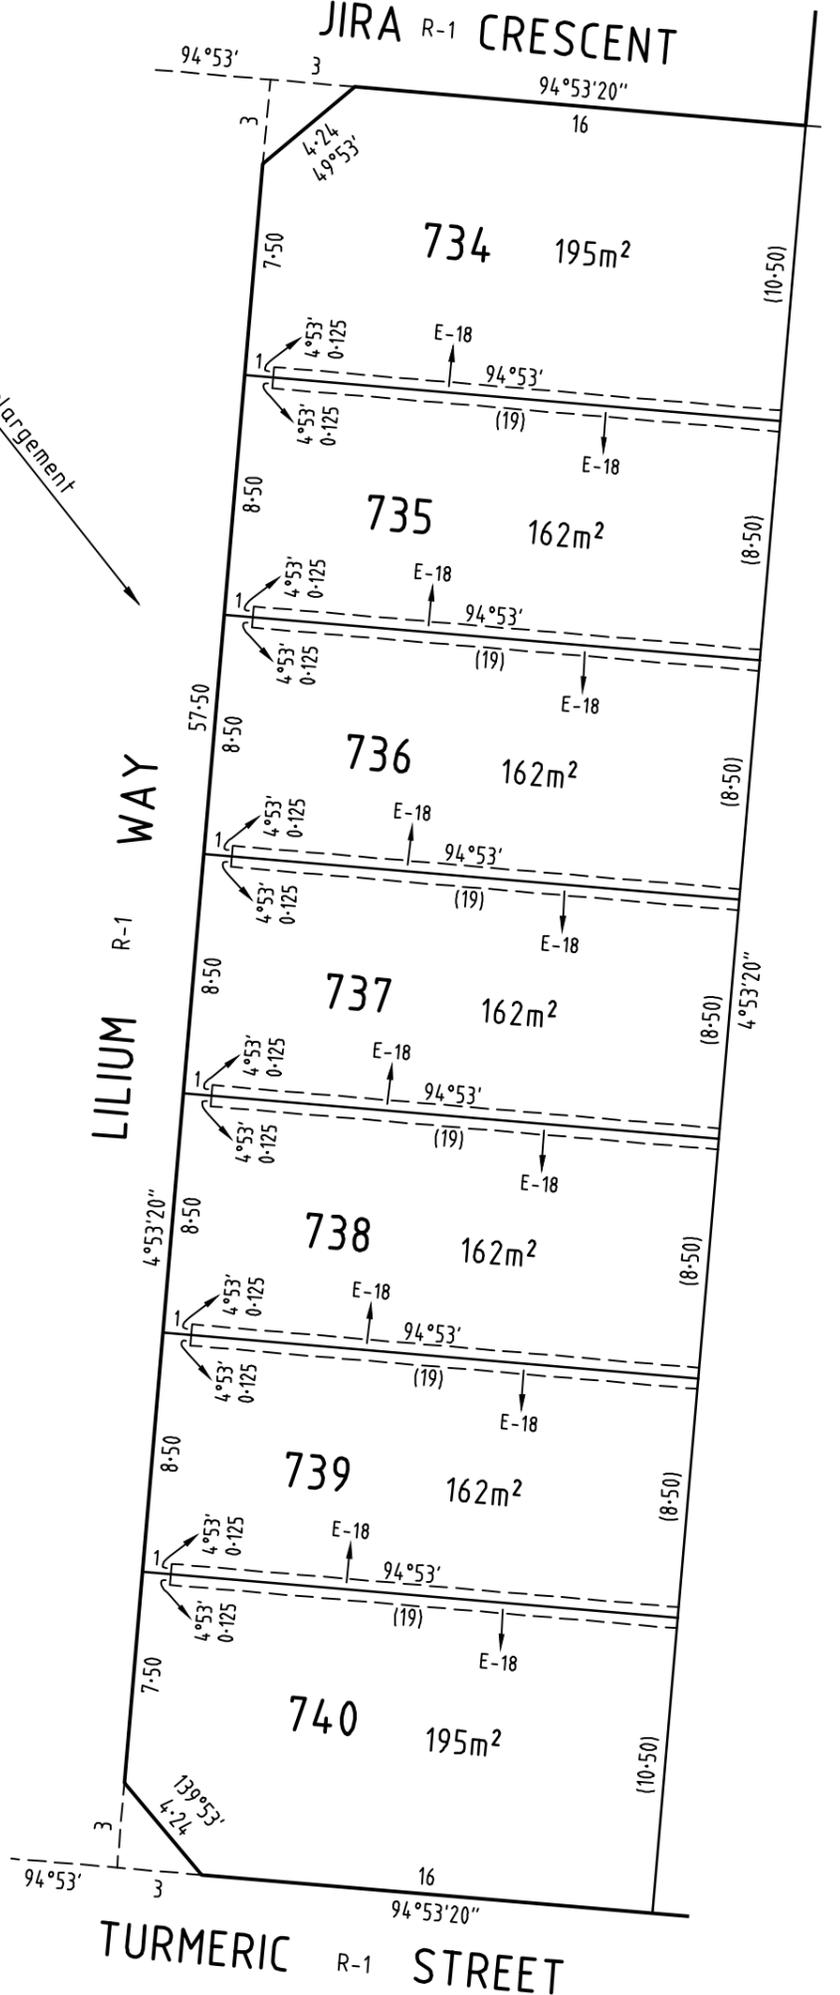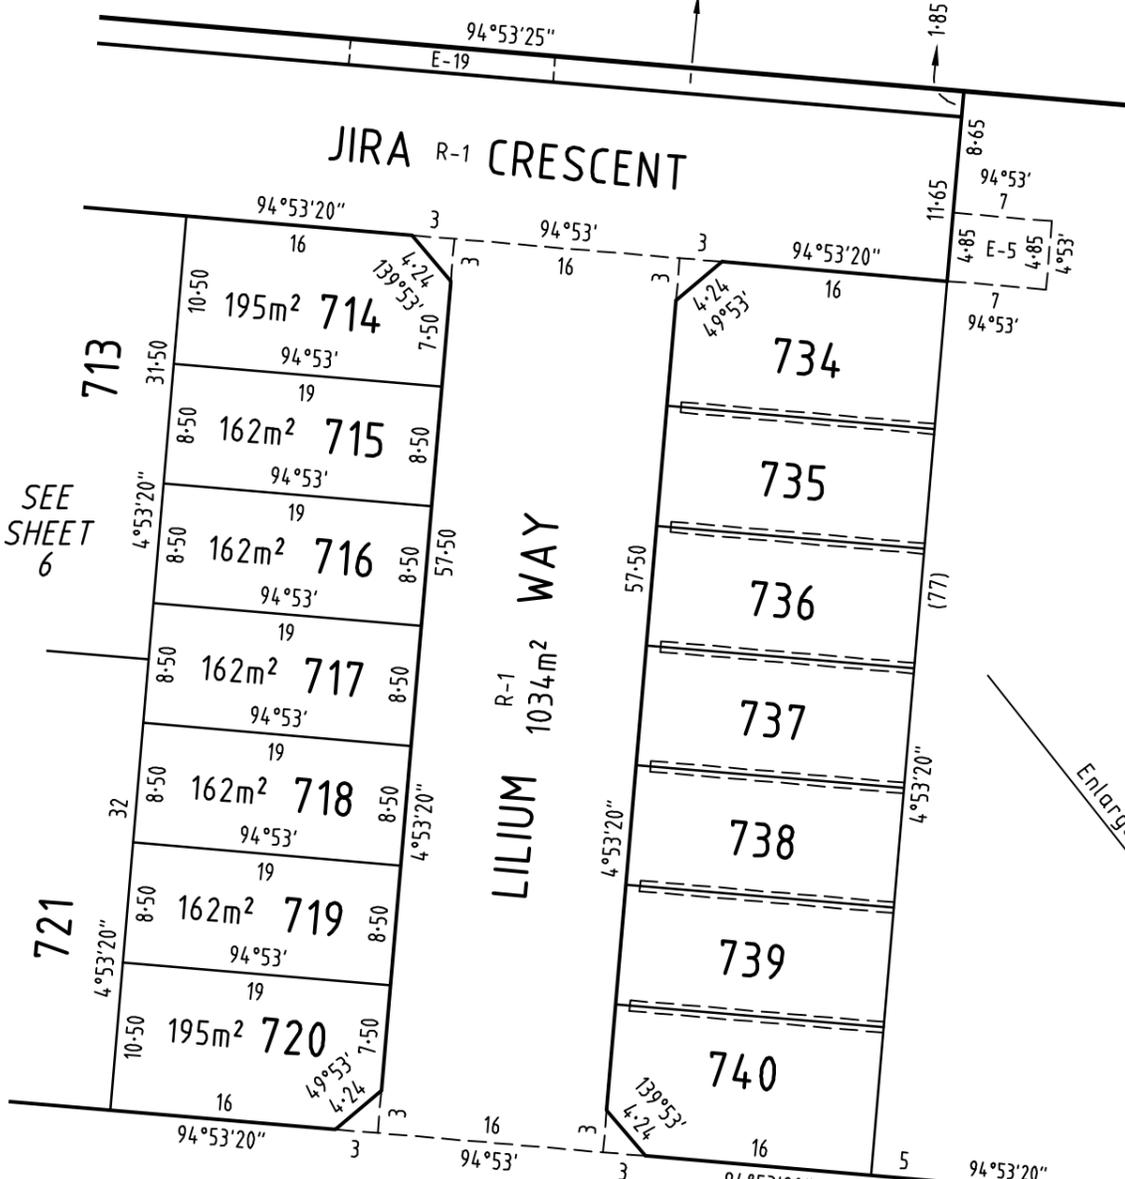

SURVEYOR'S FILE REF: 309443SV00

SCALE 1: 500

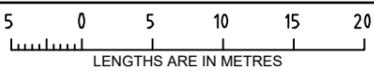


ORIGINAL SHEET SIZE: A3

SHEET 8




414 La Trobe Street
 PO Box 16084
 Melbourne Vic 8007
 T 61 3 9993 7888
 spiire.com.au


Digitally signed by: Brent O'Grady, Licensed Surveyor,
 Surveyor's Plan Version (7),
 22/12/2025, SPEAR Ref: S237788S

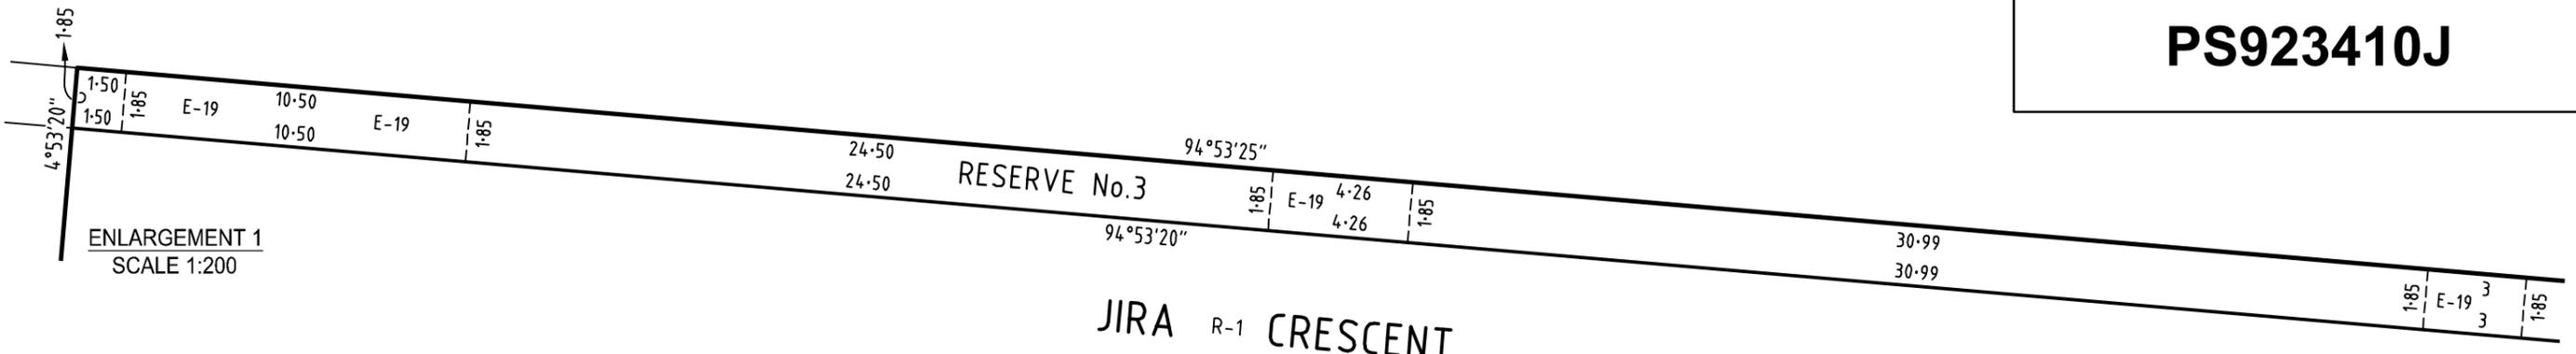


ENLARGEMENT 1
SCALE 1:200

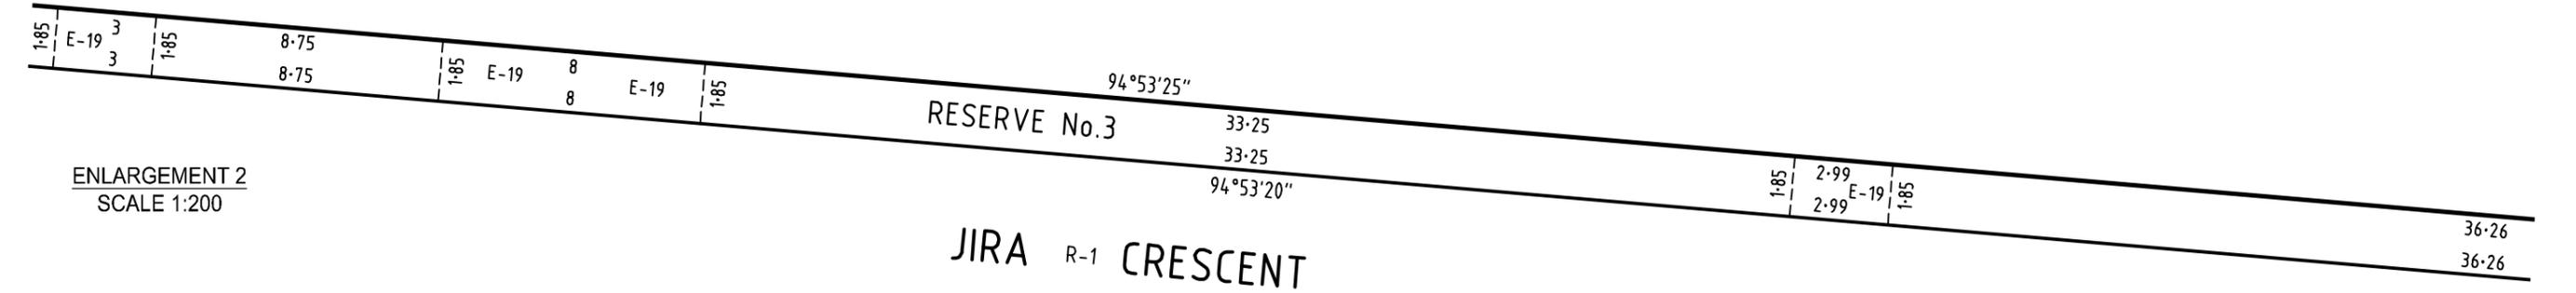

ENLARGEMENT 2
SCALE 1:200

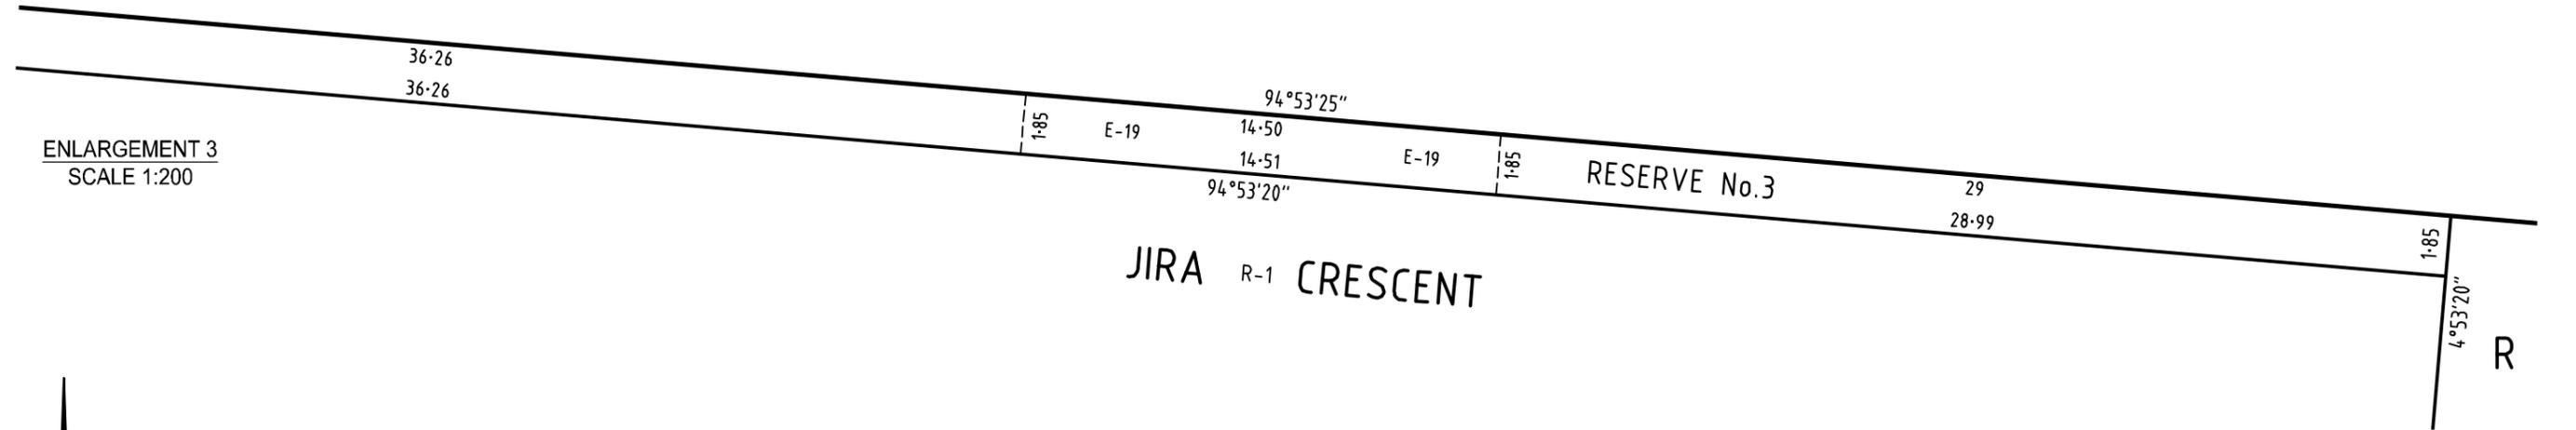

ENLARGEMENT 3
SCALE 1:200

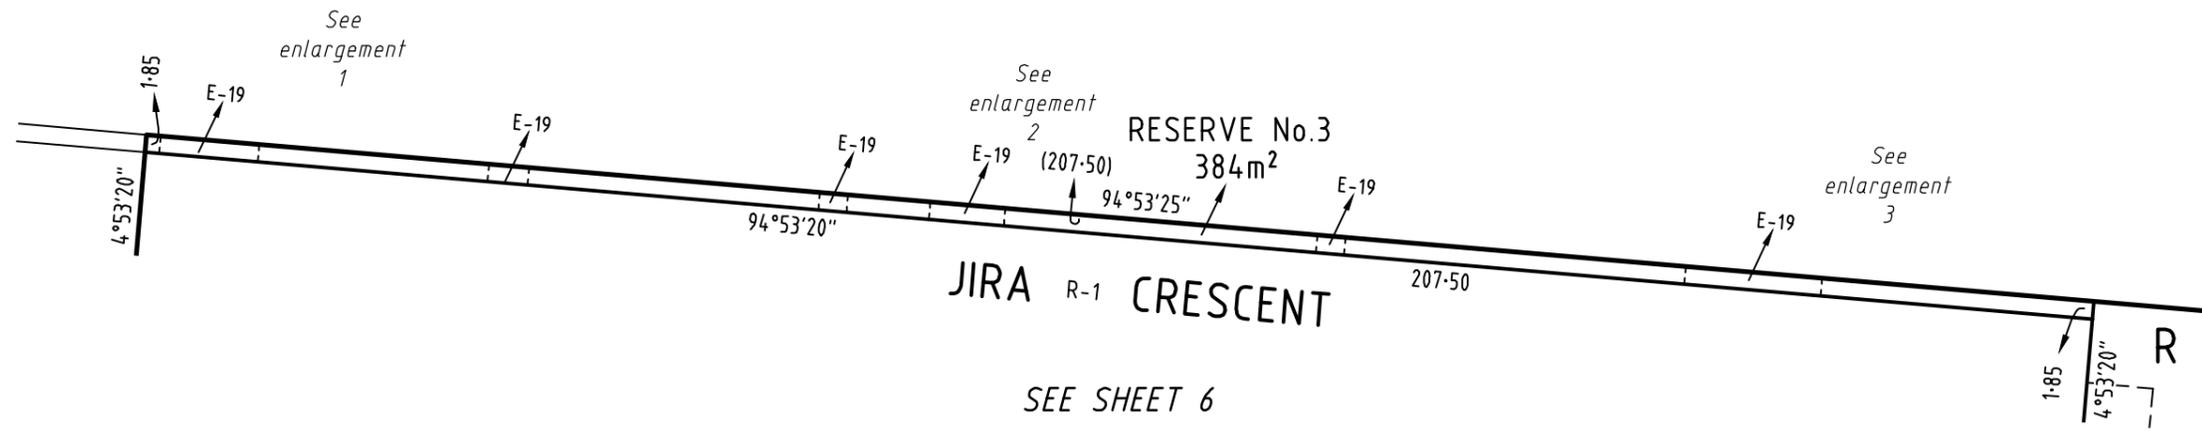

MGA 2020
ZONE 55

SEE SHEET 6

SURVEYOR'S FILE REF: 309443SV00



414 La Trobe Street
PO Box 16084
Melbourne Vic 8007
T 61 3 9993 7888
spiire.com.au

SCALE 1: 750
7.5 0 7.5 15 22.5 30
LENGTHS ARE IN METRES

Digitally signed by: Brent O'Grady, Licensed Surveyor,
Surveyor's Plan Version (7),
22/12/2025, SPEAR Ref: S237788S

ORIGINAL SHEET
SIZE: A3

SHEET 9

CREATION OF RESTRICTION

PS923410J

The registered proprietors of the burdened land covenant with the registered proprietors of the benefited land as set out in the restriction with the intent that the burden of the restriction runs with and binds the burdened land and the benefit of the restriction is annexed to and runs with the benefited land.

RESTRICTION No.1

TABLE OF LAND BURDENED AND LAND BENEFITED :

Burdened Lot No.	Benefited Lots	Burdened Lot No.	Benefited Lots	Burdened Lot No.	Benefited Lots
701	702, 733	726	708, 725, 727	762	753, 754, 761, 763
702	701, 703, 732	727	707, 726, 728	763	752, 753, 762, 764
703	702, 704, 731	728	706, 727, 729	764	751, 752, 763, 765
704	703, 705, 730	729	705, 728, 730	765	750, 751, 764, 766
705	704, 706, 729	730	704, 729, 731	766	749, 750, 765, 767
706	705, 707, 728	731	703, 730, 732	767	747, 748, 749, 766, 768
707	706, 708, 727	732	702, 731, 733	768	746, 747, 767, 769
708	707, 709, 726	733	701, 732	769	745, 746, 768, 770
709	708, 710, 725	744	743, 745, 770, 771	770	744, 745, 769, 771
710	709, 711, 724	745	744, 746, 769, 770	771	743, 744, 770, 772
711	710, 712, 723	746	745, 747, 768, 769	772	742, 743, 771, 773
712	711, 713, 722	750	749, 751, 765, 766	773	741, 742, 772, 774
713	712, 714, 715, 716, 717, 721	751	750, 752, 764, 765	774	741, 773
721	713, 717, 718, 719, 720, 722	752	751, 753, 763, 764	775	776
722	712, 721, 723	753	752, 754, 762, 763	778	777
723	711, 722, 724	754	753, 755, 761, 762	779	780
724	710, 723, 725	755	754, 756, 757, 758, 761	783	782
725	709, 724, 726	761	754, 755, 758, 759, 760, 762		

DESCRIPTION OF RESTRICTION

Except with the written consent of each and every registered proprietor of a benefiting Lot on the Plan of Subdivision the registered proprietor or proprietors for the time being of any burdened Lot on the Plan of Subdivision shall not:

Design Guidelines and MCP

- (a) build or allow to be built on the Lot any building other than a building which has been constructed in accordance with the endorsed Memorandum of Common Provisions (MCP) registered in Dealing Number, which MCP is incorporated into this Restriction.
- (b) build a building or structure unless it complies with the Harlow Estate Design Guidelines
- (c) build or allow to be built on the lot any building other than a building that has received approval of all plans and specifications by the Harlow Design & Assessment Panel via the Design approval panel at www.harlowtarneit.com.au prior to the issue of a building permit.

Expiry

- (1) 31/12/2035

RESTRICTION No. 2

The following restriction is to be created upon registration of this plan:

TABLE OF LAND BURDENED AND LAND BENEFITED :

Burdened Lot No.	Benefited Lots	Burdened Lot No.	Benefited Lots	Burdened Lot No.	Benefited Lots
714	713, 715	737	736, 738	756	755, 757
715	713, 714, 716	738	737, 739	757	755, 756, 758
716	713, 715, 717	739	738, 740	758	755, 757, 759, 761
717	713, 716, 718, 721	740	739	759	758, 760, 761
718	717, 719, 721	741	742, 773, 774	760	759, 761
719	718, 720, 721	742	741, 743, 772, 773	776	775, 777
720	719, 721	743	742, 744, 771, 772	777	776, 778
734	735	747	746, 748, 767, 768	780	779, 781
735	734, 736	748	747, 749, 767	781	780, 782
736	735, 737	749	748, 750, 766, 767	782	781, 783

Lots 714 to 720, 734 to 743, 747 to 749, 756 to 760, 776, 777, and 780 to 782 (all inclusive) are defined as Type A lots under the 'Small lot Housing Code'.

DESCRIPTION OF RESTRICTION

For the purposes of this Restriction:

Small Lot Housing Code means the Small Lot Housing Code (Victorian Planning Authority, November 2019).

Except with the written consent of each and every registered proprietor of a benefiting lot on the Plan of Subdivision the registered proprietor or proprietors for the time being of any burdened Lot on the Plan of Subdivision in the table as a lot subject to the 'Small Lot Housing Code' shall not:

Small Lot Housing Code

- (a) build or allow to be built or remain on the lot any remaining building or structure that has not been constructed in accordance with the 'Small Lot Building Code' unless in an accordance with a planning permit granted to construct a dwelling on the lot.
- (b) build a building or structure unless it complies with the Harlow Estate Design Guidelines.
- (c) build or allow to be built on the lot any building other than a building that has received approval of all plans and specifications by the Harlow Design & Assessment Panel via the Design approval panel at www.harlowtarneit.com.au prior to the issue of a building permit.

Expiry

- (1) 31/12/2035